

# PROFILE AND DECKS


N<sup>o</sup> 178

SCALE 1/8" = ONE FOOT

DIMS. 250'0" x 35'0" x 17'0" MHP

TO CLASS B.S.\*

21 APR 1920

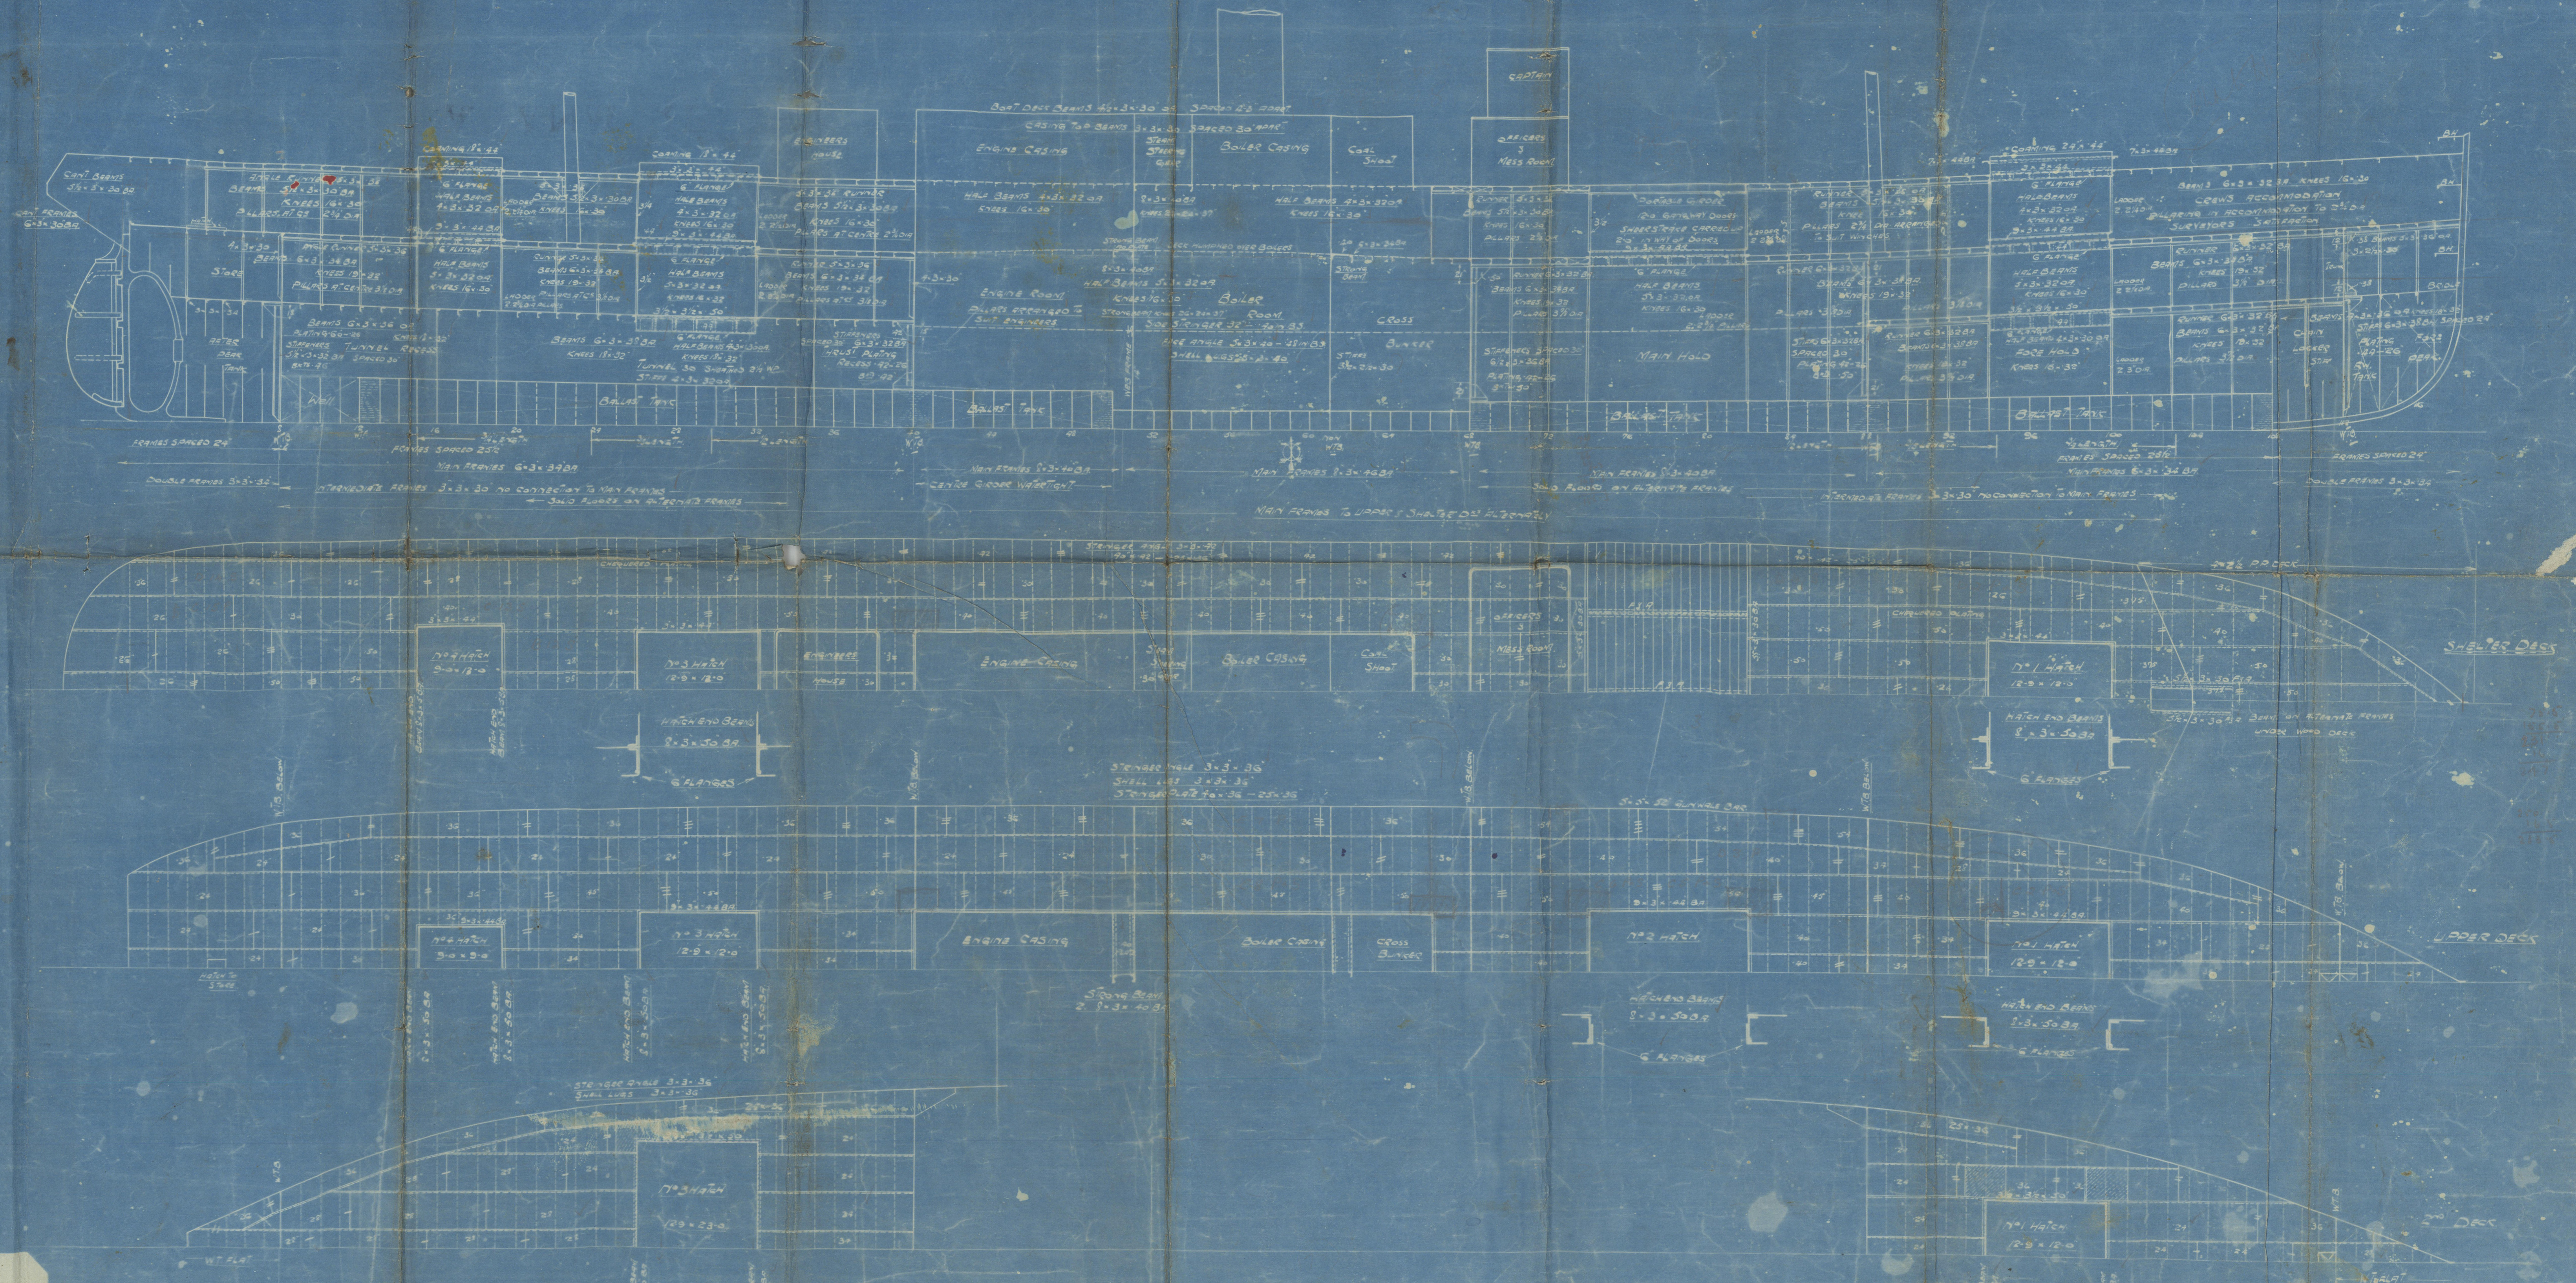

DRAWING NO. 178  
DATE 15-4-20  
TO: British Corporation

Drawing No D 178

Hawthorne 1/8.

Amended. Profile & decks.

RETAIN

SS

ARANMORE

Hawthorne & Co.

No 1/8

Profile & decks

Reference

8

21 4 20

002024-002037-0140



© 2020

Lloyd's Register  
Foundation