



1913 B
12/14

PROFILE & DECK PLAN.

STEEL SCREW STEAMER.

DIMENSIONS.—119'— x 23'6" x 9'3" M.L.D.

N^o 210.

TO LLOYD'S CLASS 100 A.1.



SCALE 1/2" = 1 FOOT.

PILLARING TO SURVEYORS SATISFACTION.

NO PILLARS IN HOLD.



19.12.13.

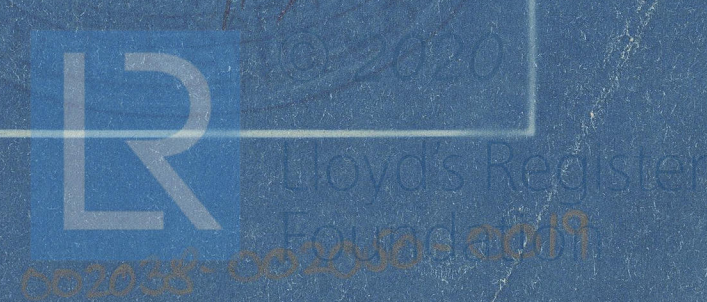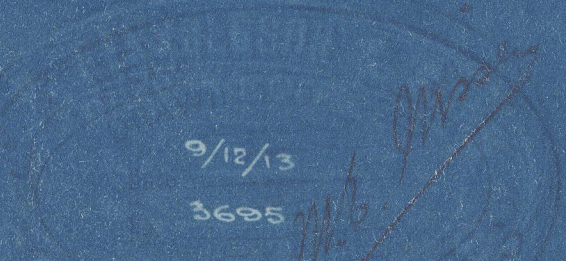

J. P. Kenneltonson Lons


Nº 290

Purple & dick Plaus

Sys. "abus" Rec. Rpt
Nº 66410



RETAIN

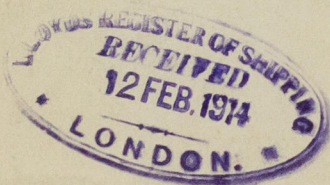

002038-002050-0019



© 2020

Lloyd's Register
Foundation