



MIDSHIP SECTION

NUMERALS

B + D = 32.62

L x (B + D) = 3881

19.12.13. d = 7.95

12.1.14. L/D = 12.8

EQUIPMENT

L x (B + D) = 3881

RQ DECK = 38.5 x 3 = 115.5

BRIDGE = 8.75 x 7.75 = 67.9

FELE = 24 x 7.75 = 186

1- 3/4" EX. STOCK STEAM ANCHOR

1- 3/4" KEDGE

1- 3/4" STUD LINK CABLE

45 2" STEEL FLEXIBLE WIRE

75 6" HEMP TOWLINE

90 4" MANILLA HAWSER

EQUIPMENT No. = 4151.9

2- 6" CWT. STOCKLESS ANCHORS

1- 3/4" EX. STOCK STEAM ANCHOR

1- 3/4" KEDGE

1- 3/4" STUD LINK CABLE

45 2" STEEL FLEXIBLE WIRE

75 6" HEMP TOWLINE

90 4" MANILLA HAWSER

STEEL SCREW STEAMER

N^o. 290.

DIMENSIONS - 119'-0" B.P. x 23'-6" EX. x 9'-3" MLD.

TO LLOYDS CLASS 100.A1.

SCALE 1/2" = 1 FOOT.

RIVETING



ITEM	Butts	Diagonal	Shoring
FRAMES TO SHELL PLATING	3/4"	5/8"	5/8"
" " FLOORS	5/8"	5/8"	5/8"
" " BOILER FLOORS	5/8"	5/8"	5/8"
BULKHEAD FRAMES	5/8"	5/8"	5/8"
REV. FRAMES TO FLOORS	5/8"	5/8"	5/8"
GUNWALE ANGLE TO DECK	5/8"	5/8"	5/8"
" " SHEERSTRAKE	5/8"	5/8"	5/8"
STRINGER PLATE TO BEAMS	5/8"	5/8"	5/8"
EDGES OF STRINGER PLATE	Single	5/8"	5/8"
BUTTS " "	Double	1"	5"
STEM & STERNPOST	Triple	3/4"	2 3/4"
BUTTLAPS OF KEEL PLATE	"	"	"
BUTTS OF SHEERSTRAKE FOR 1/2 LENGTH	"	"	"
" " " AT ENDS	Double	"	"
BUTTLAPS OF REMAINDER OF SHELL	"	"	"
EDGE LAPS OF SHEERSTRAKE & KEEL PLATE	"	"	3"
" " " REMAINDER OF SHELL	Single	"	3"

NOTE -

RIVETS TWO' FRAMES & OUTSIDE PLATING IN FLAT OF BOTTOM FOR 1/2 LENGTH & ALSO IN WAY OF AFT PEAK & BALLAST TANKS TO BE SPACED NOT MORE THAN 5 1/2 DIAMS. APART CR TO CR.

RIVETING


BUTTS OF KEEL PLATE OVERLAPPED & TREBLE RIVETED
ALL FORE & AFT. BUTTS OF SHEERSTRAKE STRAPPED &
TREBLE RIVETED FOR 1/2 LENGTH & DOUBLE RIVETED AT
ENDS. REMAINDER OF SHELL BUTTS OVERLAPPED &
DOUBLE RIVETED ALL FORE & AFT.
MAIN DECK STRINGER PLATE BUTTS OVERLAPPED & DOUBLE
RIVETED ALL FORE & AFT.
LANDING EDGES OF KEEL PLATE & LOWER EDGE OF SHEERSTRAKE
DOUBLE RIVETED. REMAINDER OF SHELL LANDING EDGES TO
BE SINGLE RIVETED.

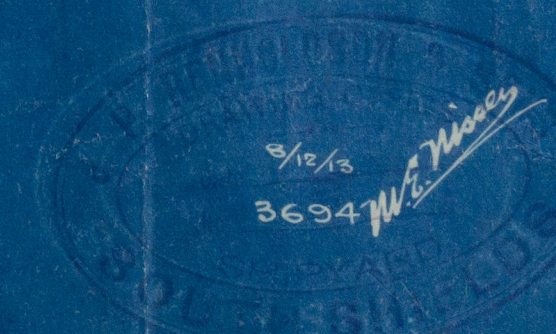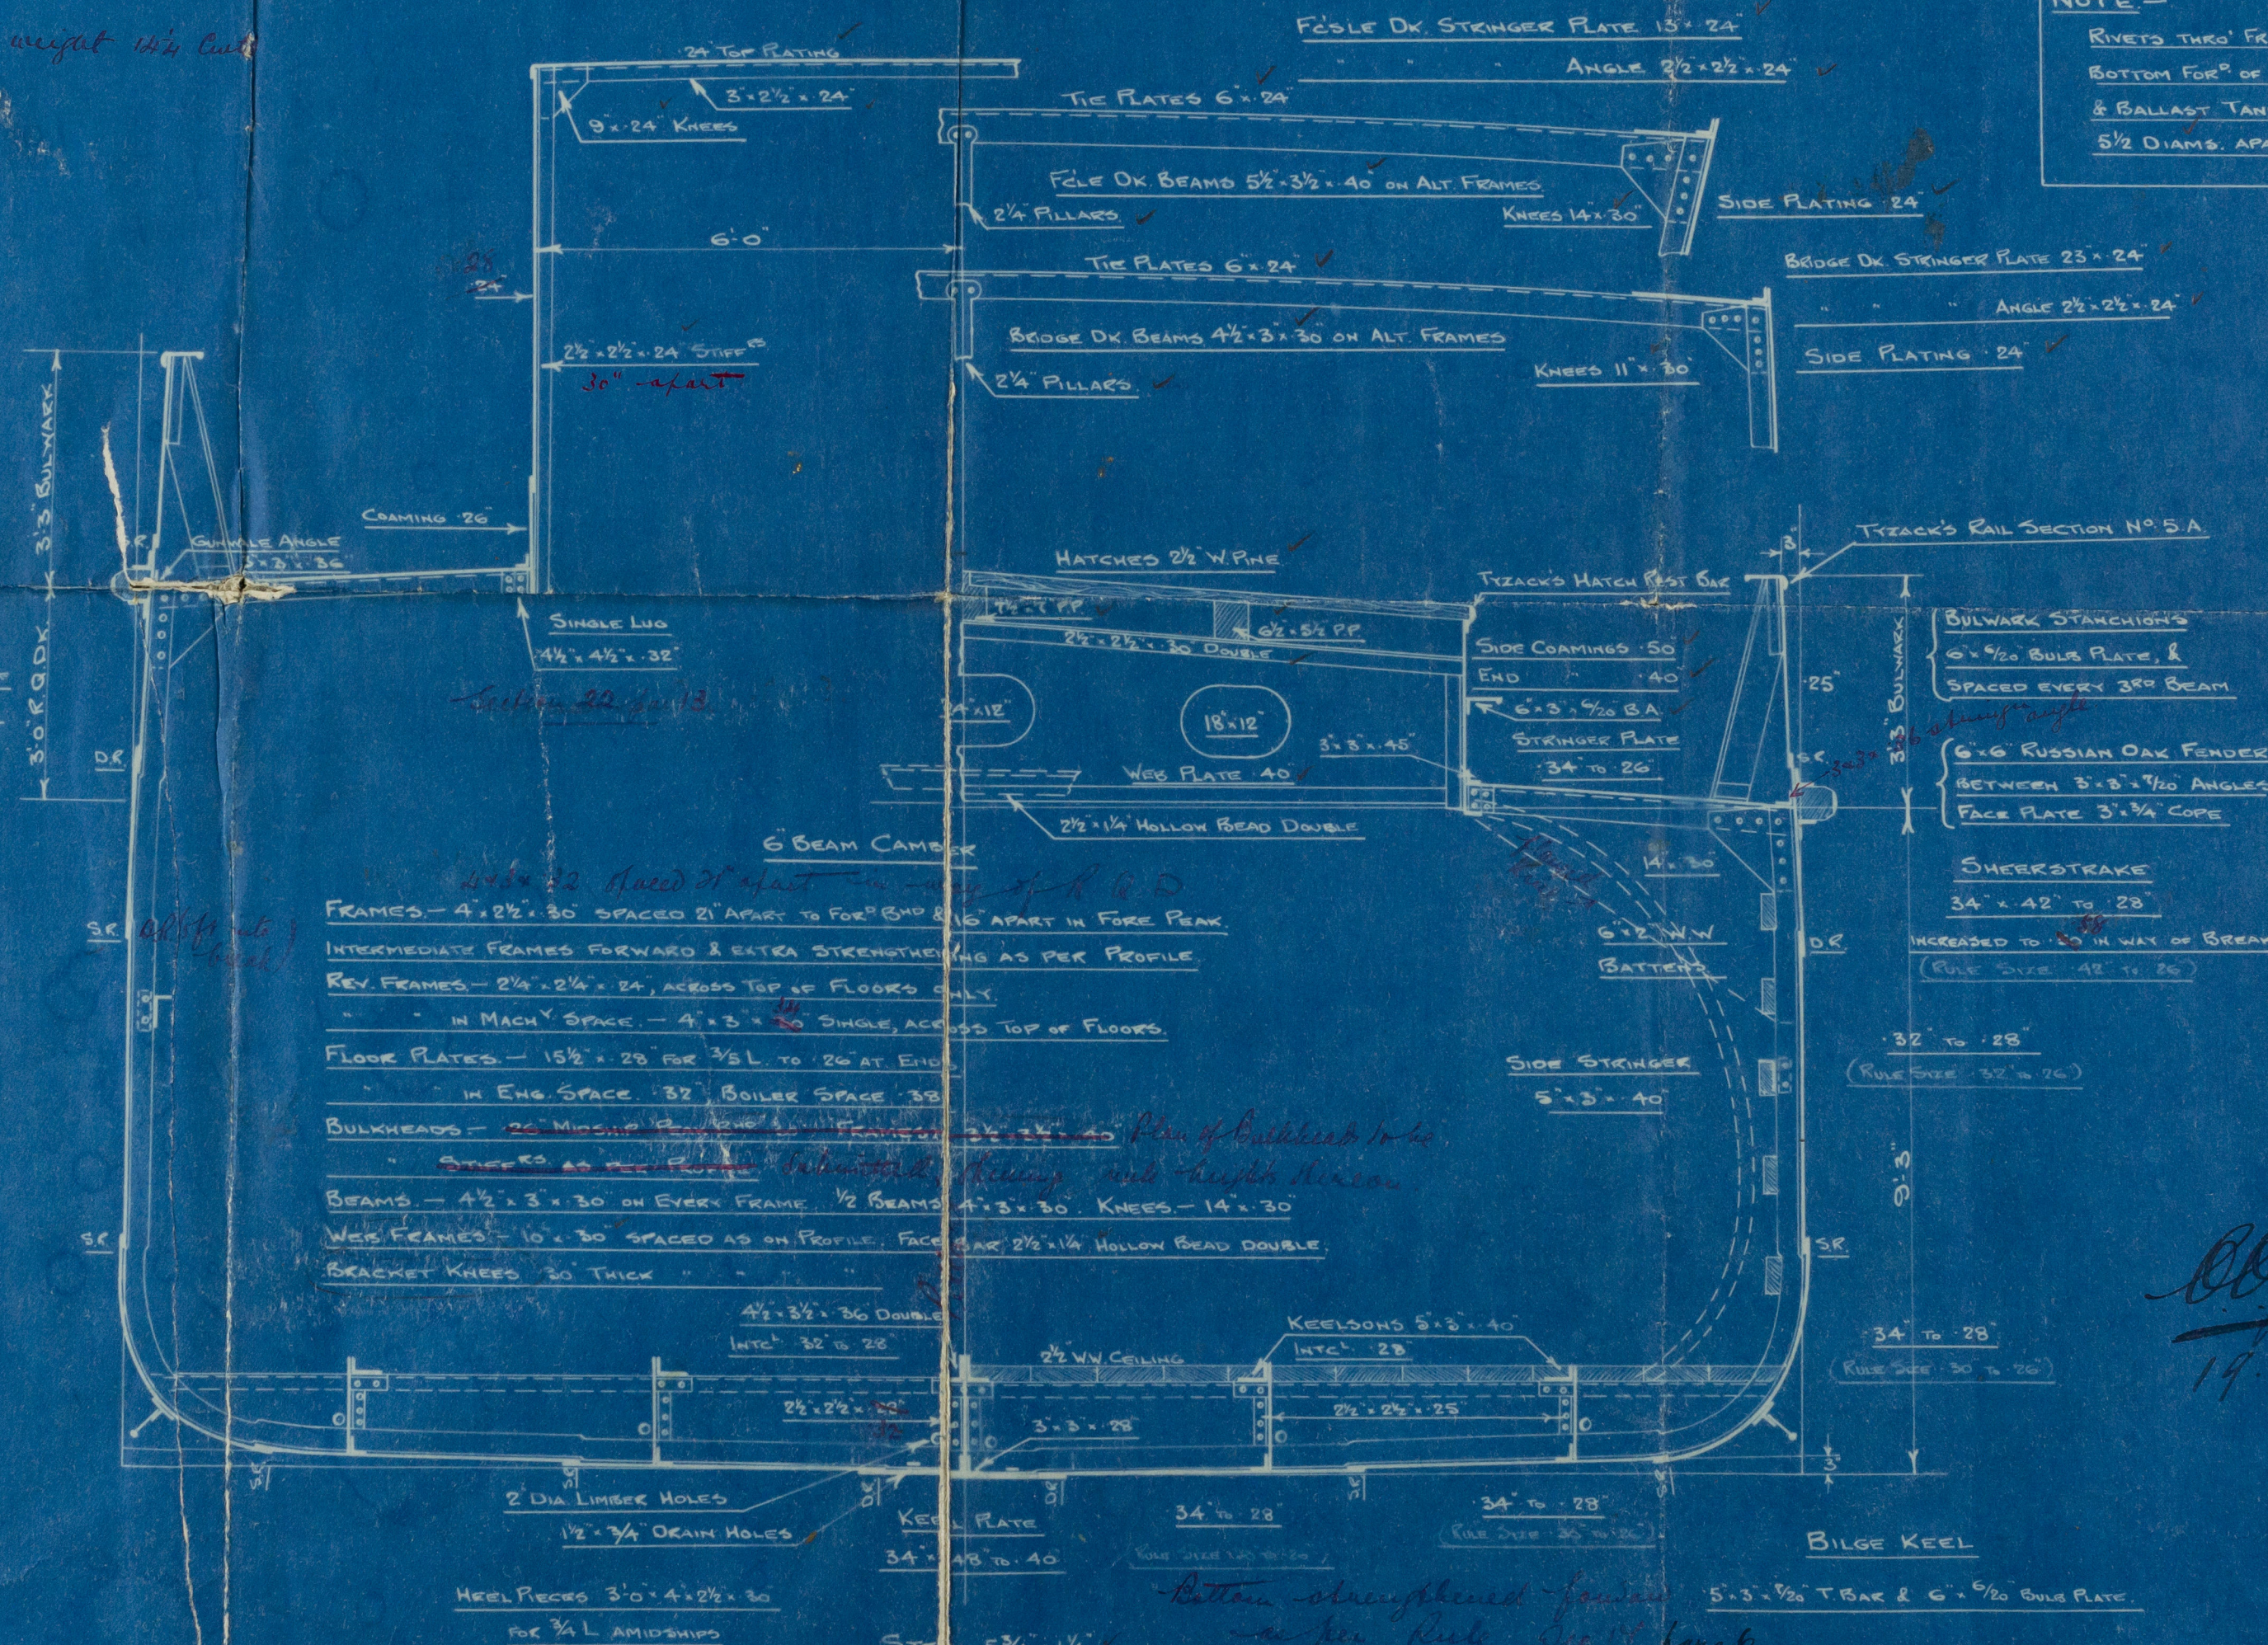

J. P. Remondhon & Co


Nº 290

Indus. Section

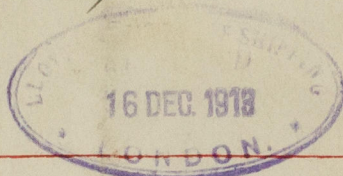

S/s. abus New Rpt-

Nº- 66410

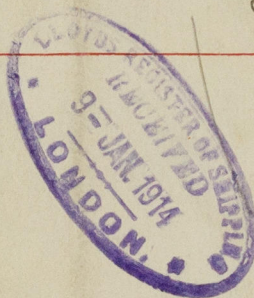

Cumbria

RETAIN

002038-002050-0020



© 2020

Lloyd's Register
Foundation