









450' OUTS. SS x 58' MLD x 29'-6 1/2" MLD UPPER DK

 

Nº 309.

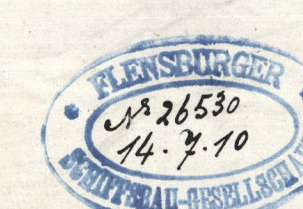

002038-002050-0025

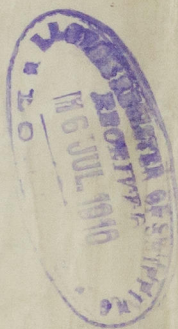

LONGITUDINAL & DECK Plans
FLENSBURG NO 309

HAMBURG LETTER

15.7.10

5.12.10

SS. Adelaide.



RETAIN



© 2020

Lloyd's Register
Foundation

002038-002050-0025