


Office

DIMENSIONS
 L.O.A 135'-10"
 L.B.P 129'-1"
 M.L.O.B 22'-11 1/2"
 M.L.O.D 9'-9"

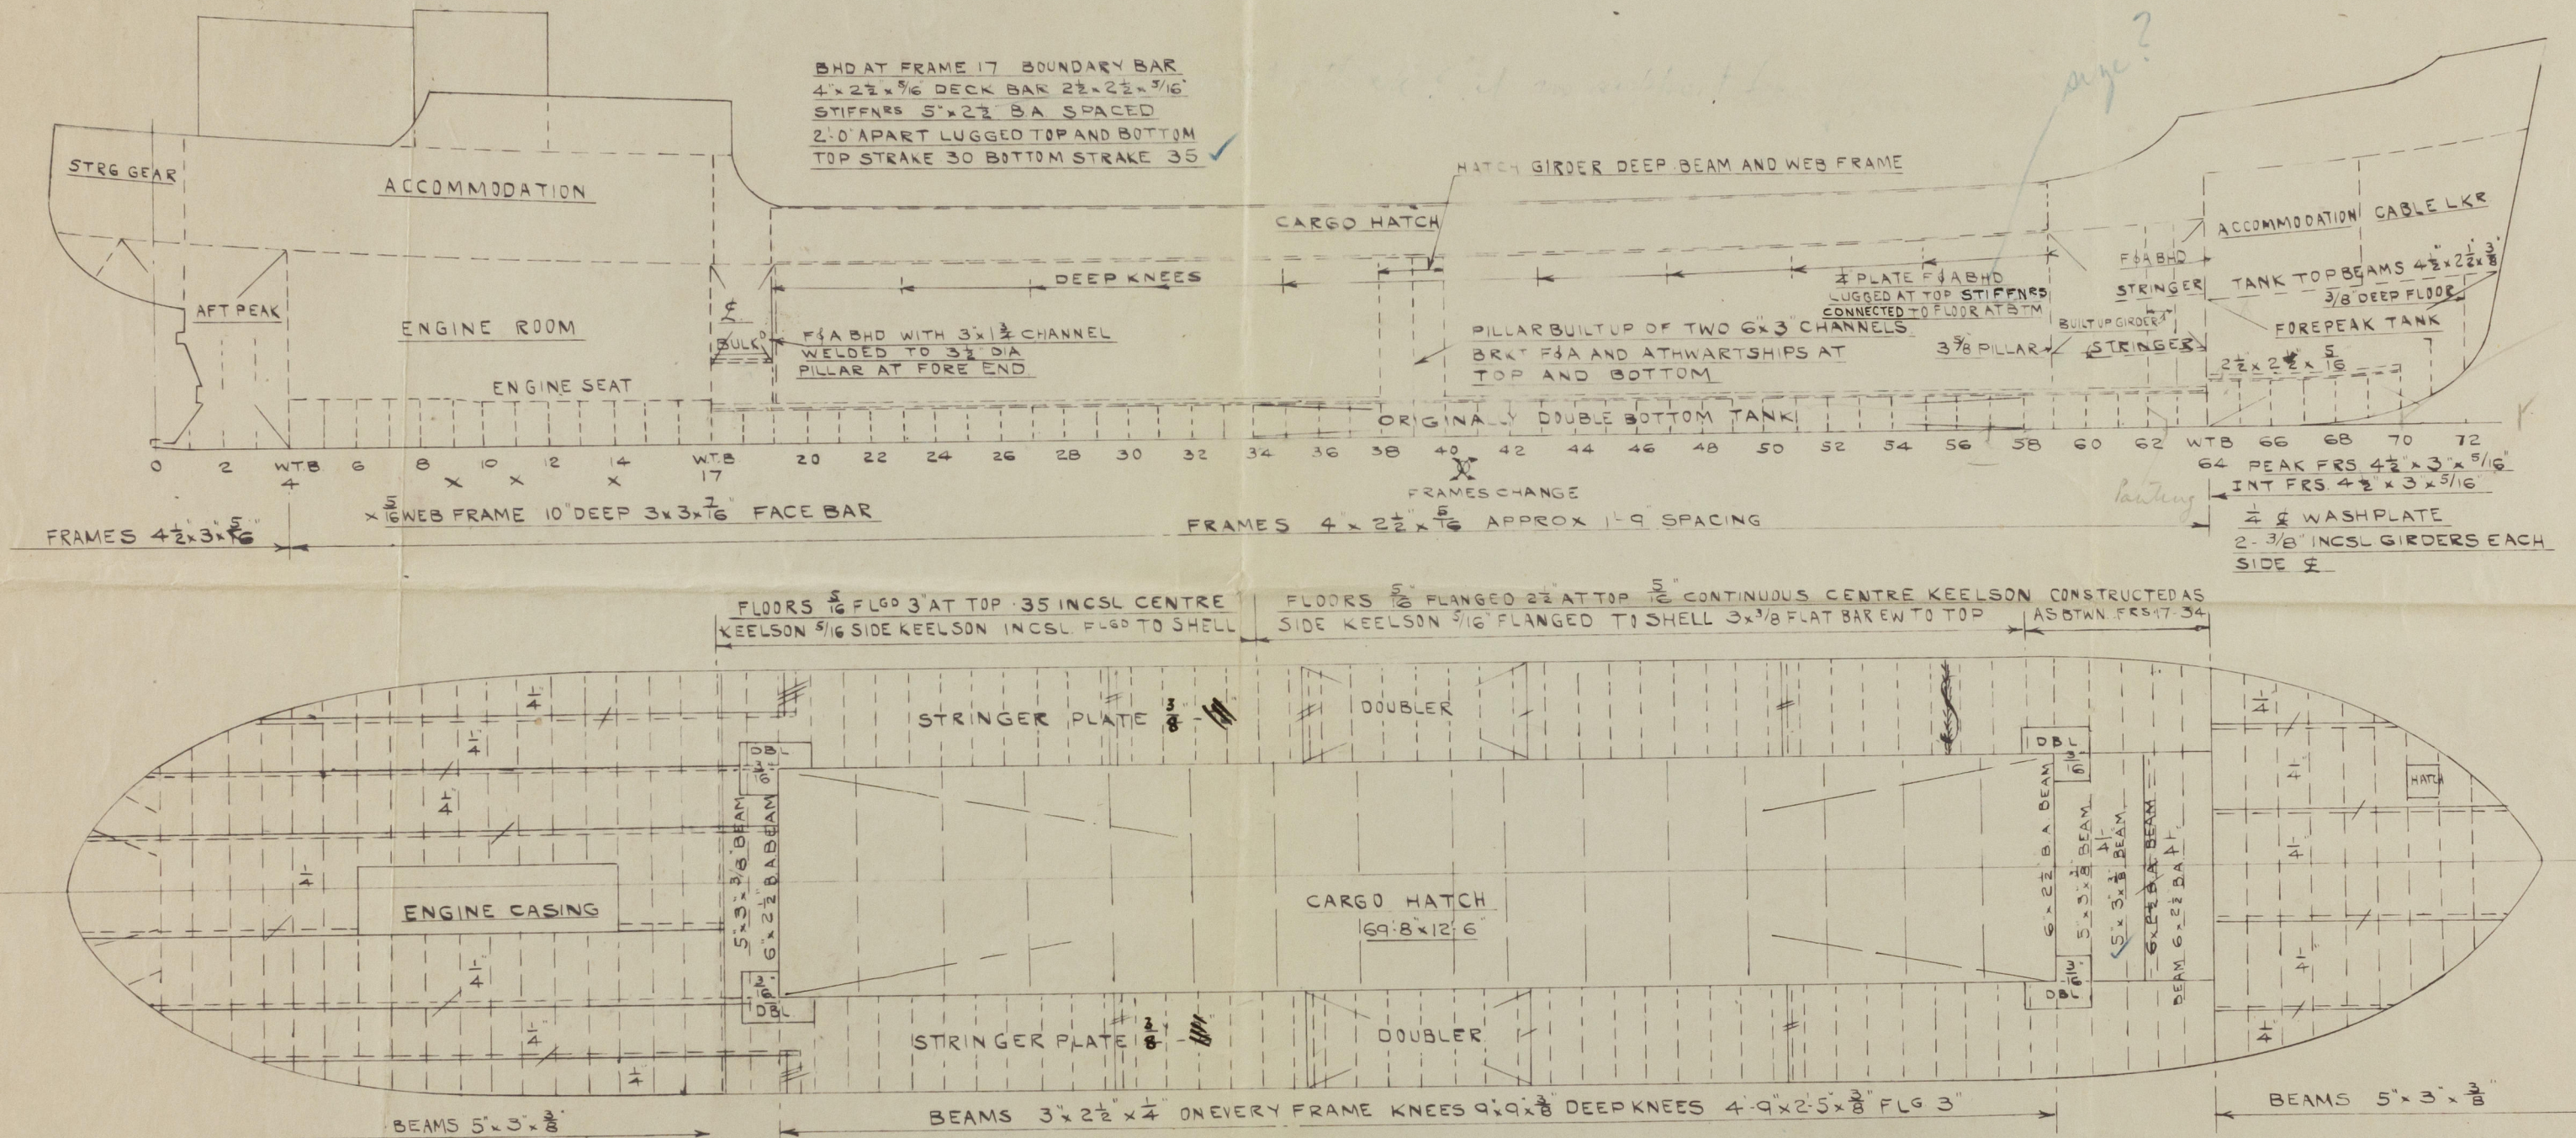

Rule book of
 Peak Ltd

SEE ALSO DRAWING OF MIDSHIP SECTION

22.10.47

EMPIRE CONLEA
 PROFILE & DECK PLAN
 SCALE 1/8" = 1 FOOT.


"EMPIRE CONLEA"



Profile & decks.

3

RETAIN

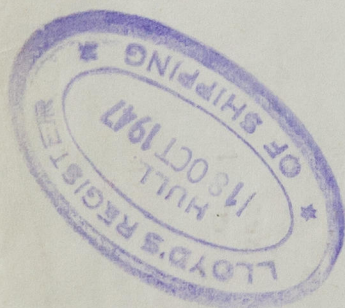

002038-002050-0081



© 2020

Lloyd's Register
Foundation