

# NUMERALS

L x D ..... 2325  
L x (B+D) 6355

# EQUIPMENT

1<sup>ST</sup> BOWER ANCHOR 9 1/4 CWTs - STOCKLESS  
2<sup>ND</sup> " " 8 3/4 " "  
KEDGE ANCHOR 3 3/4 CWTs - EX STOCK  
135 FMS 1 3/16" STUD LINK CABLE  
60 FMS. 6" HAWSER  
60 FMS 5 1/2" WARP

# MIDSHIP SECTION STEEL SCREW TRAWLER

No. 1165

155'-0" B.P. x 26'-0" MLD. x 15'-0" MLD.  
TO CLASS 100 A.I. STEAM  
TRAWLER

SCALE 1/2 IN. = 1 FT.

# RIVETING


ALL LANDING EDGES TO BE DOUBLE RIVETTED  
EXCEPT TOP EDGE OF SHEERSTRAKE, WHICH IS TO  
BE SINGLE RIVETTED.

BUTTS OF SHEERSTRAKE AND GARBOARD TO BE  
STRAPPED AND TREBLE RIVETTED FOR 1/2 LENGTH, DOUBLE AT ENDS.

BUTTS OF E AND F STRAKES OVERLAPPED AND  
TREBLE RIVETTED FOR 1/2 LENGTH - DOUBLE AT ENDS.

REMAINDER OF BUTTS OVERLAPPED AND DOUBLE  
RIVETTED ALL FORE AND AFT.

ALL RIVETS TO BE IRON.

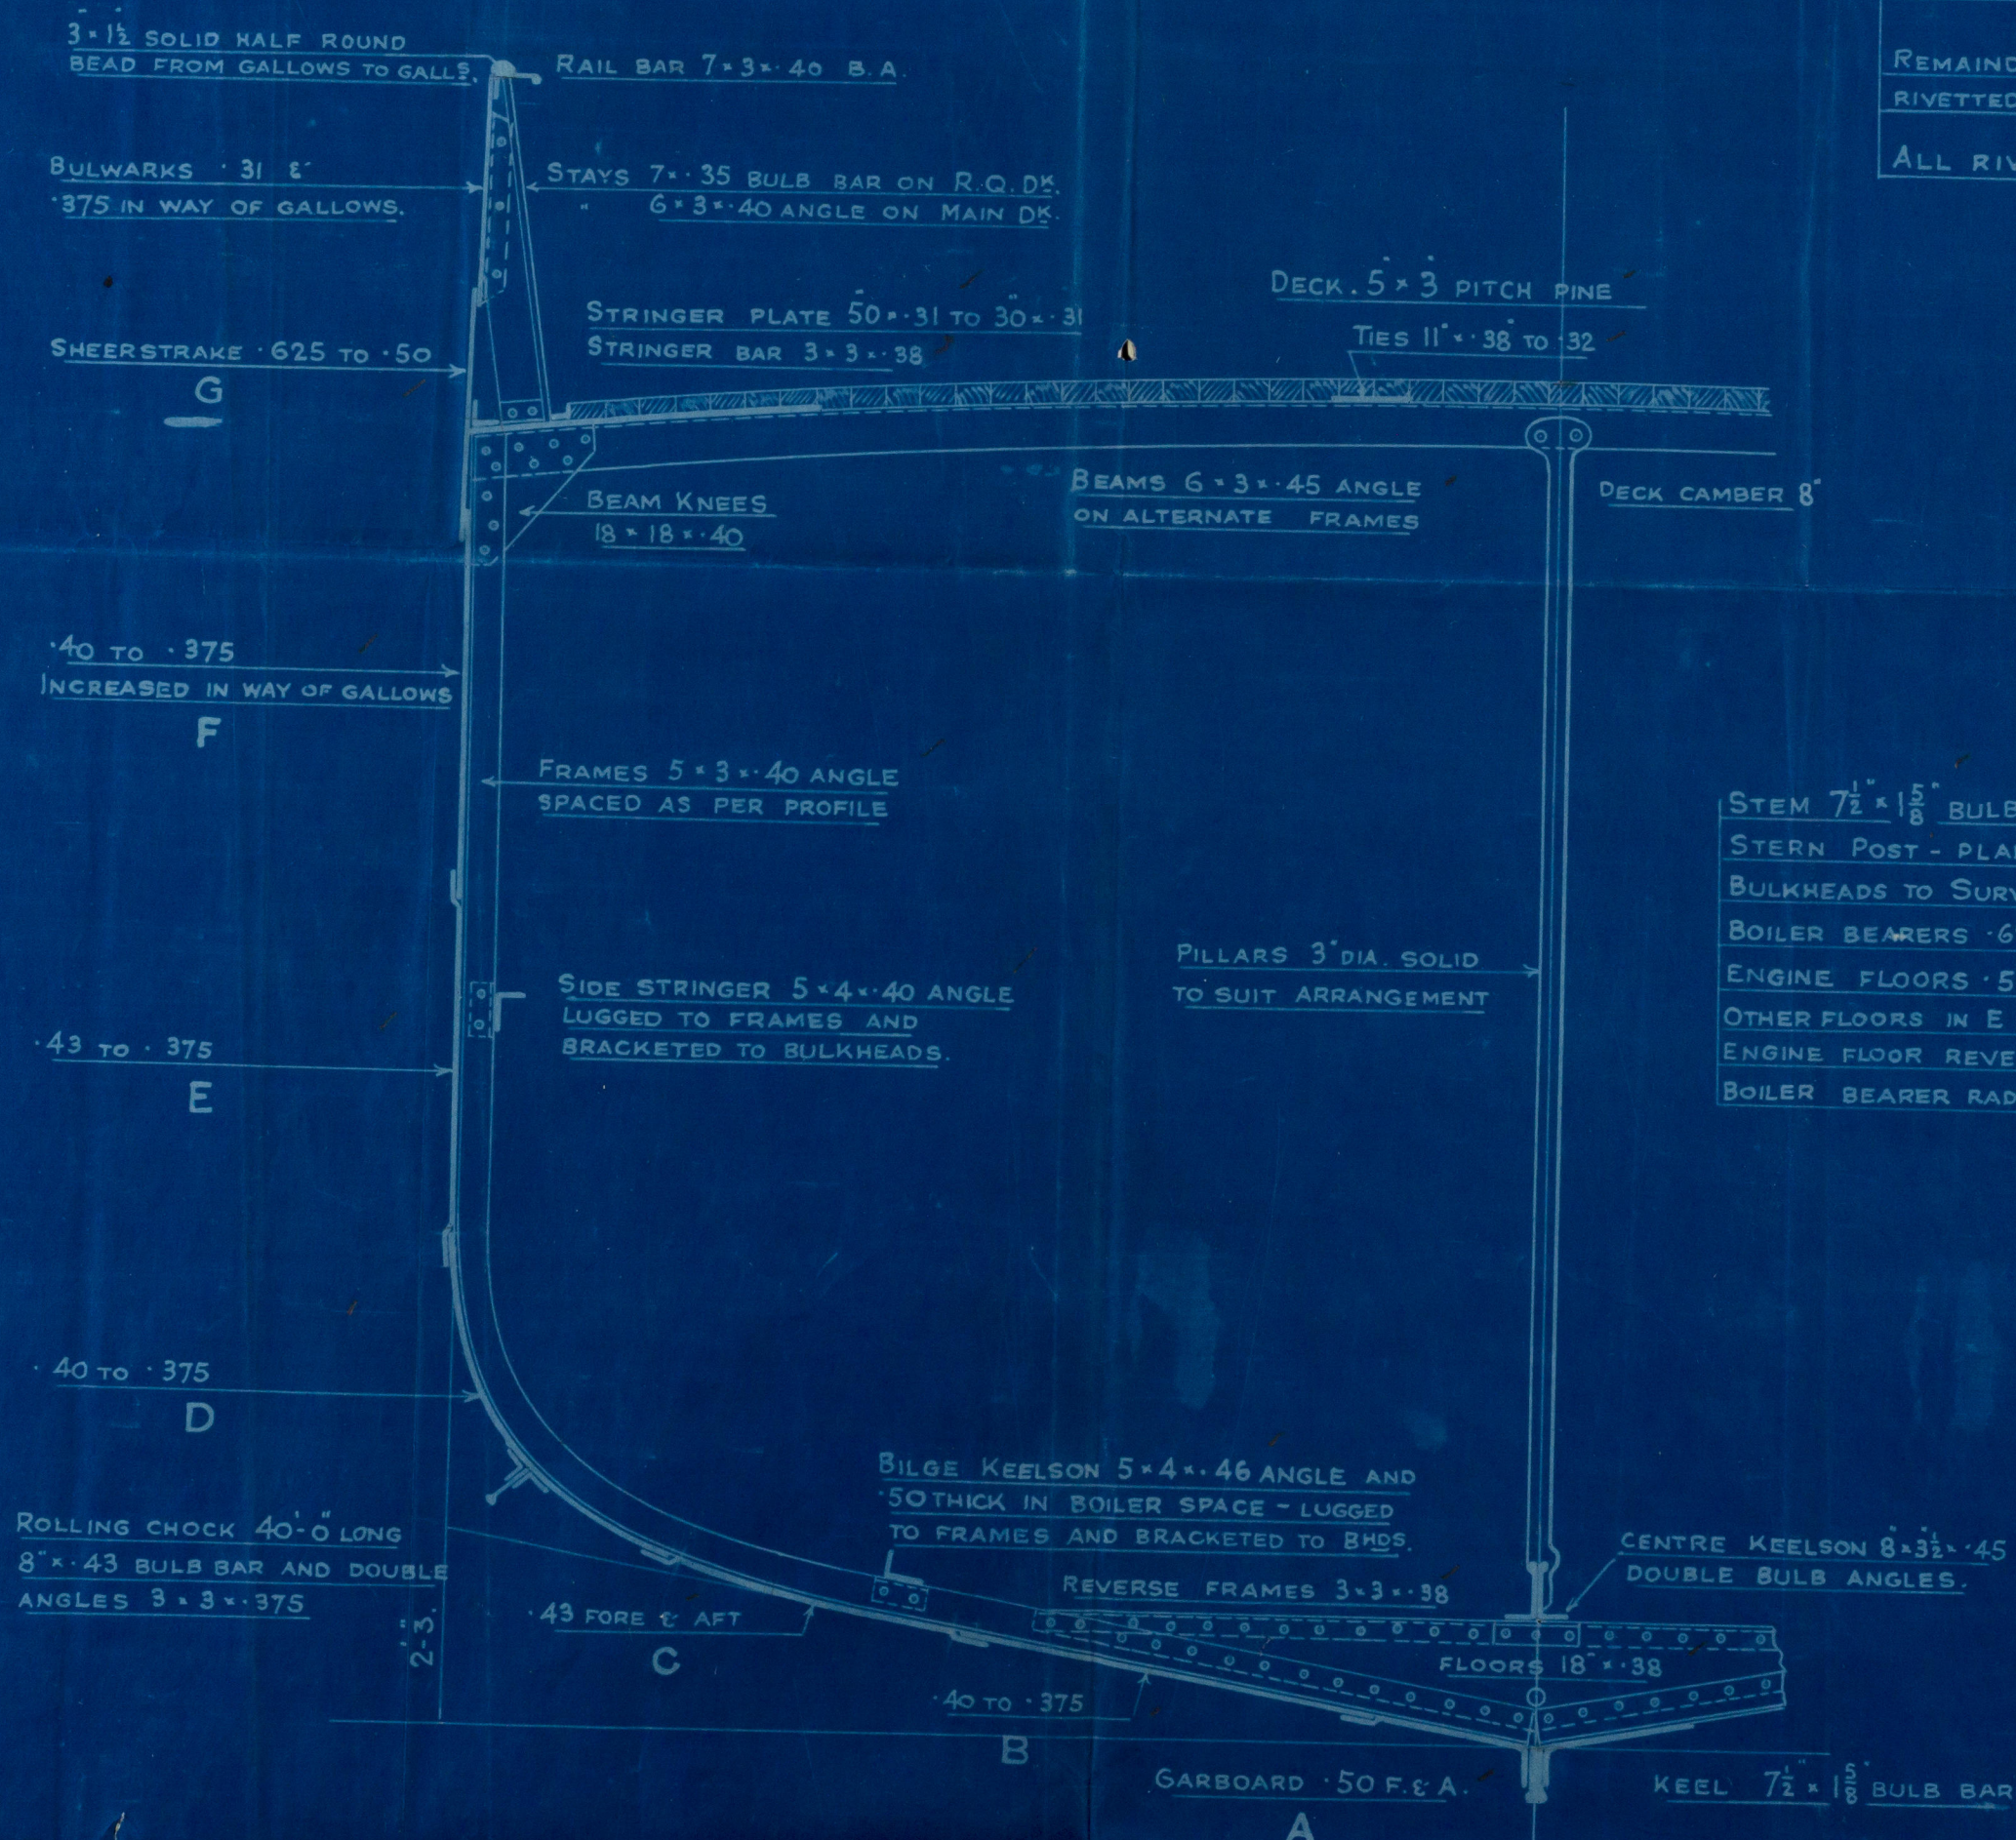

© 2020

Lloyd's Register  
Foundation

002036 002010-0142



No. 7165

Midship Section.  
(abstract)

Cochranes Survey.

RETAIN

*Stella Baring*

S.S. K" Ocean Monarch"

HULL REPORT No. 44130.

002038-002050-0142



© 2020

Lloyd's Register  
Foundation



PLAN No. 4707  
FOR ENCLOSURE TO  
*Lloyds Register of Shipping*  
*Hull* FROM  
COCHRANE & SONS, LTD.  
SHIPBUILDERS, SELBY.  
DATE 10/8/36

165  
A for as built



© 2020  
Lloyd's Register  
Foundation