


PROF. 8 030  
111

NO. 1165 - PROFILE & DECK PLAN  
155'-0" B.P. x 26'-0" MLD x 15'-0" MLD.  
TO CLASS 100.A.I. STEAM TRAWLER.



PROF. 8 030  
111

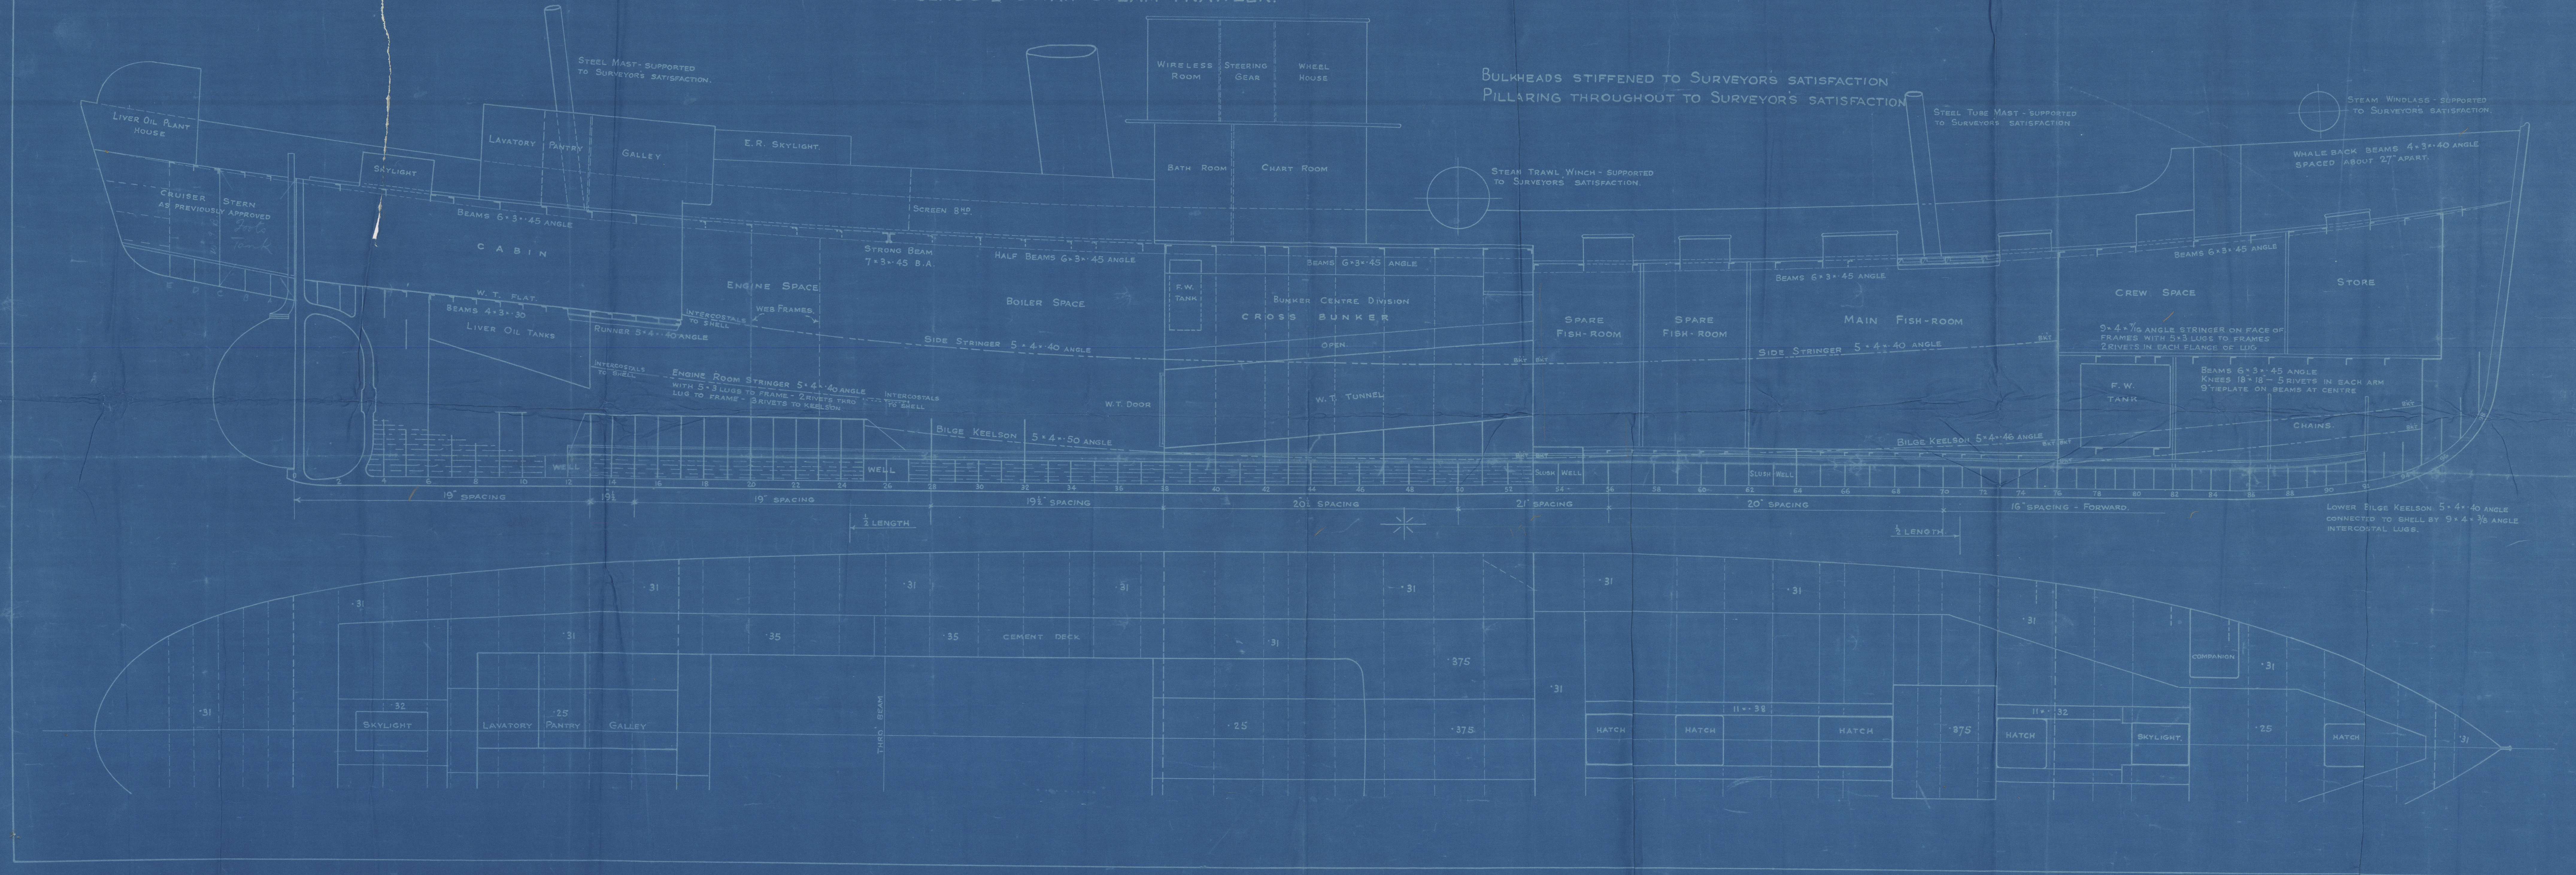


PLAN No. 4706

FOR ENCLOSURE TO

*Lloyds Register of Shipping*  
*Hull* FROM

COCHRANE & SONS, LTD.  
SHIPBUILDERS, SELBY.

DATE 10/8/36

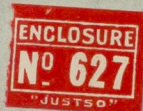

*1165 part as hull*



© 2020

Lloyd's Register  
Foundation



No. 1165

Profile & Deck (as built)

Cochran & Sons Ltd.

DANIEL QUARE

Stella Baring

S. S. K. "Ocean Monarch"

HULL

J. N.

47130

RETAIN

002038-002050-0143



© 2020

Lloyd's Register  
Foundation