



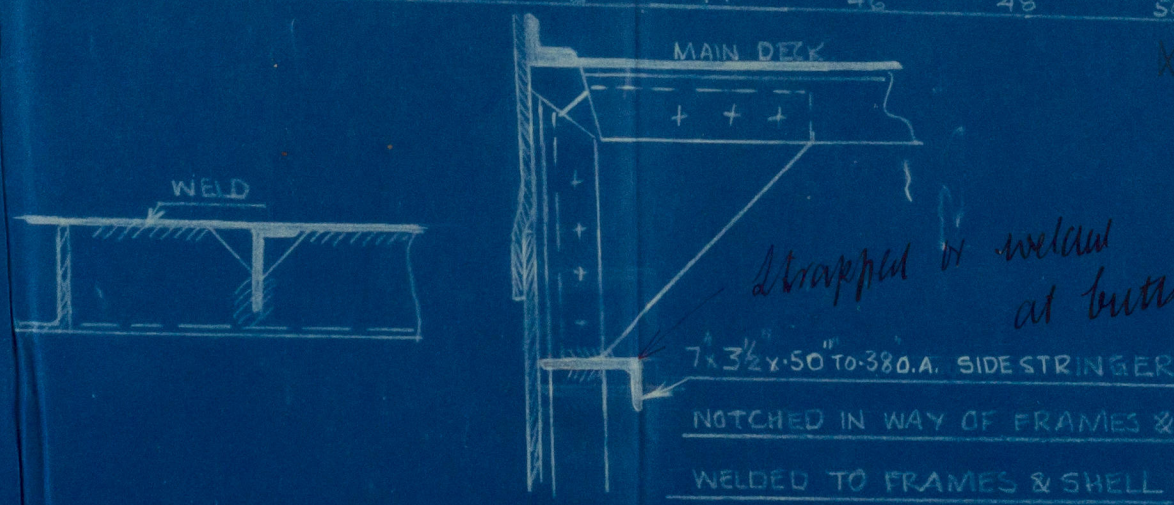

S/T DARTHEMA NEW SIDE STRINGERS

SCALE $\frac{1}{4}" \& 1" = 1 \text{ FOOT}$

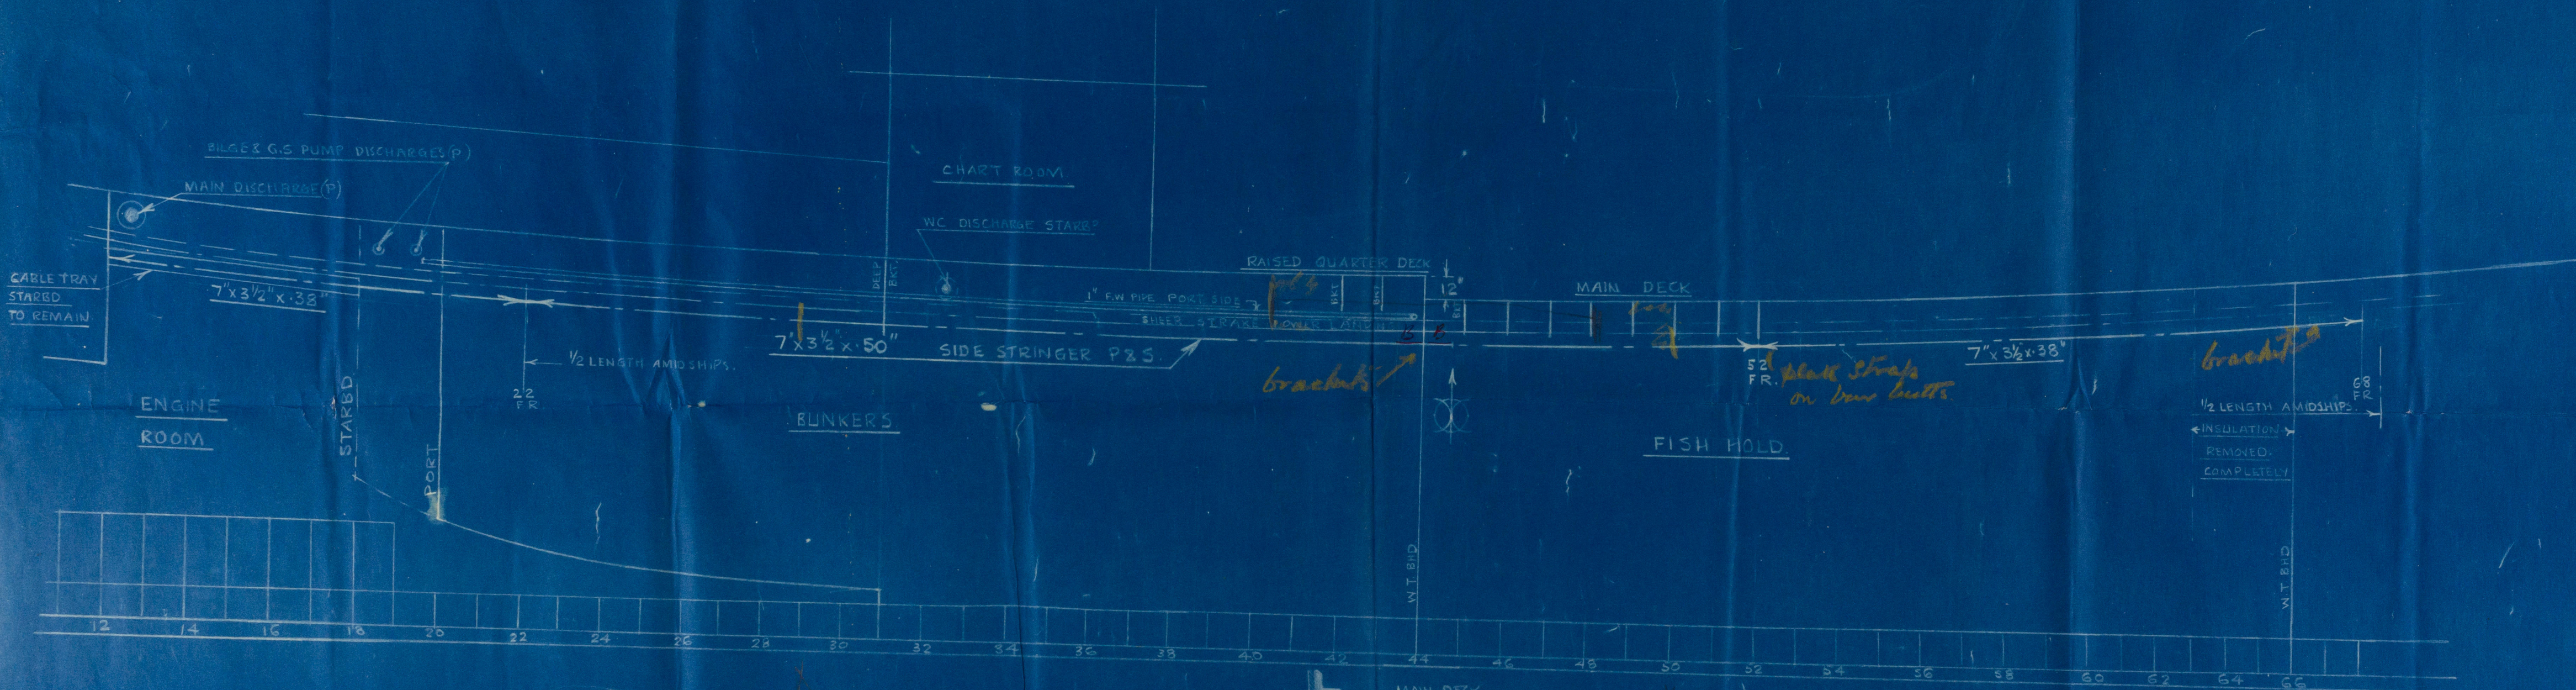

DETAIL OF STRINGER

"Dantlema"

Smith's Dock Co. Ltd

Plan of proposed side
Stringer

S.S. "Dantlema"
MDB. RPT. No. 16585

© 2020

002038-002050-0231

Lloyd's Register
Foundation