

27 FEB 1939

# "DARTHEMA"

## NEW FORE END FRAMING.


FRAMES SPACED 17" APART FROM N° 66 TO STEM.

ALL NEW FRAMES JOGGLED.

ALL FRAMES CUT & BRACKETED AT MAIN DECK.

FORECASTLE DECK BEAMS 4x3x40. KNEES 12"x40.

EXISTING RUNNER UNDER FORE DE<sup>2</sup> EXTENDED TO FR N° 93.

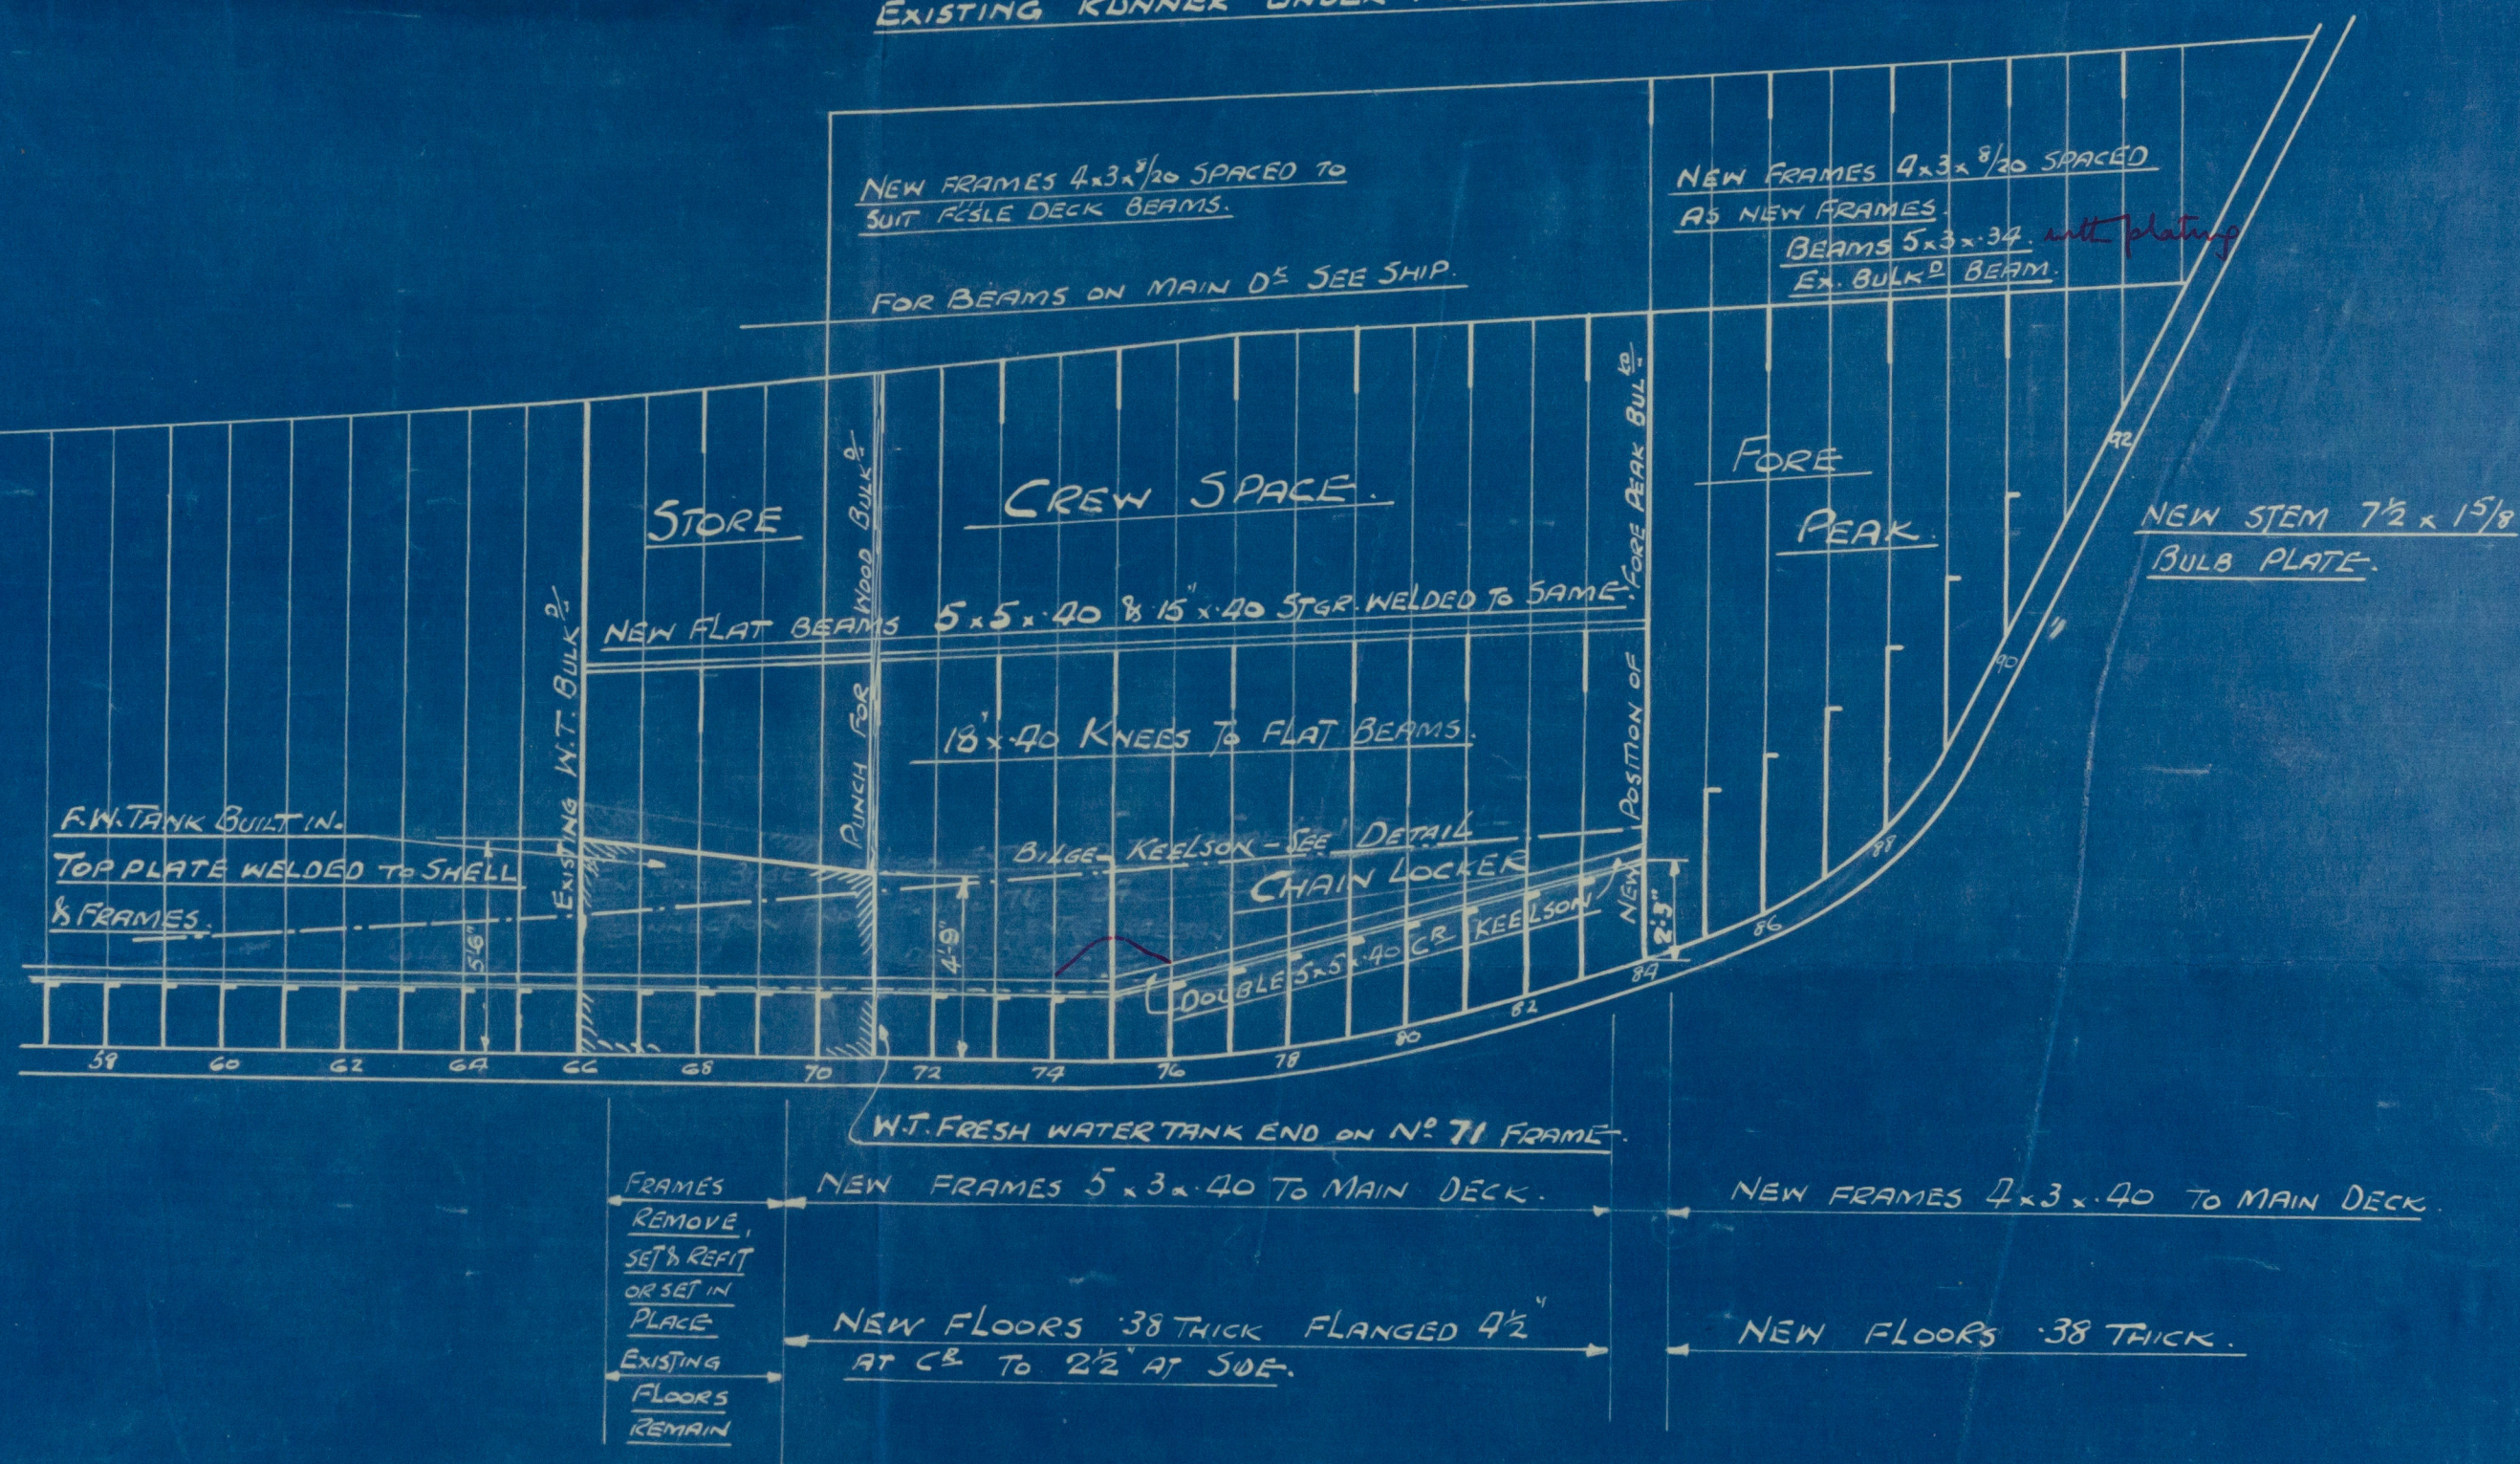

### RIVETING.

FRAMES TO SHELL ABOVE D STRAKE	3/4 RIVETS	SPACED 5 1/4 CB
" " " D STRAKE & BELOW	3/4	" " 4 1/8
" " FLOORS	3/4	" " 4 1/8

27/2/39



102058-002070-0232



S.T. "Danthema"

Messrs. Smith's Dock Co. Ltd.

Plan of New Fore End Framing

S.S. "Danthema"  
MDB. RPT. No. 16585



© 2020

Lloyd's Register  
Foundation

602038-002050-0232