
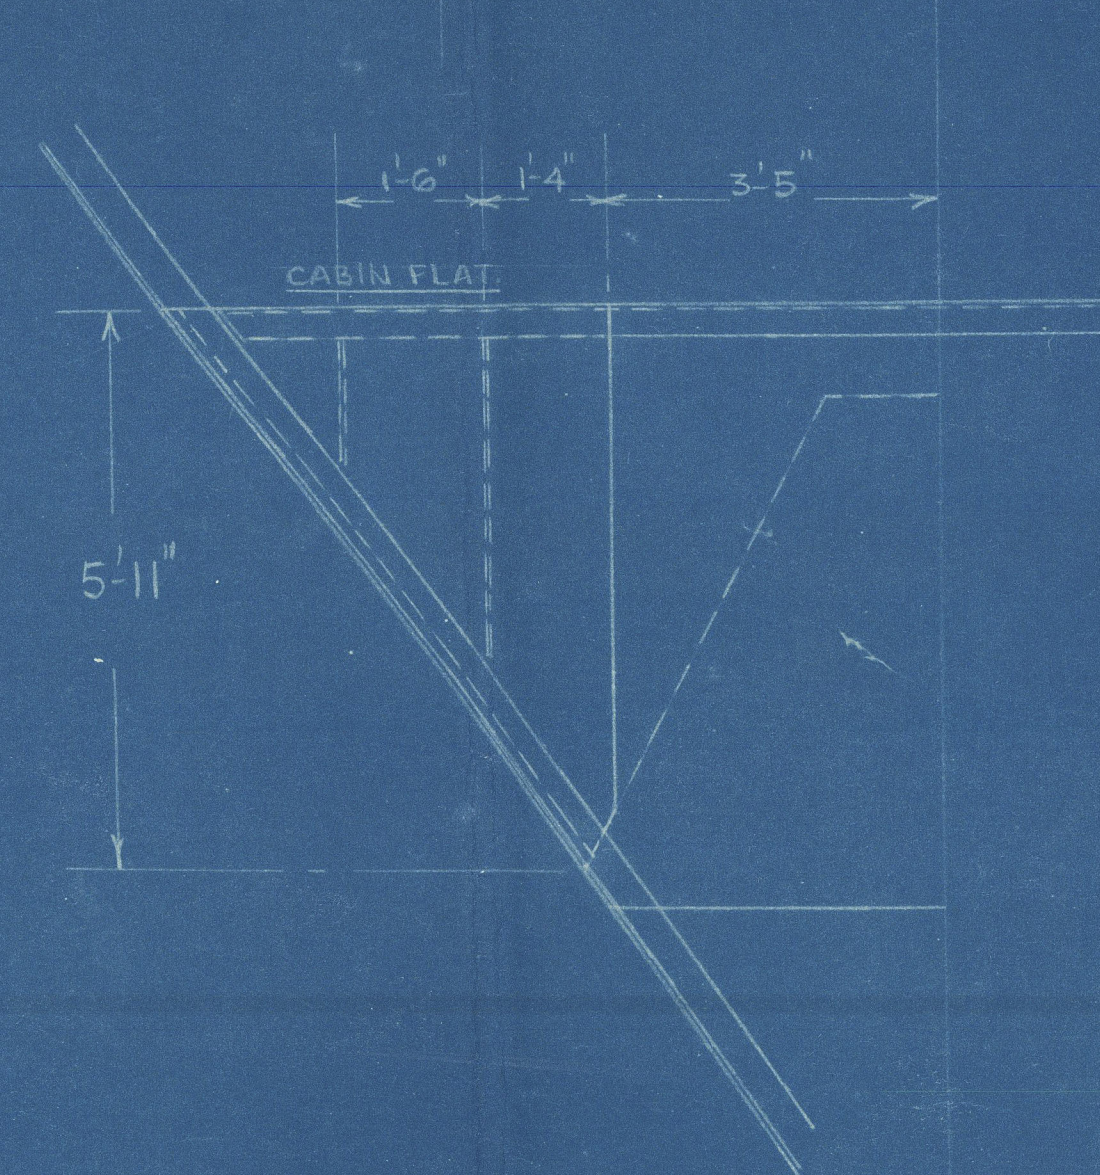
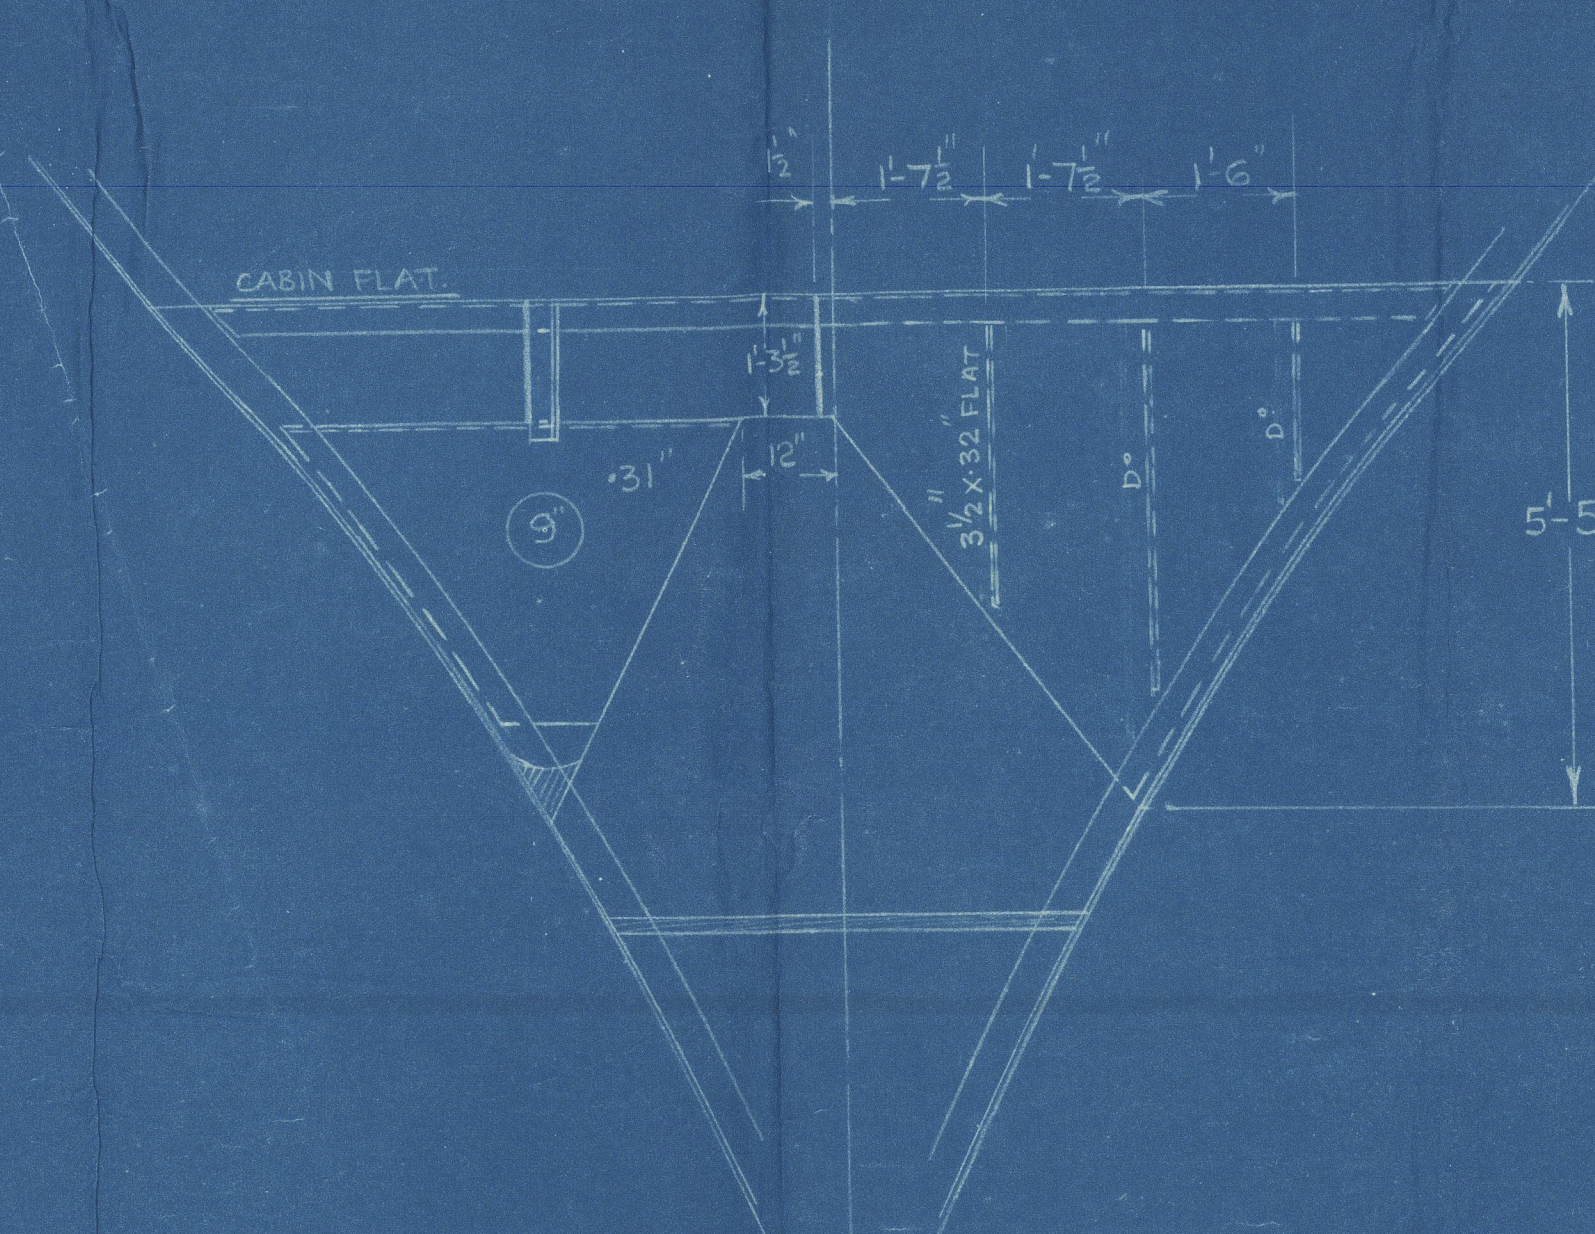
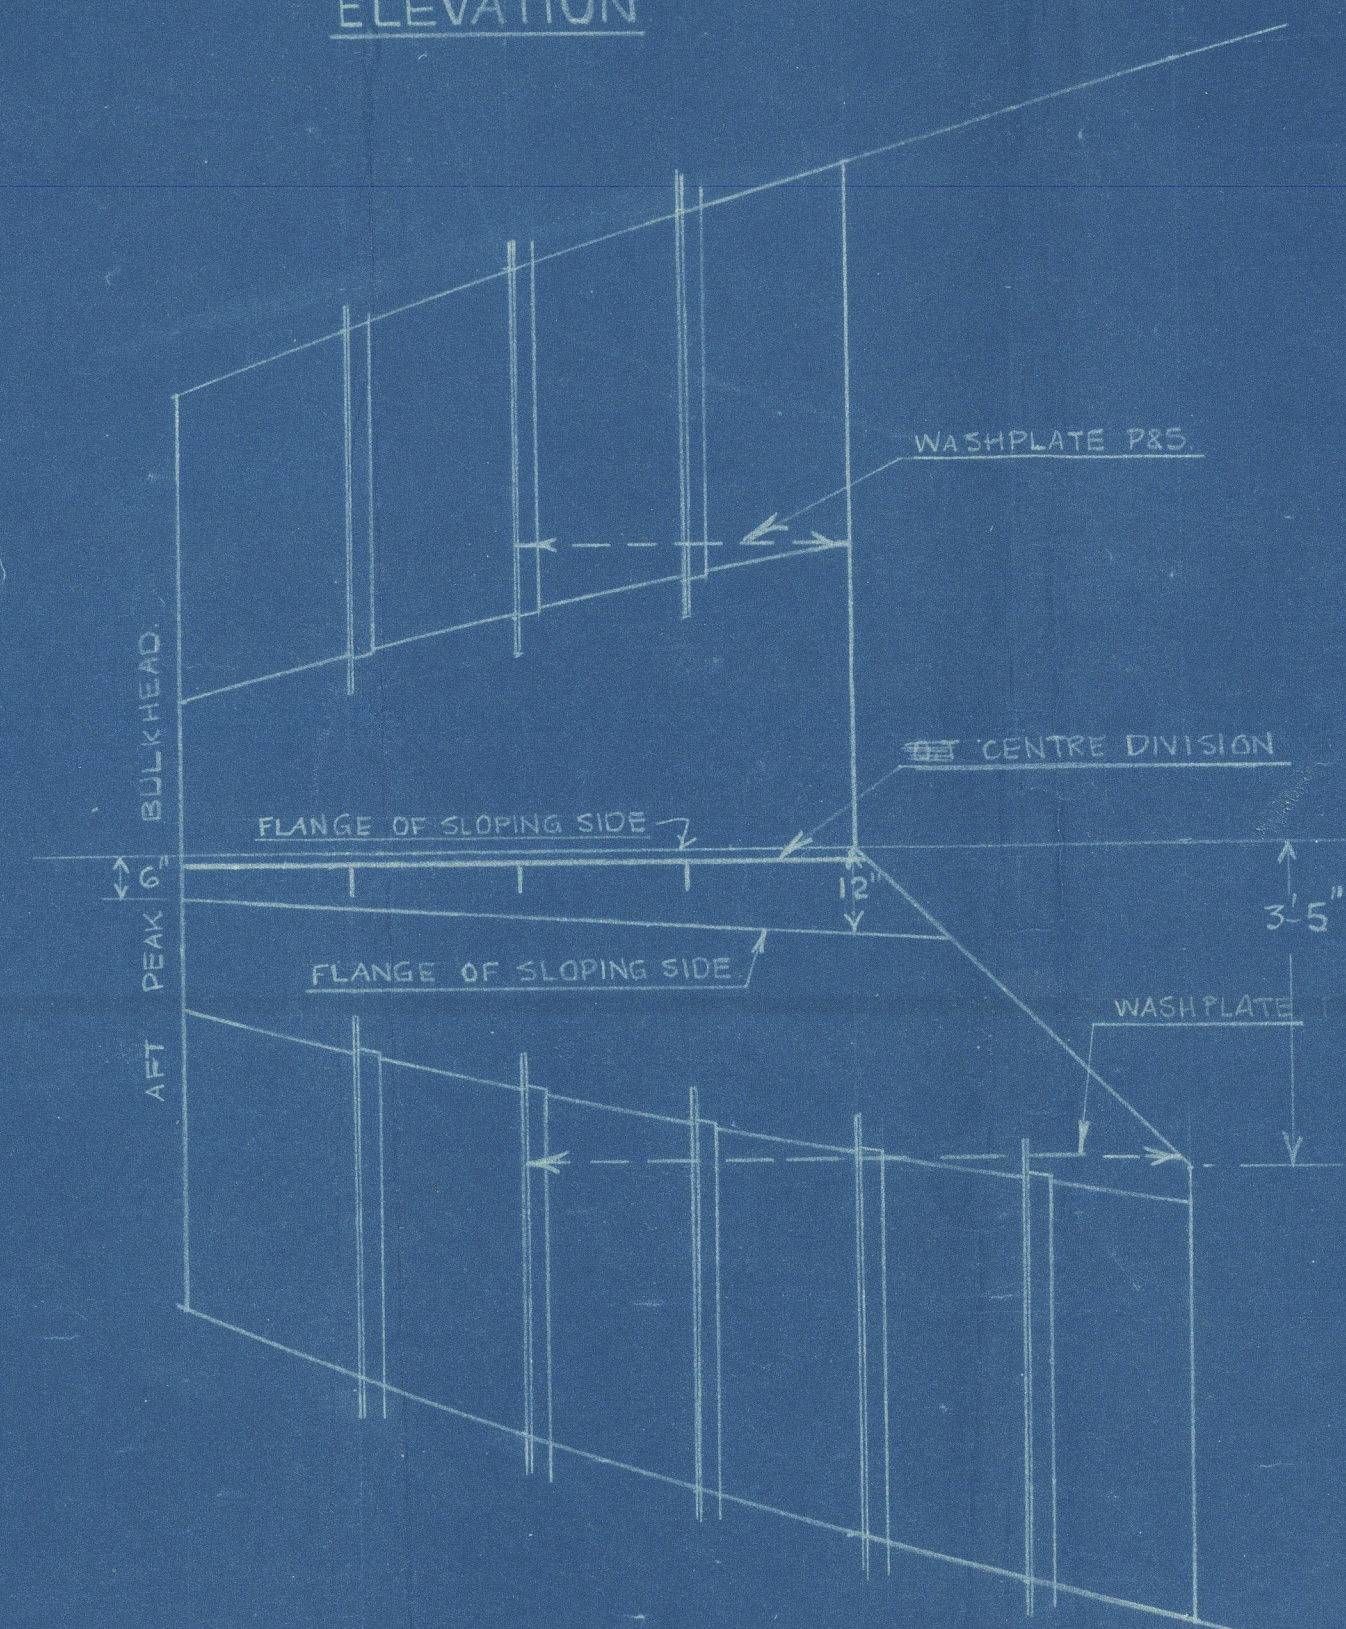
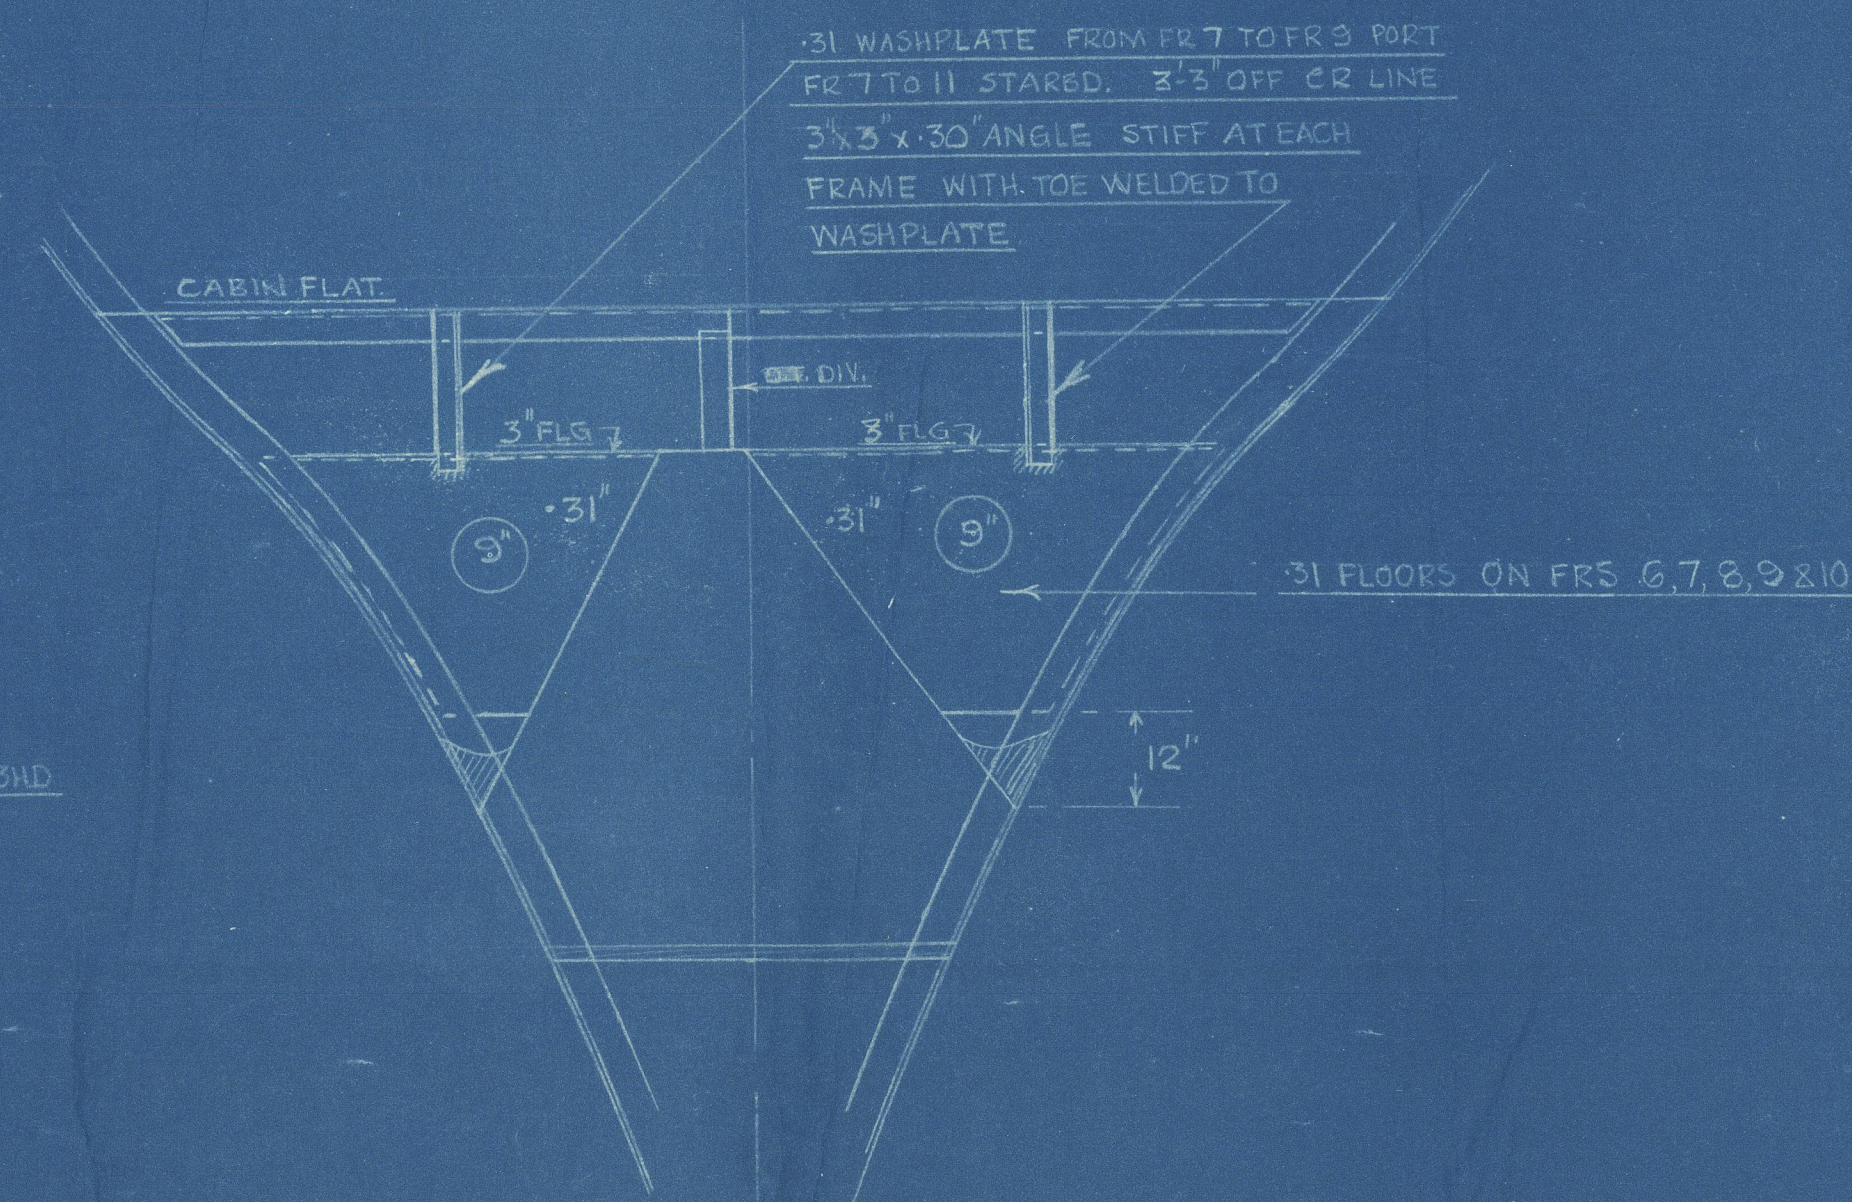
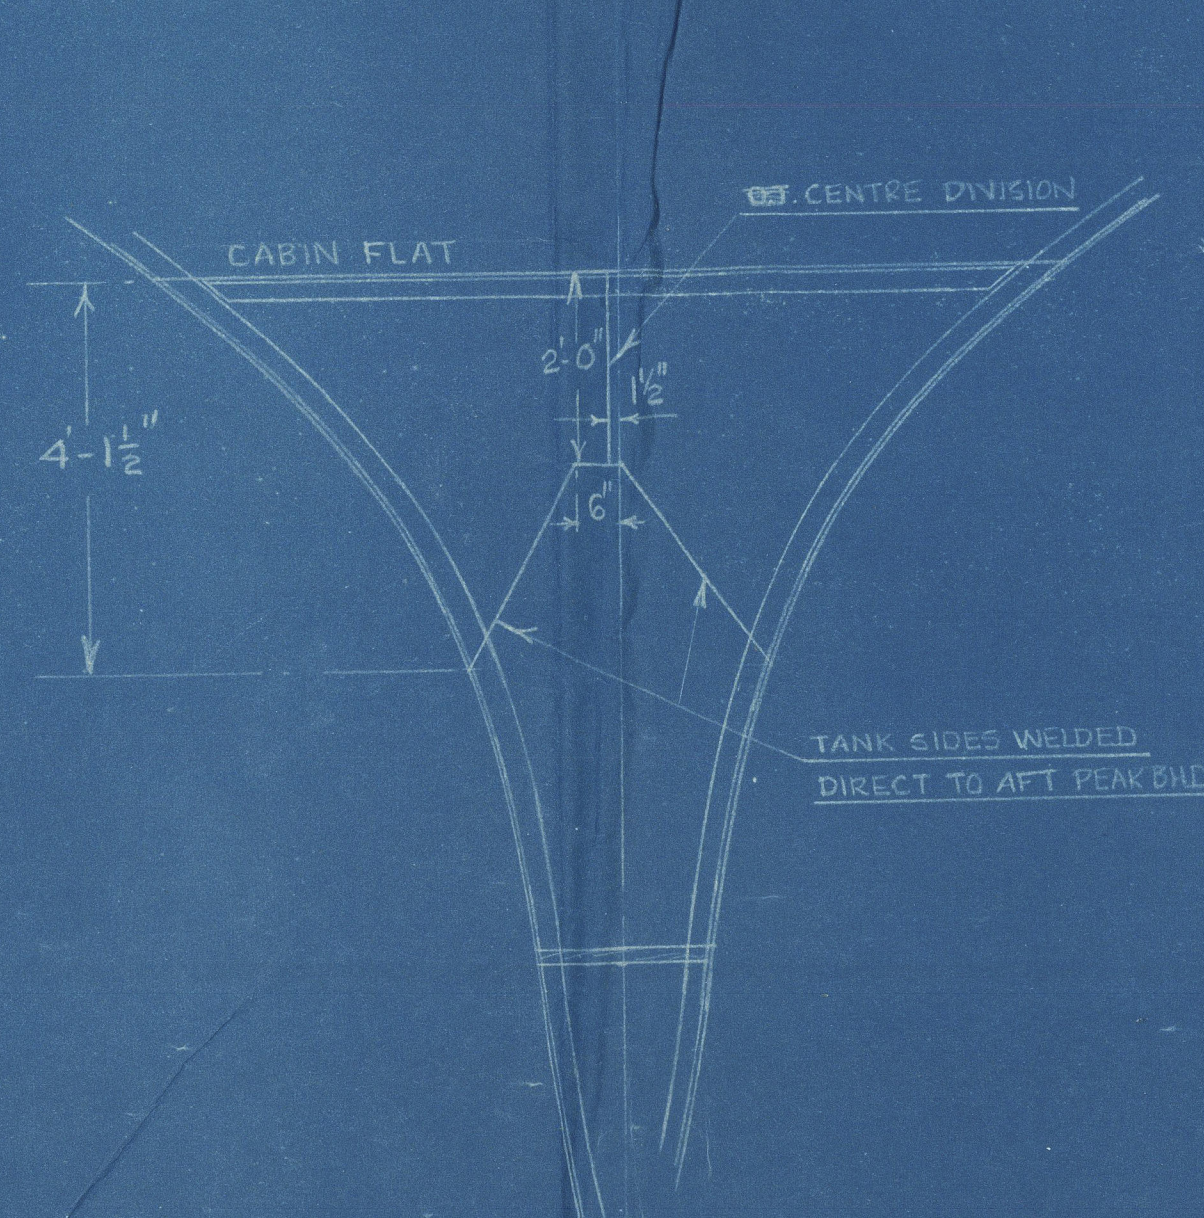


51T DARTHEMA

COD LIVER OIL TANKS UNDER AFT CABIN FLAT

SCALE: $\frac{1}{2}" = 1 \text{ FOOT}$

CAPACITY 7.04 TONS

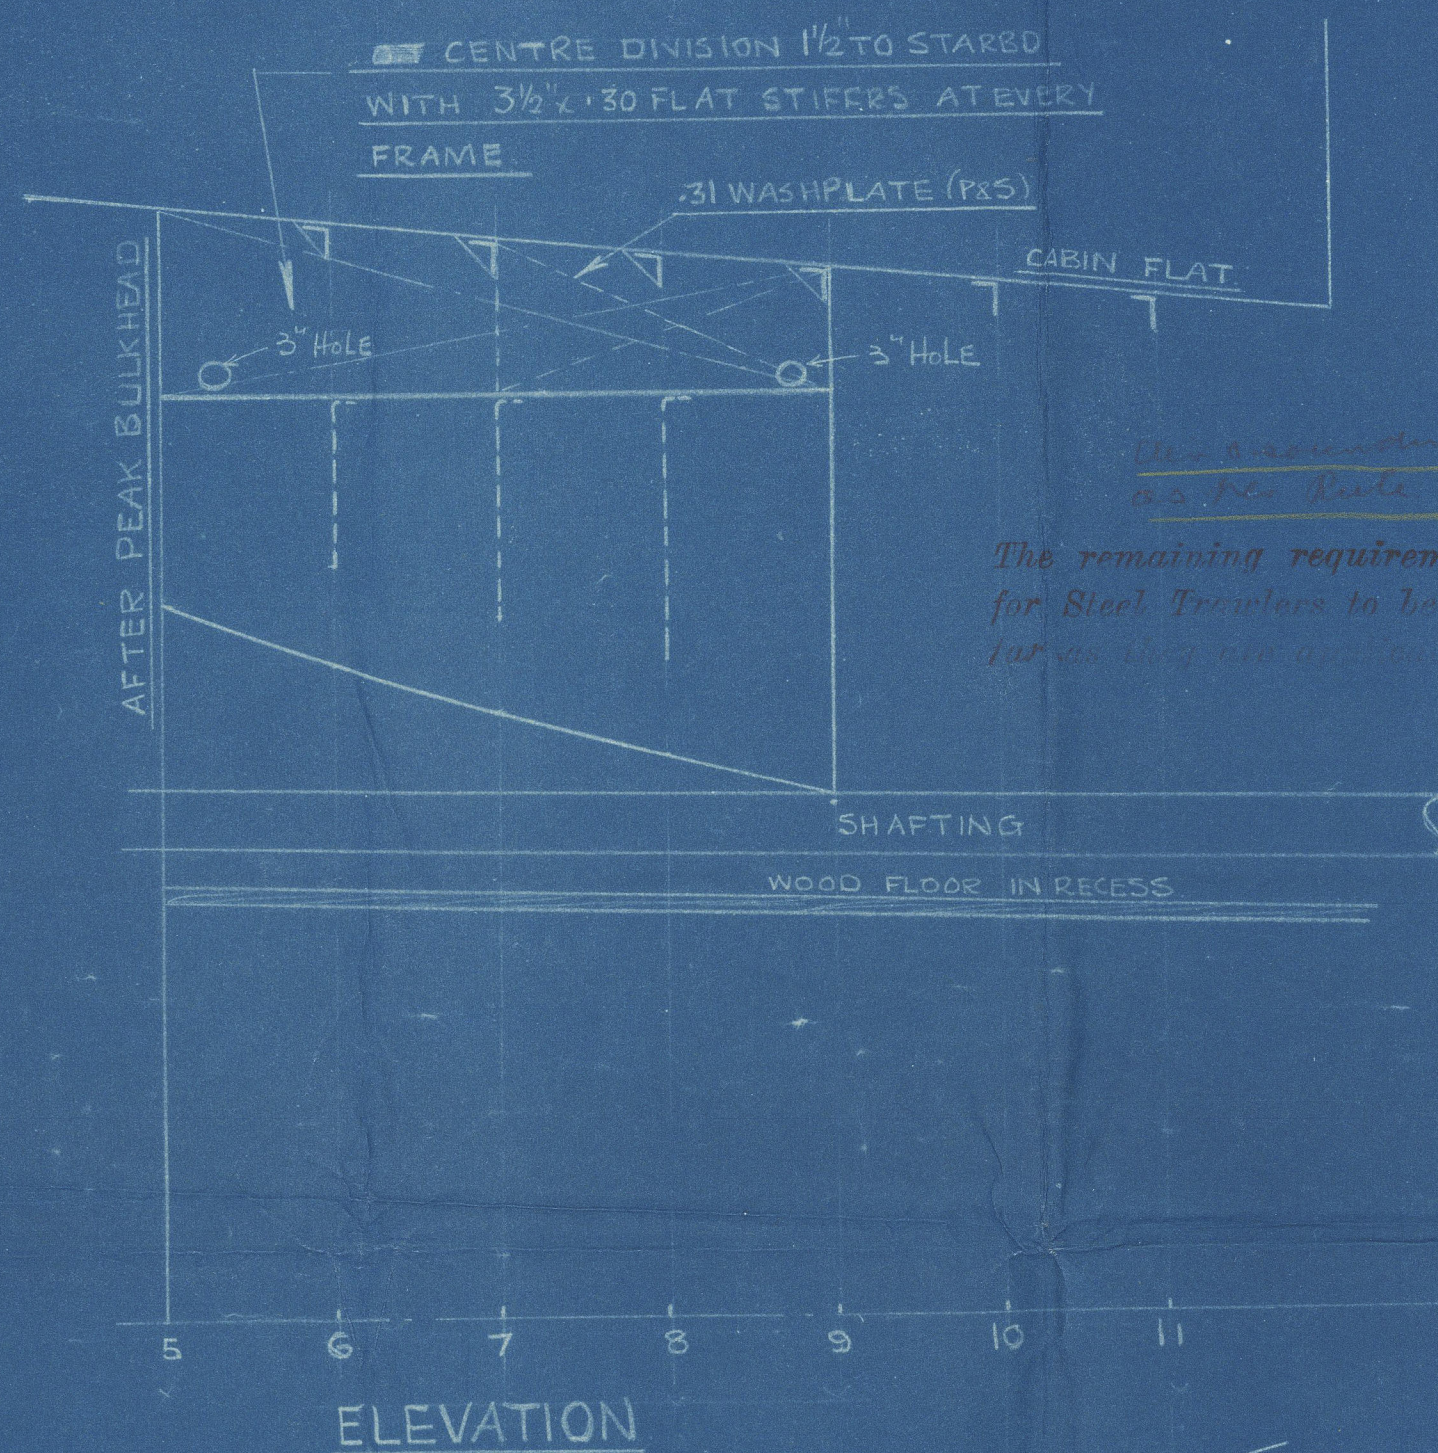

S.T. "Dantheima"

Messrs. Smith's Dock Co. Ltd..


aft cabin flat

S.T. "Dantheima"
MDB. RPT. No. 16585

© 2020
002038-002050-0234

Lloyd's Register
Foundation