


LONGITUDINAL SECTION AND DECK PLAN RAISED QUARTER DECK COASTER N° 381

TO CLASS LLOYDS 100 A.I. +

DIMENSIONS: LENGTH B.P. 175'-0" B.MLD. 28'-0" D.MLD. 13'-6" UPPER DK. 17'-6" QUARTER DK.

SCALE 1/4 IN. = 1 FOOT.

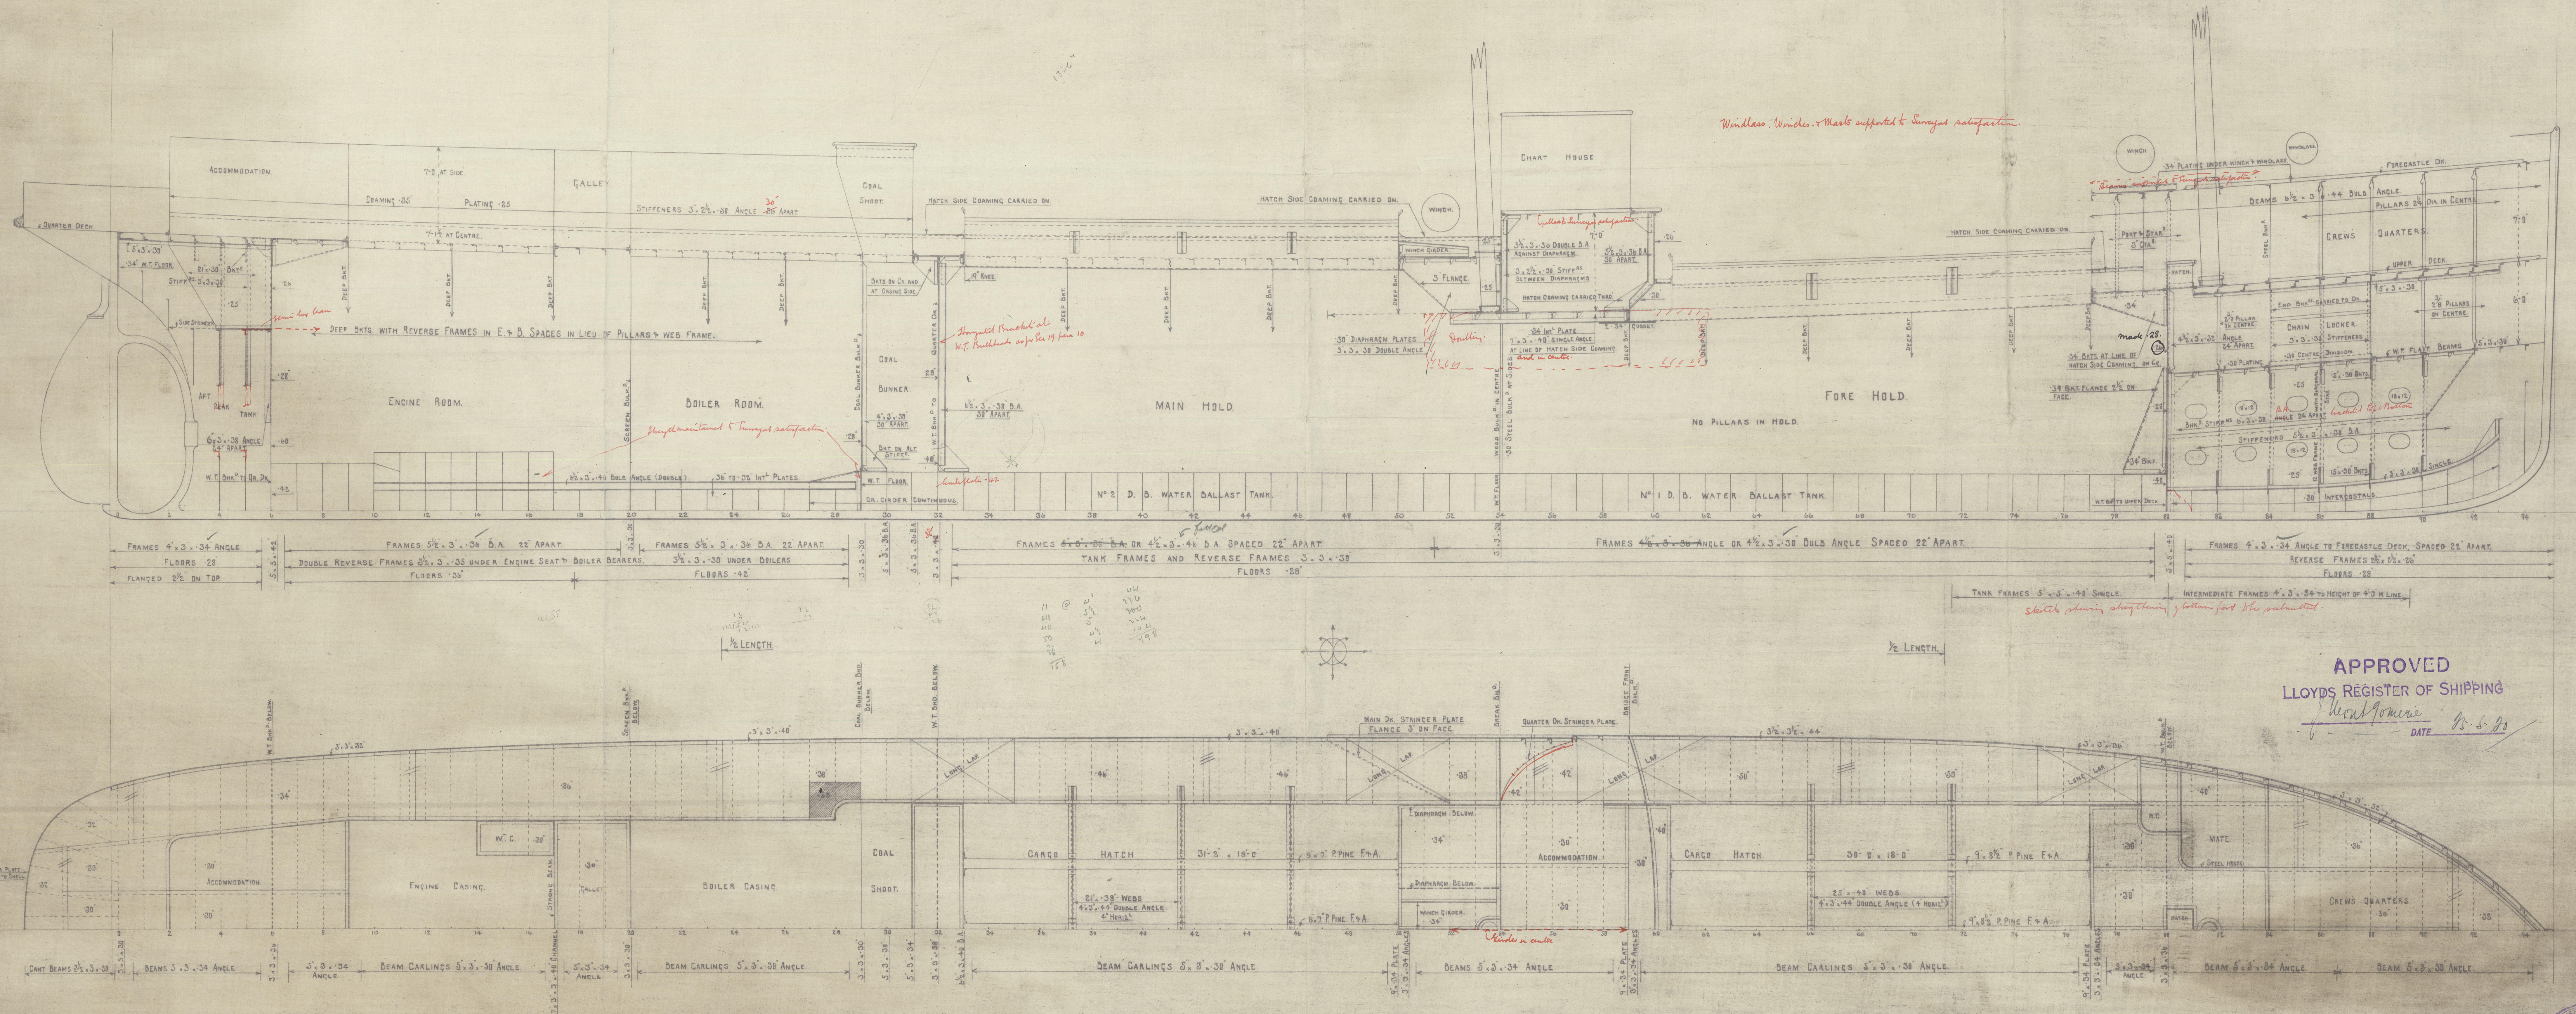

APPROVED
LLOYDS REGISTER OF SHIPPING

Handwritten signature
DATE 18.5.20

Orkney Coast

Ailsa B.

381.

Profile & Decks

S/S "Arclight"

GLASGOW REPORT No. 4/433.

"

"

Dransfield

RETAIN



© 2020

002038-002030-0270

Lloyd's Register
Foundation