

RIVETING		
END CONNECTIONS	$\frac{1}{2}$ LEN ST	AT ENDS
FOUNDATION PLATE	DOUBLE	DOUBLE
DECK STRINGER PLATE UPPER DK.	TREBLE	DOUBLE
DECK STRINGER PLATE QUARTER DECK	DOUBLE	SINGLE
SHEERSTRAKE	DOUBLE	DOUBLE
TOP SIDE PLATING	DOUBLE	DOUBLE
SHELL PLATING	DOUBLE	SINGLE
BULWARK PLATING	SINGLE	SINGLE
SEAM CONNECTIONS		
DECK PLATING	SINGLE	SINGLE
SHEERSTRAKE	SINGLE	SINGLE
TOP SIDE PLATING	SINGLE	SINGLE
SHELL PLATING	SINGLE	SINGLE
KEEL	SINGLE	SINGLE
BOTTOM SHELL PLATING FORWARD	-	DOUBLE

MIDSHIP SECTION

CLASSED: BRITISH CORPORATION B.S. *

EQUIPMENT TONNAGE		
UPPER DECK	$16.4 \times 22 \times 10 = \frac{3608}{100}$	= 140.4 ✓
QUARTER DECK	$16 \times 22 \times 3.1 = \frac{1103.2}{100}$	= 15.7 ✓
BRIDGE DECK	$8.75 \times 22 \times 17.5 = \frac{3371.875}{100}$	= 7.5 ✓
FORECASTLE DECK	$20 \times 22 \times 5 = \frac{2200}{100}$	= 12.1 ✓
	<u>TOTAL</u>	= 185.7 ✓

C N⁰

24/10/00

$124 \times 22 \times 10 = \frac{54080}{100} = 205$

$16 \times 22 \times 3.1 = \frac{1103.2}{100} = 24$

$8.5 \times 22 \times 17.5 = \frac{3306.25}{100} = 7$

$18 \times 22 \times 5 = \frac{1980}{100} = 11$

$10 \times 11.5 \times 6.25 = \frac{775}{100} = 1$


257


4 * 2 1/2% = 10.8

EQUIPMENT


2 BOWER ANCHORS EACH 7 CWTs. (STOCKLESS) ✓
1 STREAM ANCHOR 2 1/4 CWTs. (EX. STOCK) ✓
1 KEDGE ANCHOR 1 CWT (EX. STOCK) ✓
150 FATHOMS 1 1/16" STUD CHAIN CABLE ✓
45 FATHOMS 2 1/4" STEEL STREAM WIRE ✓
60 FATHOMS 2 1/4" STEEL WIRE TOWLINE ✓
90 FATHOMS 4 1/2" MANILLA HAWSER ✓

8 JULY 1927

Approved  6. 7. 77.

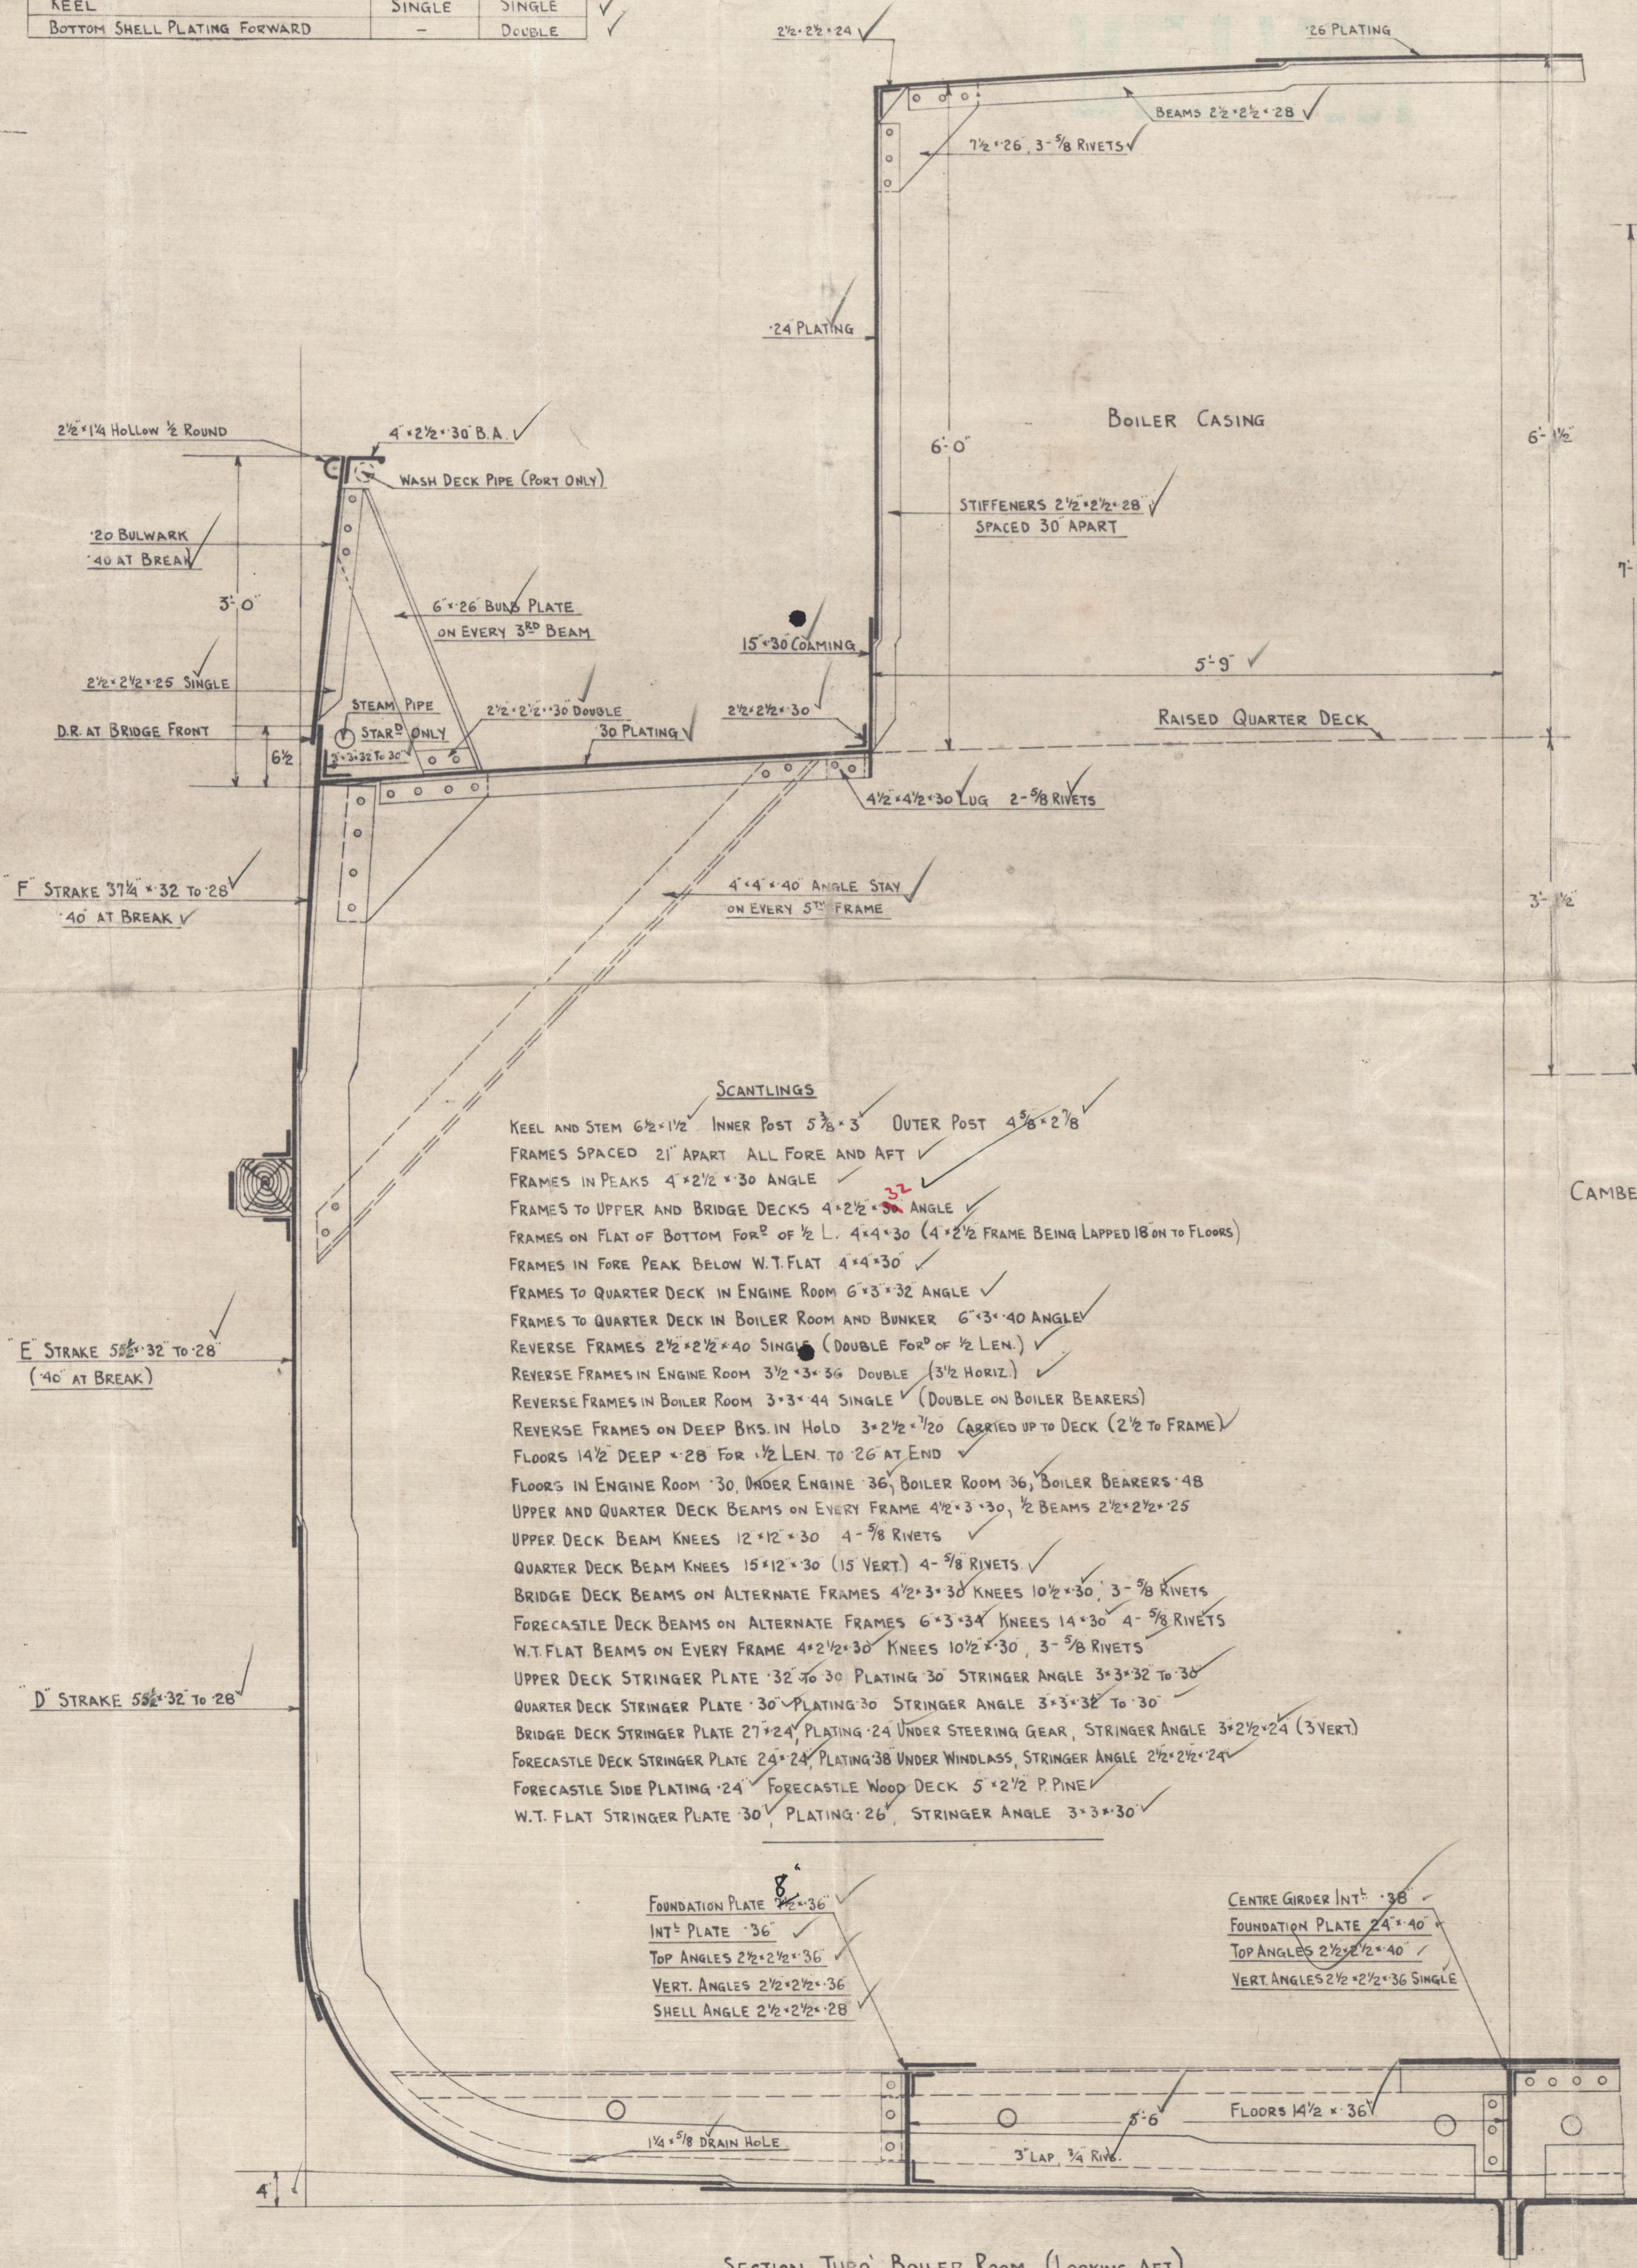


SECTION THRO' BOILER ROOM (LOOKING AFT)

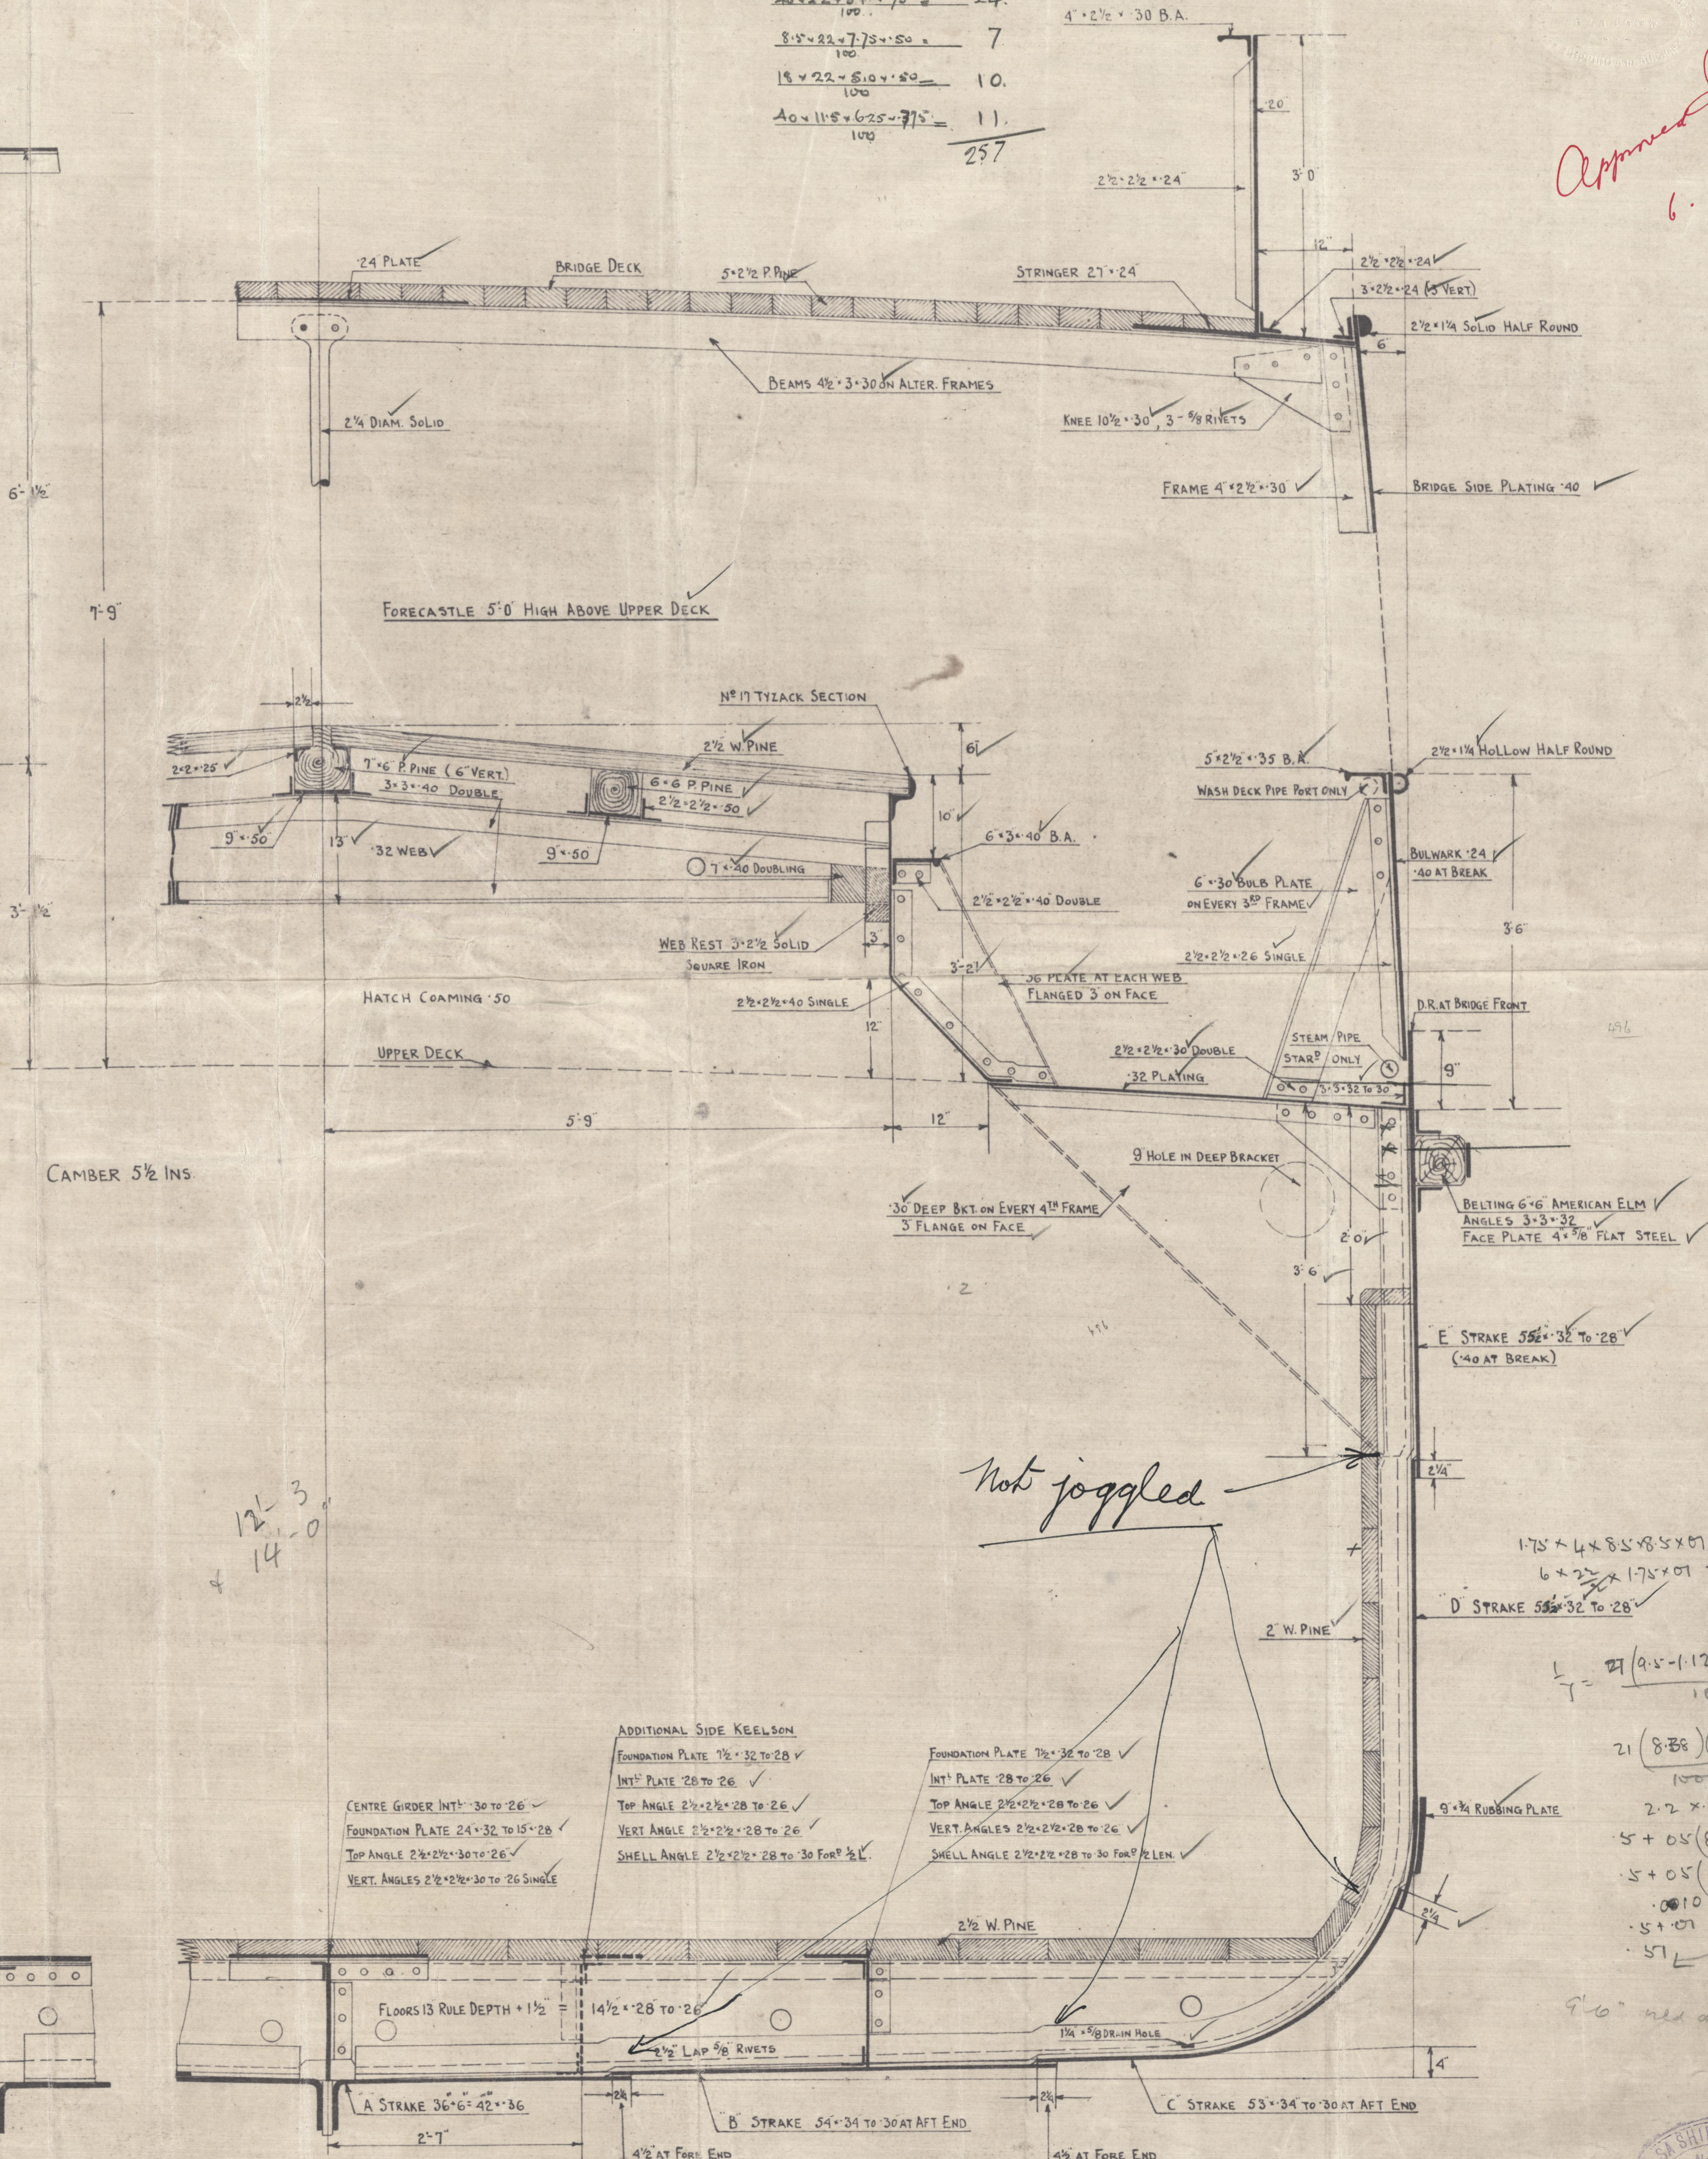

A, B AND C STRAKES .44 THICK FROM FOR^D 1/2 LEN. TO STEM

SECTION THRO' HOLD (LOOKING FOR^D)

Bag.

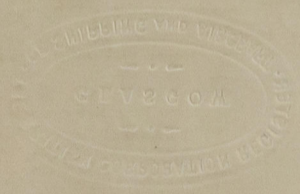

© 2020

Lloyd's Register
Foundation

7.3EAS



© 2020

Lloyd's Register
Foundation

1
A. 140
B. 38

Mids hip Section

Ribsa S.B. Coy.

HOH.

6.7.27.

^{5/5} "May" N.N. BALLYARDS

J. L. HOH. 8. 27.

RETAIN



© 2020

Lloyd's Register
Foundation

002051-002061-0058