

TO CLASS 100 A.I. STEEL. LONG POOP ^{BRIDGE} & FORECASTLE

PROPORTIONS.

BREADTH TO LENGTH 6.38

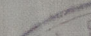
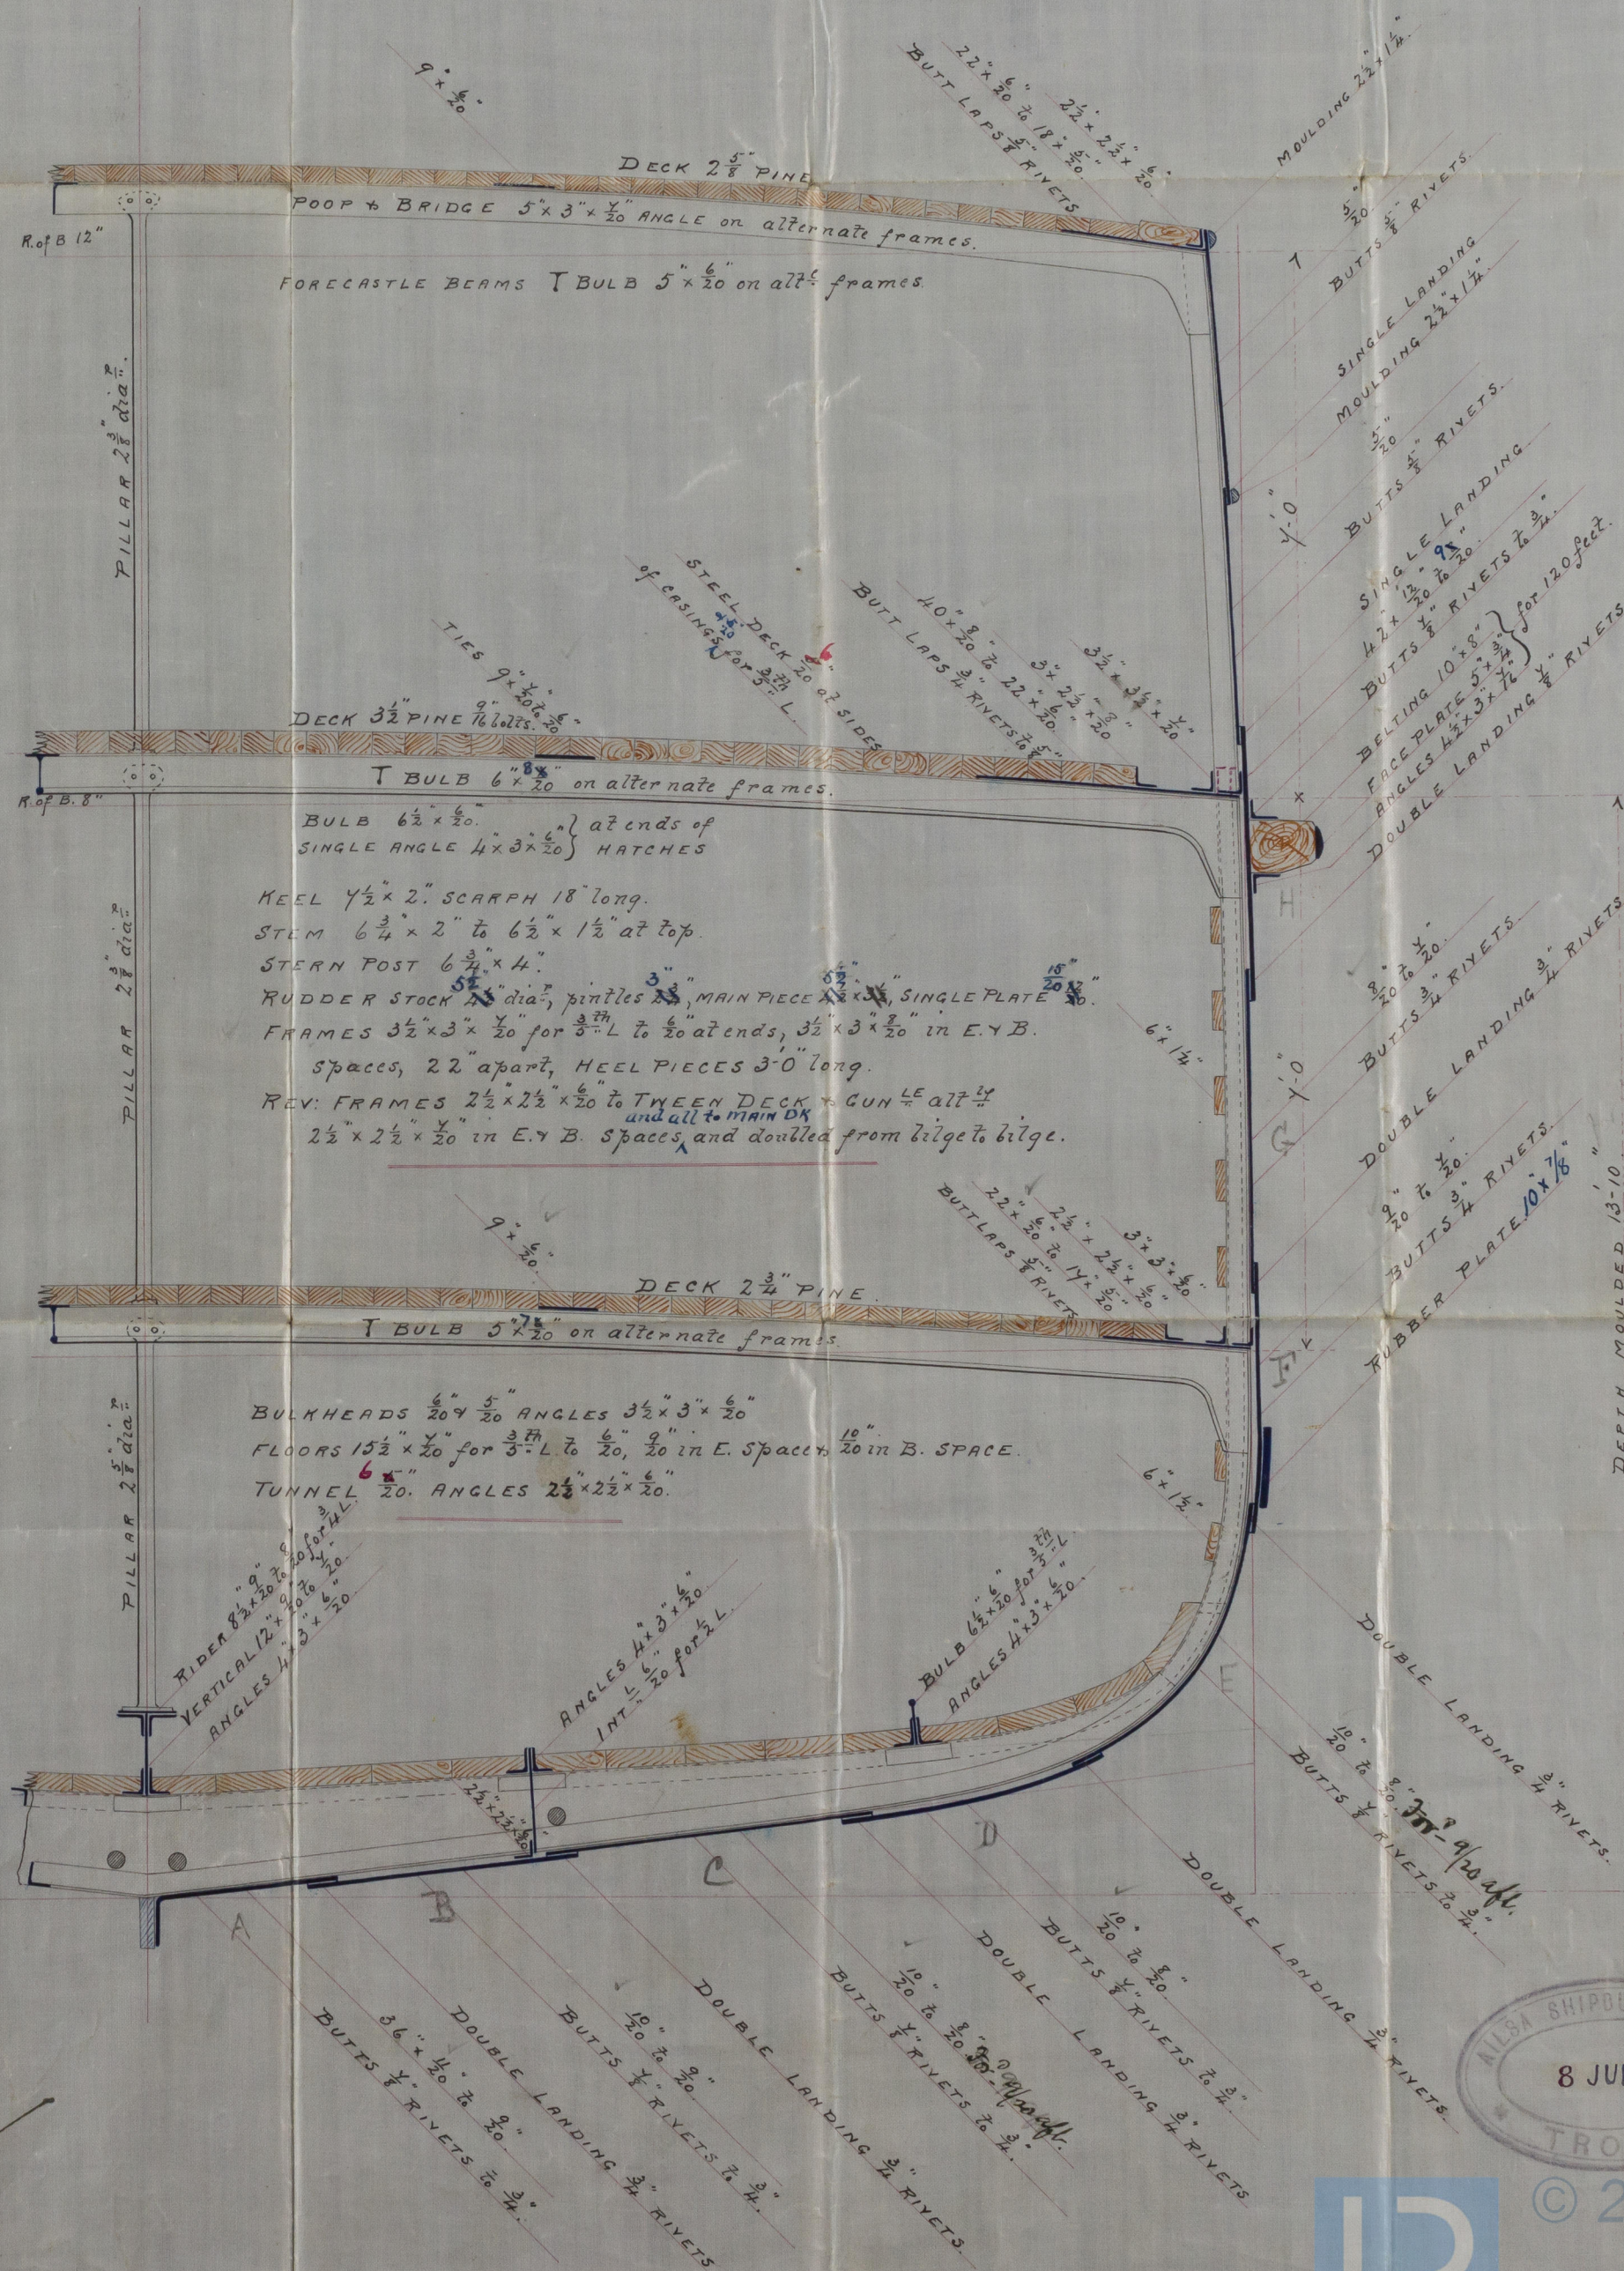
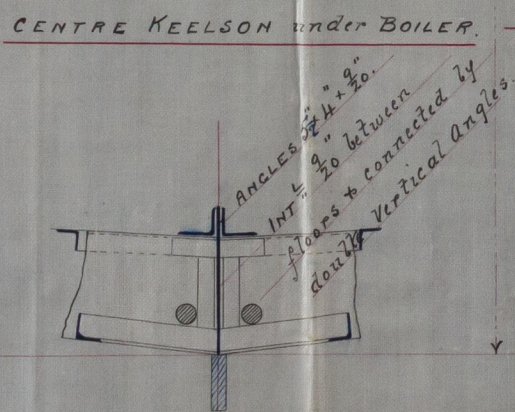
DEPTH 12.4

EQUIPMENT.

2 BOWER ANCHORS 12 cwt. EX STOCK } COLL^V W^I OF { 15 cwt. STOCKLESS } COLL^V W^I
1 ~~~~~ 10½ ~~~~~ } 34½ cwt. { 12½ ~~~~~ } 42½ cwt.
1 STREAM ~~~~~ 4 ~~~~~ .
1 HEDGE ~~~~~ 2 ~~~~~ .
195 FATHOMS 1¾" STUD CHAIN CABLE.
60 ~~~~~ ⅞" STREAM CHAIN (MIN WT. STUD 20:1:11) OR 3" STEEL WIRE.
75 ~~~~~ 8½" TOWLINE OR 2½" STEEL WIRE.
90 ~~~~~ 6½" HAWSER.

KEEL, STEM, & STERN POST 1" RIVETS, 5" CENTRES.
 RUDDER $\frac{7}{8}$ " RIVETS 4 $\frac{3}{4}$ " CENTRES.
 FRAMES $\frac{3}{4}$ " RIVETS 5 $\frac{1}{4}$ " CENTRES for $\frac{3}{4}$ " L, $\frac{5}{8}$ " RIVETS at ends,
 4 $\frac{1}{2}$ " CENTRES, Thro' FRAME & SHELL $\frac{1}{2}$ " RIVETS, 5 $\frac{1}{4}$ " CENTRES.
 BEAMS, Thro' STRINGERS & TIES $\frac{3}{4}$ " RIVETS 5 $\frac{1}{4}$ " CENTRES,
 & Thro' deck plating $\frac{5}{8}$ " RIVETS 4 $\frac{3}{4}$ " to 5" CENTRES.
 BUTT LAPS of MAIN STRINGER & IRON RIVETED for $\frac{1}{2}$ " L, all other
 butt laps of STRINGERS & TIES double riveted, BUTT LAPS
 of DECK PLATING single riveted.
 LANDINGS of DECK PLATING single $\frac{5}{8}$ " RIVETS.
 LANDINGS of low-edge of SHEER STRAKE 5 $\frac{1}{4}$ " = double $\frac{7}{8}$ " RIVETS 5 in
 space, remainder of SHELL LANDINGS 4 $\frac{1}{2}$ " = double $\frac{3}{4}$ " rivets,
 6 in space, Sides of POOP & FORECASTLE 2 $\frac{1}{2}$ " LANDINGS = single
 $\frac{5}{8}$ " rivets.
 BUTTS of SHEER STRAKE & 2 BILGE STRAKES to be $\frac{3}{4}$ " thicker
 and IRON RIVETED for $\frac{1}{2}$ " L, all other SHELL BUTTS to be
 double riveted. with butt straps.
 CENTRE KEELSON VERTICAL PLATE BUTT LAPS IRON $\frac{3}{4}$ " RIVETS
 $\frac{1}{2}$ " LAP, RIDER PLATE BUTTS IRON RIVETED, all other
 KEELSONS $\frac{5}{8}$ " RIVETS.

NOTE. RIVETS in BUTTS of OUTSIDE PLATING & STRINGERS
spaced not more than $3\frac{1}{2}$ dia^{rs} apart.

A circular purple ink stamp. The outer ring contains the text "AILSA SHIPBUILDING CO." at the top and "TROON." at the bottom, separated by two small stars on the left and right. In the center of the stamp, the date "8 JUNE 97" is stamped in a bold, sans-serif font.

8 JUNE 87



002051-002061-0204

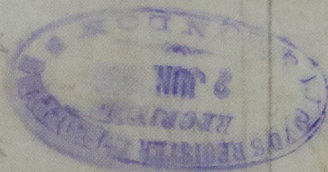
L 70



S.S. "Hebrides"

GLASGOW No. 161347

M 3



© 2020

Lloyd's Register
Foundation

002051-002061-0204