


11. 12.07
18. 1.08
25. 1.08

S. S. N° 406

Dims 19'-0" B.P. x 29'-11" x 13'-7" M.L.D.

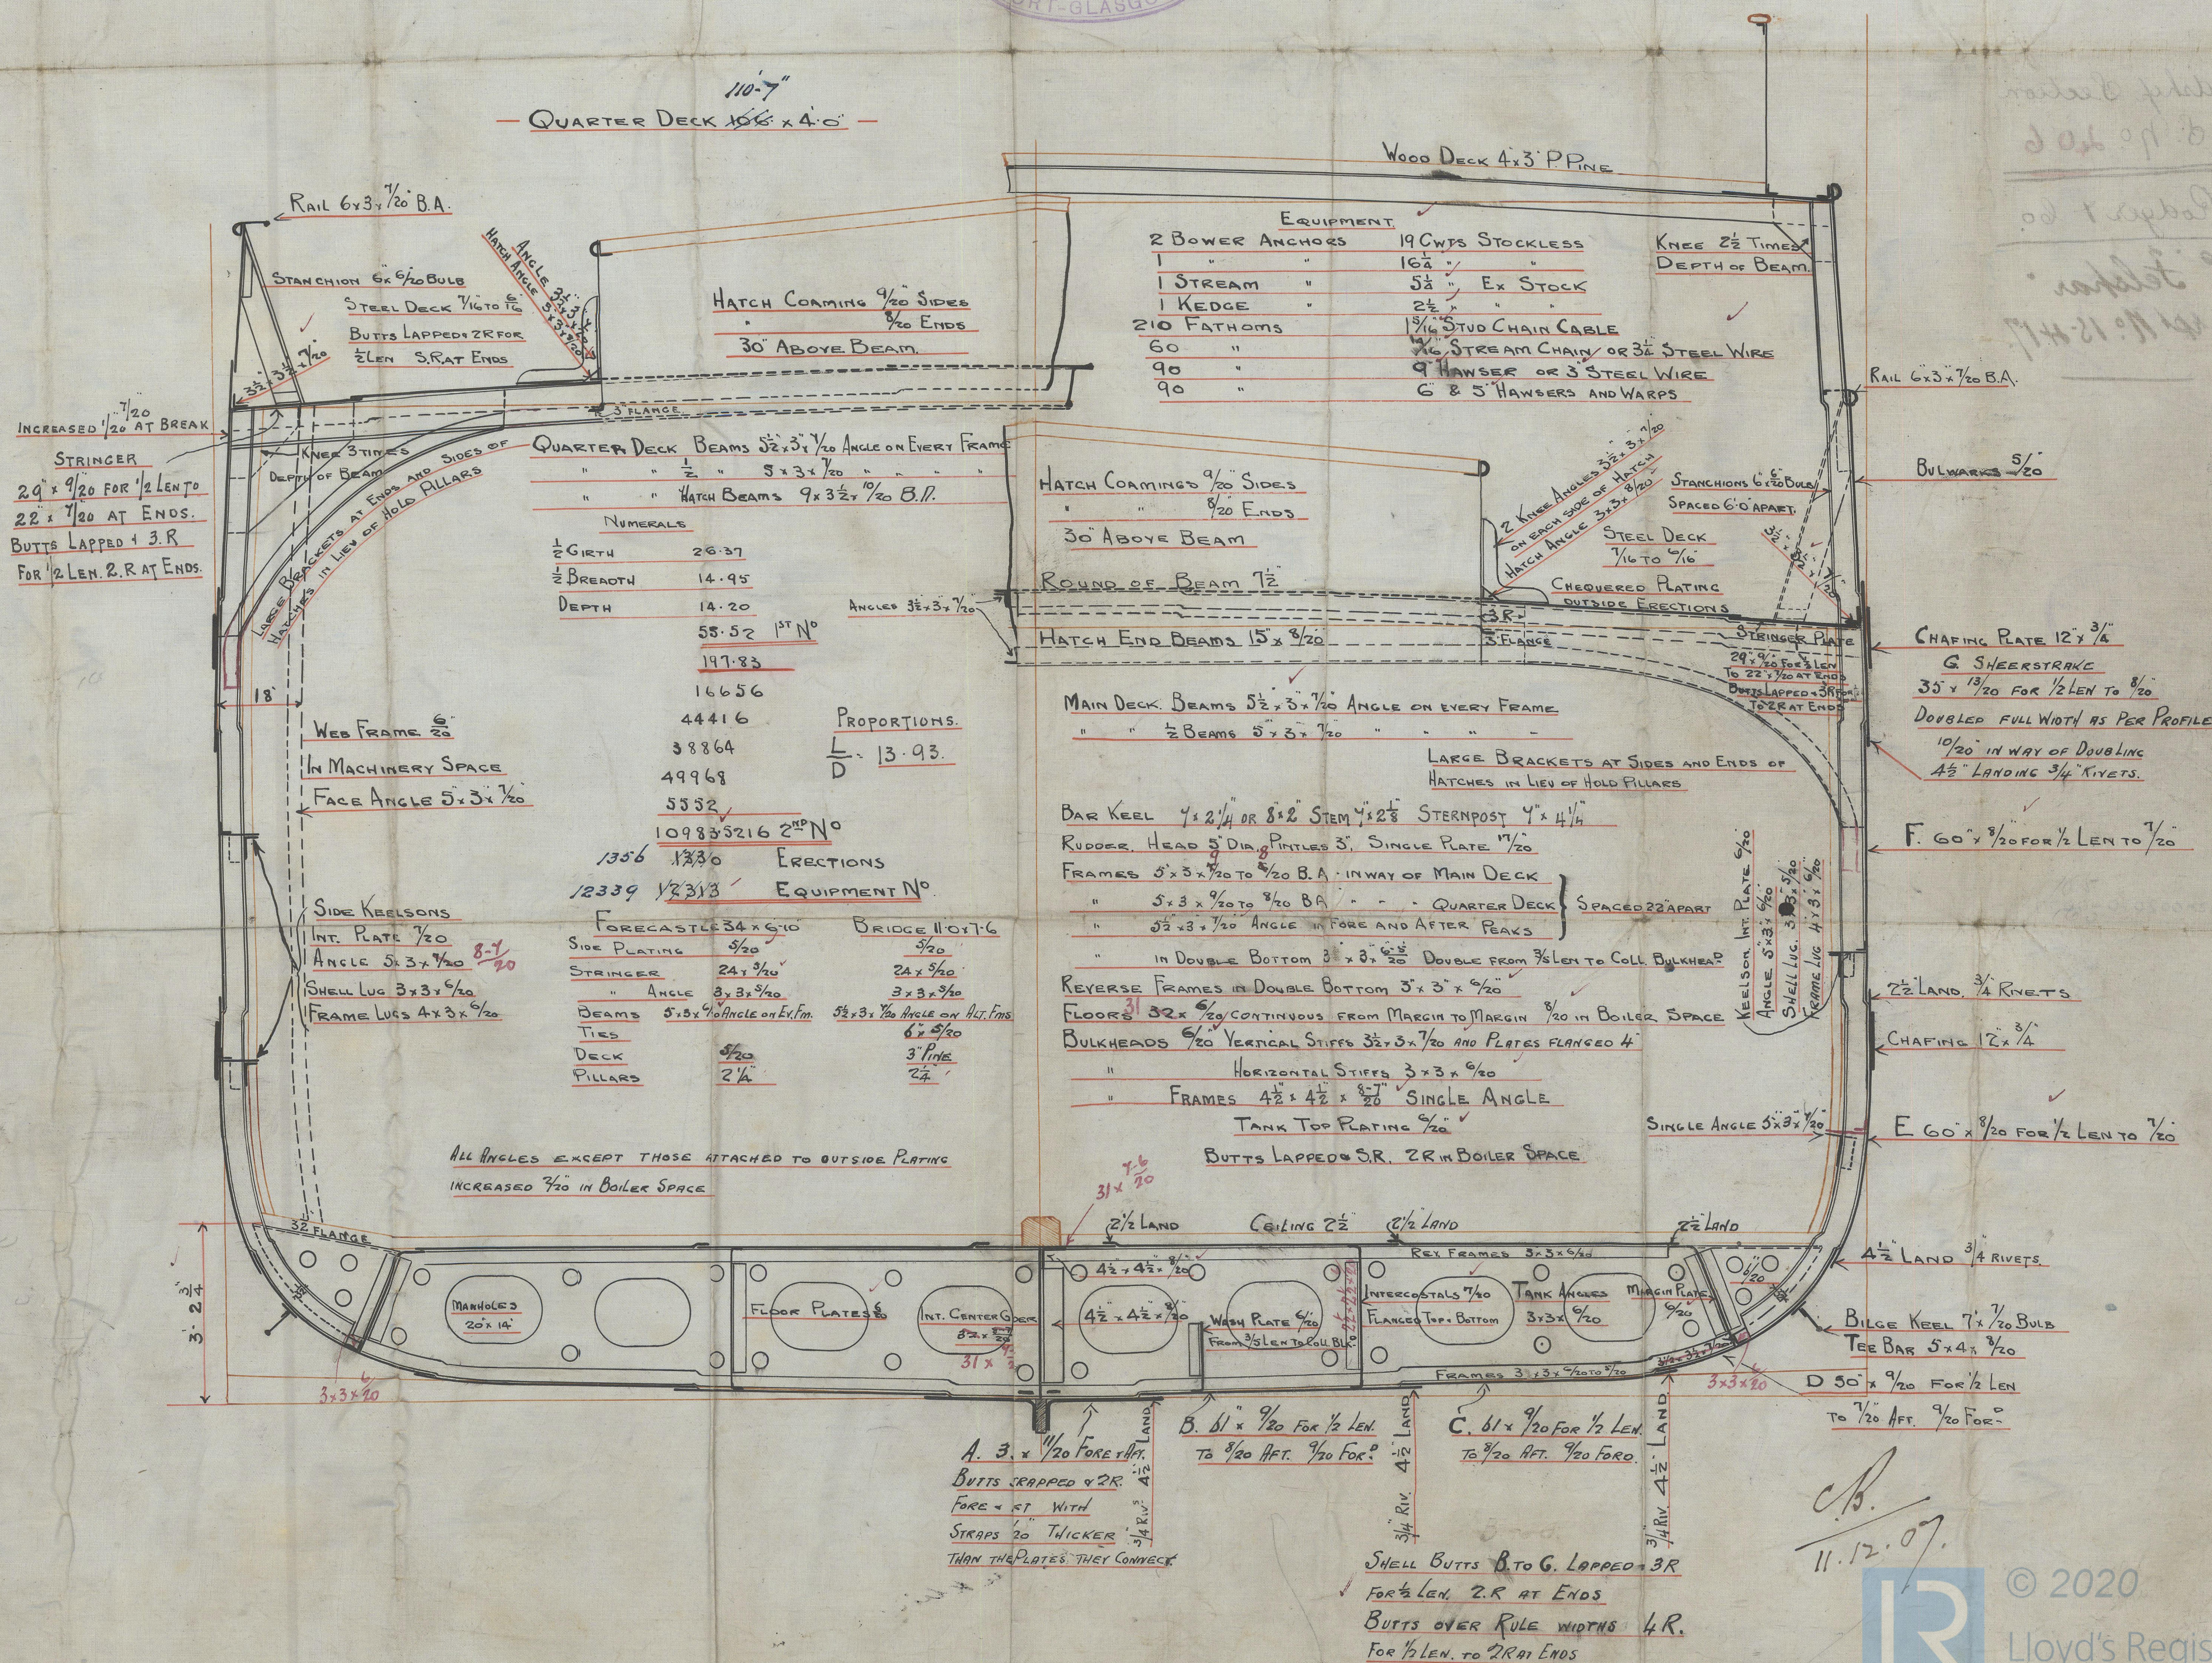

002062-002070-007

Midship Section
S.S. No. 406

A. Rodger & Co.

L.S. Felspar
Grk up No. 15-417.

© 2020

Lloyd's Register
Foundation

002062-002070-0077