

6/3/14


CLASSED 100 A.I. LLOYDS.

LLOYDS DIMENSIONS & NUMERALS.

| MAIN DECK | | QPR. DECK | |
|----------------------------------|--------|----------------------------------|------|
| LENGTH. | 28 | PARADETH | 28 |
| DEPTH. | 12.5 | DEPTH | 16 |
| 1 st N ^o . | 40.5 | 1 st N ^o . | 40 |
| LENGTH. | 175 | LENGTH | 175 |
| 2 nd N ^o . | 7087.5 | 2 nd N ^o . | 7700 |

- EQUIPMENT. - (i.) -

| | |
|--------------------------------|----------|
| LONGITUDINAL No. | 7087-5 |
| QUARTER DK. 101 x 3-5 | 353-5 |
| BRIDGE DK. 11 x 7-0 = 3/4 | 57-75 |
| FORECASTLE DK. 26 x 6-25 = 3/4 | 121-875 |
| SEA CABINING. 42 x 7-1/2 | 154-0 |
| EQUIPMENT No. | 7767-625 |

EQUIPMENT No. 7767-625

| | | |
|---------------------------------|-----------------------|----------------------------------|
| ✓ 2 POWER ANCHORS. (STOCKLESS) | 14 1/2 CWTs | } COLLECTIVE WEIGHT 41 3/4 CWTs. |
| ✓ 1 " " " | 12 1/2 " " | |
| ✓ 1 STRAM " " | (EX. STOCK) 4 1/2 " " | |
| ✓ 1 KEGGE " " | 2 " " | |
| ✓ 165 FATHOMS 1 3/4" STUD CHAIN | CABLE. MIN. WT. | 14 CWT. 0 QOS. 16 LBS. |
| ✓ 80 " " 3" STEEL WIRE | | |
| ✓ 75 " " 2 3/4" S.W. TOWLINE | | |
| ✓ 90 " " 6 HAWSER. | | |

- RIVETING -

| | | | |
|----------|--|----------------------------|----------------|
| BUTTS OF | SHEER STRAKE STRAKE BELOW AND STRAINER PLATE | TR FOR $\frac{1}{2}$ L TO | DR. AT ENDS. |
| " " | OUTSIDE PLATING FROM KEEL TO UPPER TURN OF BILGE | | DR. THROUGHOUT |
| " " | " " " " BILGE TO STRAKE BELOW SHEER STRAKE | | DR. " |
| " " | CENTRE GIRDER | | DR. " |
| " " | MARGIN PLATE | | DR. " |
| " " | MIDDLE LINE STRAKE IN DOUBLE BOTTOM | | DR. " |
| " " | DECK PLATES | DR. FOR $\frac{1}{2}$ L TO | SR. AT ENDS. |
| " " | DOUBLE BOTTOM PLATING. | DR. " " | SR. " |

| EDGES OF SHEER STRAKE | | DR. |
|-----------------------|--|------|
| " | " OUTSIDE PLATING FROM KEEL TO BILGE | DR. |
| " | " " " " " BILGE TO STRAKE BELOW SHEER STRAKE | S.R. |
| " | " DECK PLATING. | S.R. |
| " | " " DOUBLE BOTTOM PLATING | S.R. |

SCANTLINGS

KEEL ^{8"} 74" x 1 1/2" SCARPH. 17" LONG ✓

STEM ^{8"} 74" x 1 1/2" P.P. 5 3/4" x 4" P.P. 6 1/4" x 4" ✓

FRAMES, SPACED 22" APART

MAIN DECK. ^{5 1/2" x 30" HULL} 44" x 5 3/4" S.P. 14 BEAMS 4" x 3" x 36" ✓

GR. DECK ^{11 1/2" x 5 1/2" x 30" HULL} 52" x 3" x 36" S.P. - " 4" x 3" x 36" ✓

BEAMS ON MAIN GR. DECKS 5" x 3" x 34 S.P. ✓

" BRIDGE DECK 4 1/2" x 3" x 34 S.P. ALT. FRS.

" FOIL DECK 6 1/2" x 3" x 40 S.P. ALT. FRS. ^{4 1/2"} REDUCED AT ENDS.

HALE BEAMS 5" x 3" x 30" S.P. ✓

BEAM KEEELS 16" x 30" FOUR 3/4" RIVETS

FLOORS 17" DOUBLE BOTTOM 28

OUTSIDE DB. 17 1/2" x 32" 28" IN B.P. 42" IN E.P. 36"

NOTE:

FRAMES 9 OUTSIDE PLATING
INCREASED AS SHOWN IN
LIEU OF SIDE STRINGER.

BRIDGE DECK.

- ✓ BEAMS $4\frac{1}{2} \times 3 \times 36$ SA ON ALT. FRS. KNEELS $12'' \times 30''$.
- ✓ STRINGER PLATE $30'' \times 26''$ ✓ TIE PLATES $7'' \times 26''$.
- ✓ STRINGER ANGLE $3 \times 3 \times 26''$ ✓ GUTTER ANGLE $2\frac{1}{2}'' \times 2\frac{1}{2}'' \times 26''$.
- ✓ WOOD DECK $5'' \times 2\frac{1}{2}''$ PP SIDE PLATING $26''$.
- FORECASTLE DECK.
- ✓ BEAMS $6\frac{1}{2} \times 3 \times 40$ PA ON ALT. FRS. REDUCED AT ENDS.
- ✓ STRINGER PLATE $16'' \times 26''$ ✓ TIE PLATE $7'' \times 26''$ ✓
- ✓ STRINGER ANGLE $3 \times 3 \times 26''$ ✓ GUTTER ANGLE $2\frac{1}{2}'' \times 2\frac{1}{2}'' \times 26''$.
- ✓ WOOD DECK $5'' \times 2\frac{1}{2}''$ PP SIDE PLATING $26''$.

BRACKET.
FLANGED.
CONNECTION
3" x 3"

© Lloyd's Register Foundation

Anderson D.D. & S.B. Co. Ltd.

S.S. Nos. 261/2.

Midship Section




N^o 261 $\frac{1}{2}$ Fairmair

GLASGOW REPORT No. 34941

N^o 262

$\frac{1}{2}$ Fairmair

GLASGOW REPORT No. 35049

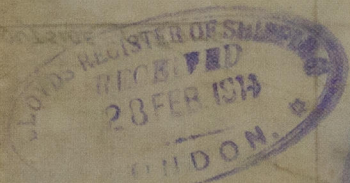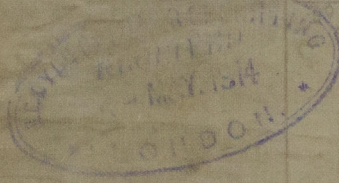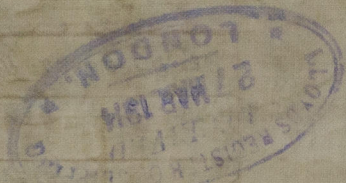

© 2020

Lloyd's Register
Foundation

002062-002070-0117