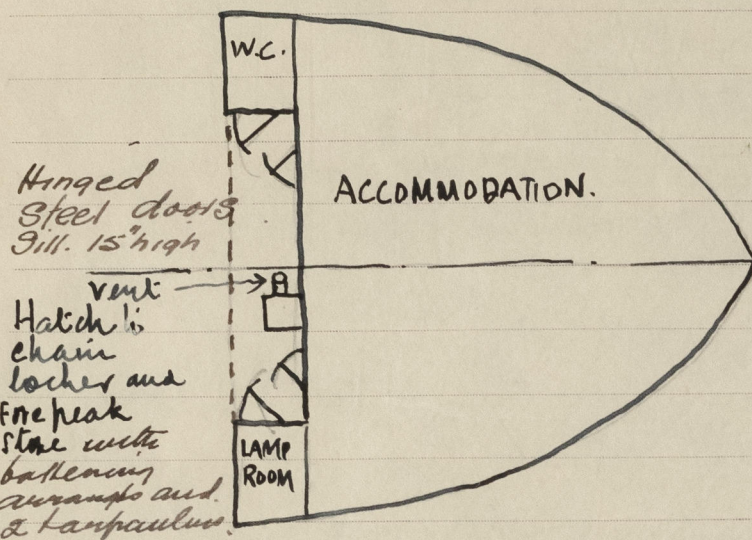


Lloyd's Register of Shipping.

Ship's Name YEW GLEN. N.N. HOLDERNESS Official No. 137788.Memorandum of alterations reported since ship was surveyed for assignment of Load Lines in May 1932.

Now fitted.


New steel bulkhead: 30" plating 3" x 3" x 30" stiffers.

2-6" dia. ventilators to accommodation at 36" dia. height

1-6" dia. vent. to peak stow.

Discharge from W.C. fitted with N.R.V.

Efficient closing appliances fitted to new vents.

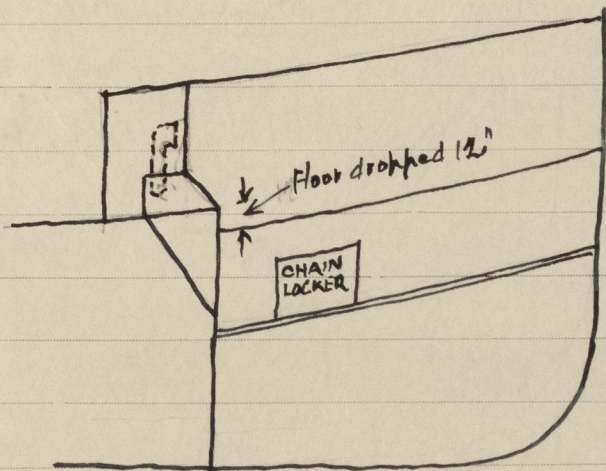

Noted

12/12/41