


10-10-10 (10-10-10)  


# 5/5 YEW GLEN

## NEW FORECASTLE ARRANGEMENT


1/4" SCALE

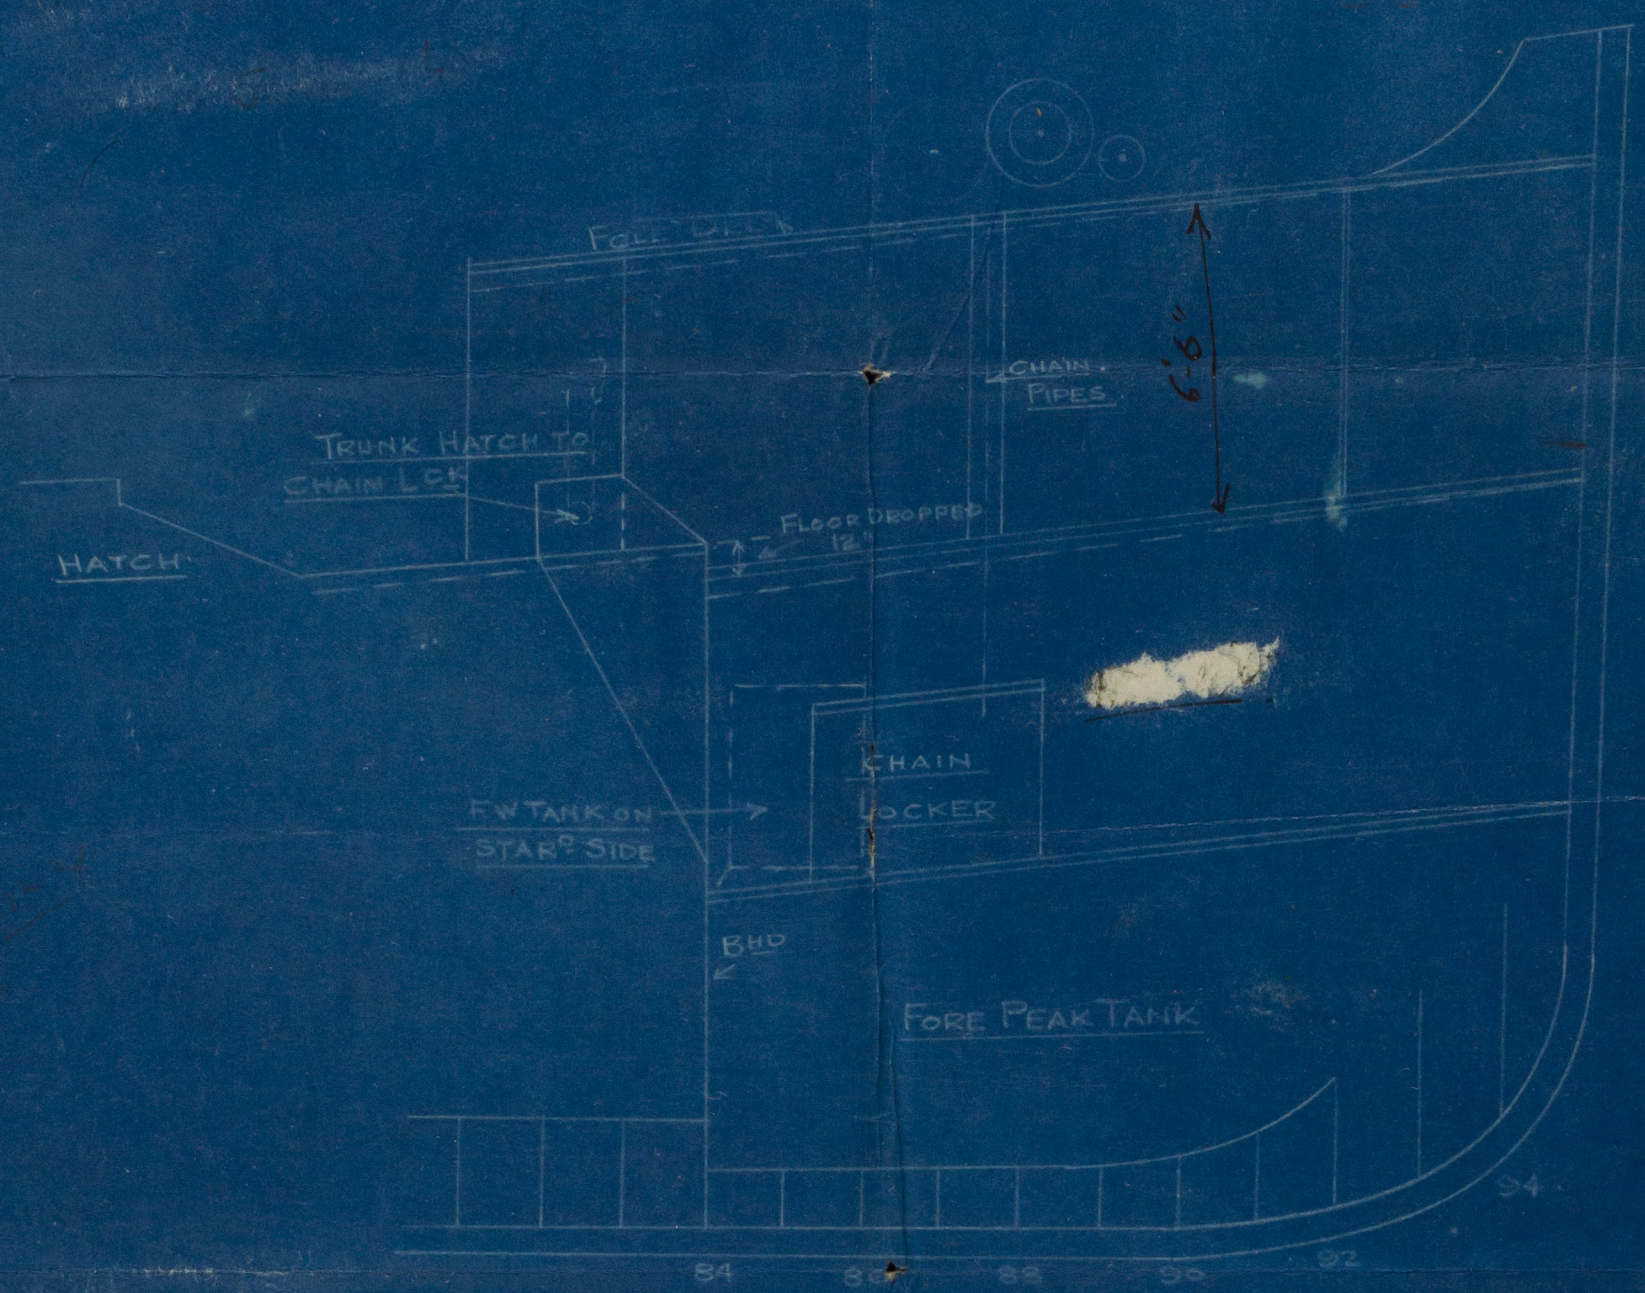

NOTES: F&A Bulkheads separating Firemen & Seamen & Gunners & Firemen to have VENT slots between beams covered with expanded metal. ALL FIBRE on ships side & under side of DECK in living spaces to be covered with COCK PAINT.

ADDITIONAL:-  
 2-6" VENTS - to accom"  
 1-6" VENT to water to keep store.

FELE BHD. 30  
 STIFFERS 3x3x30L  
 HAWSE PIPE at 36" apart.

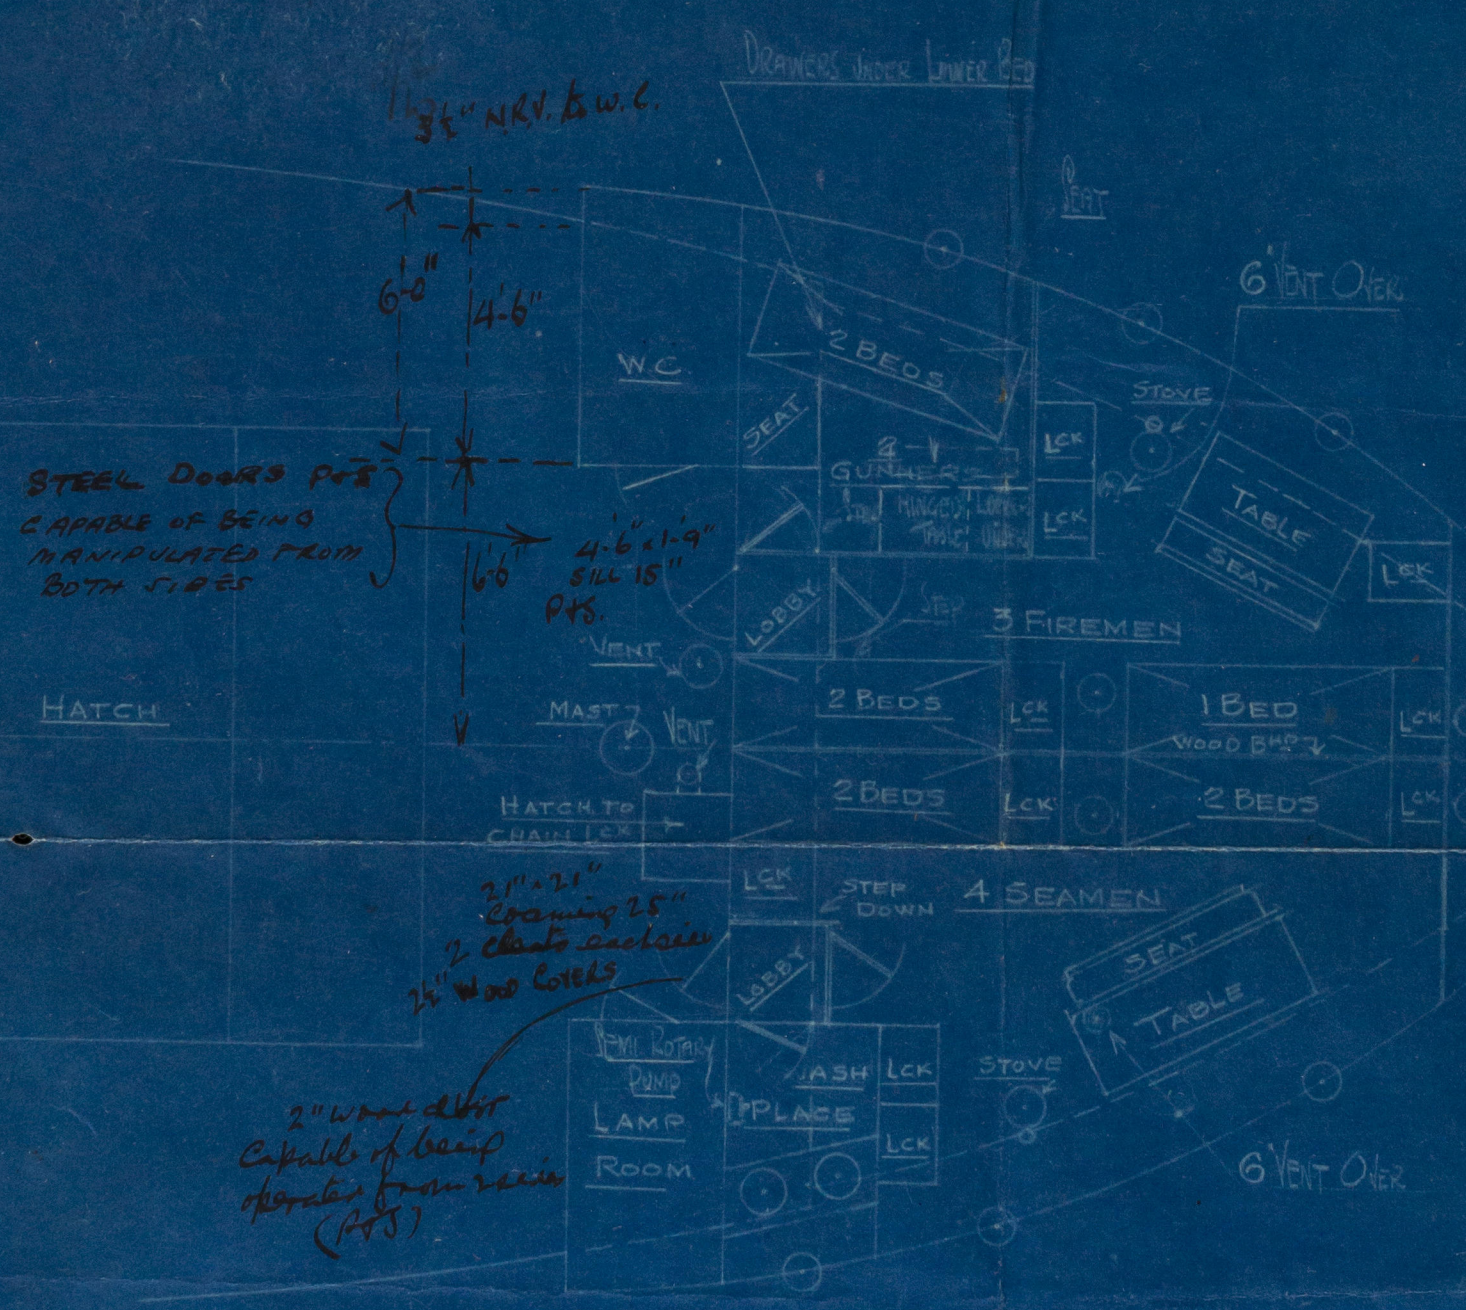

THE TYNE DOCK ENGINEERING CO LTD  
 THRIPT STREET  
 SOUTH SHIELDS



002067-002070-0140



Thogden

Amendments to  
Feb. Accoun.  

---



© 2020

Lloyd's Register  
Foundation

002062-002070-0140