
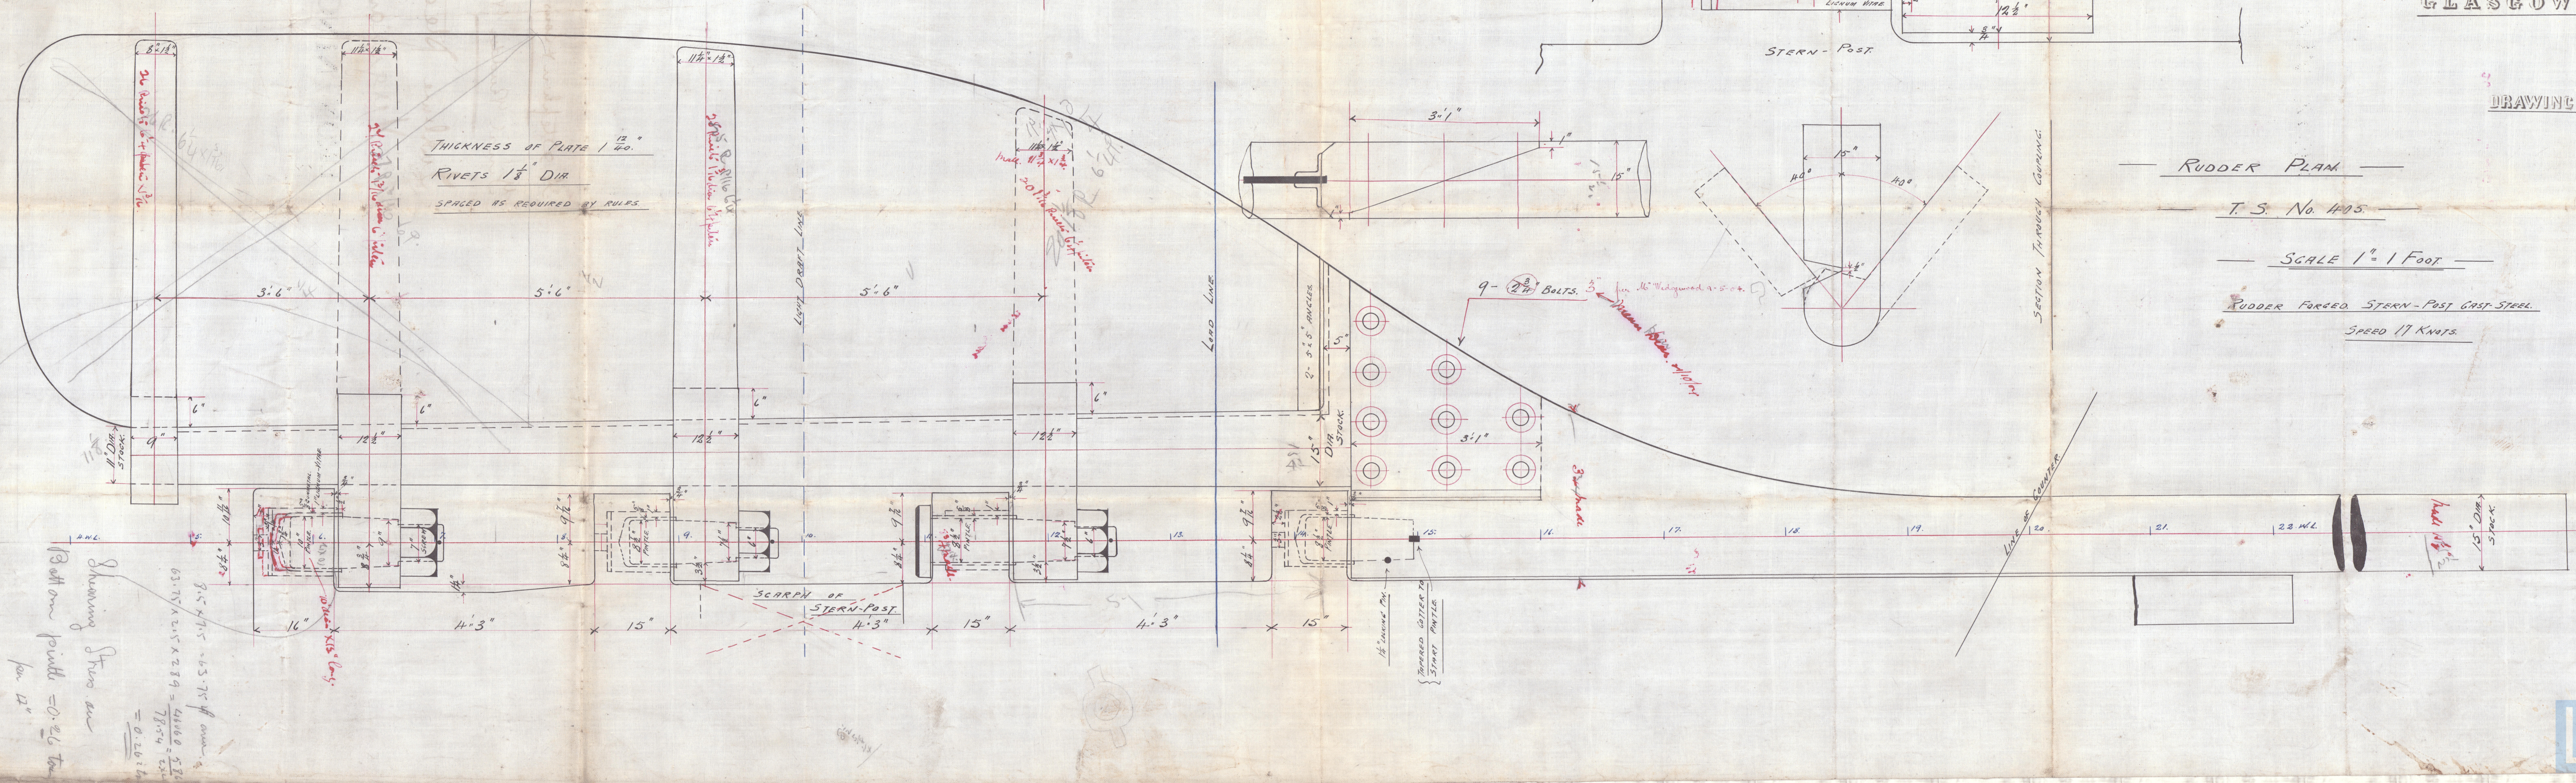


Approved 
See Letter 8. 2. 14

Alex^r. Stephen & Sons, Ltd.,
SHIPBUILDERS & ENGINEERS,
GLASGOW.

DRAWING № 3/21

4/2/04



RUDDER PLAN.

T. S. No. 405.

SCALE 1" = 1 FOOT.

PUDDER FORGED. STERN-POST CAST-STEEL.

SPEED 17 KNOTS.

© 2020
Lloyd's Register
Foundation

A. Stephen & Sons N° 405

Final Rudder Plan

Turbine Steam

"*Virginia*"

DROTTNINGHOLM



© 2020

Lloyd's Register

602071-002078-0014
Foundation