

24/11/26


Nº 1303 SHIP

STERNFRAME

SCALE 1/2" = 1 FT

TO PASS LLOYD'S TESTS FOR A VESSEL CARRYING
OIL IN RUER & TO CLASS 100A1.

TO BE OF FORGED OR CAST STEEL.

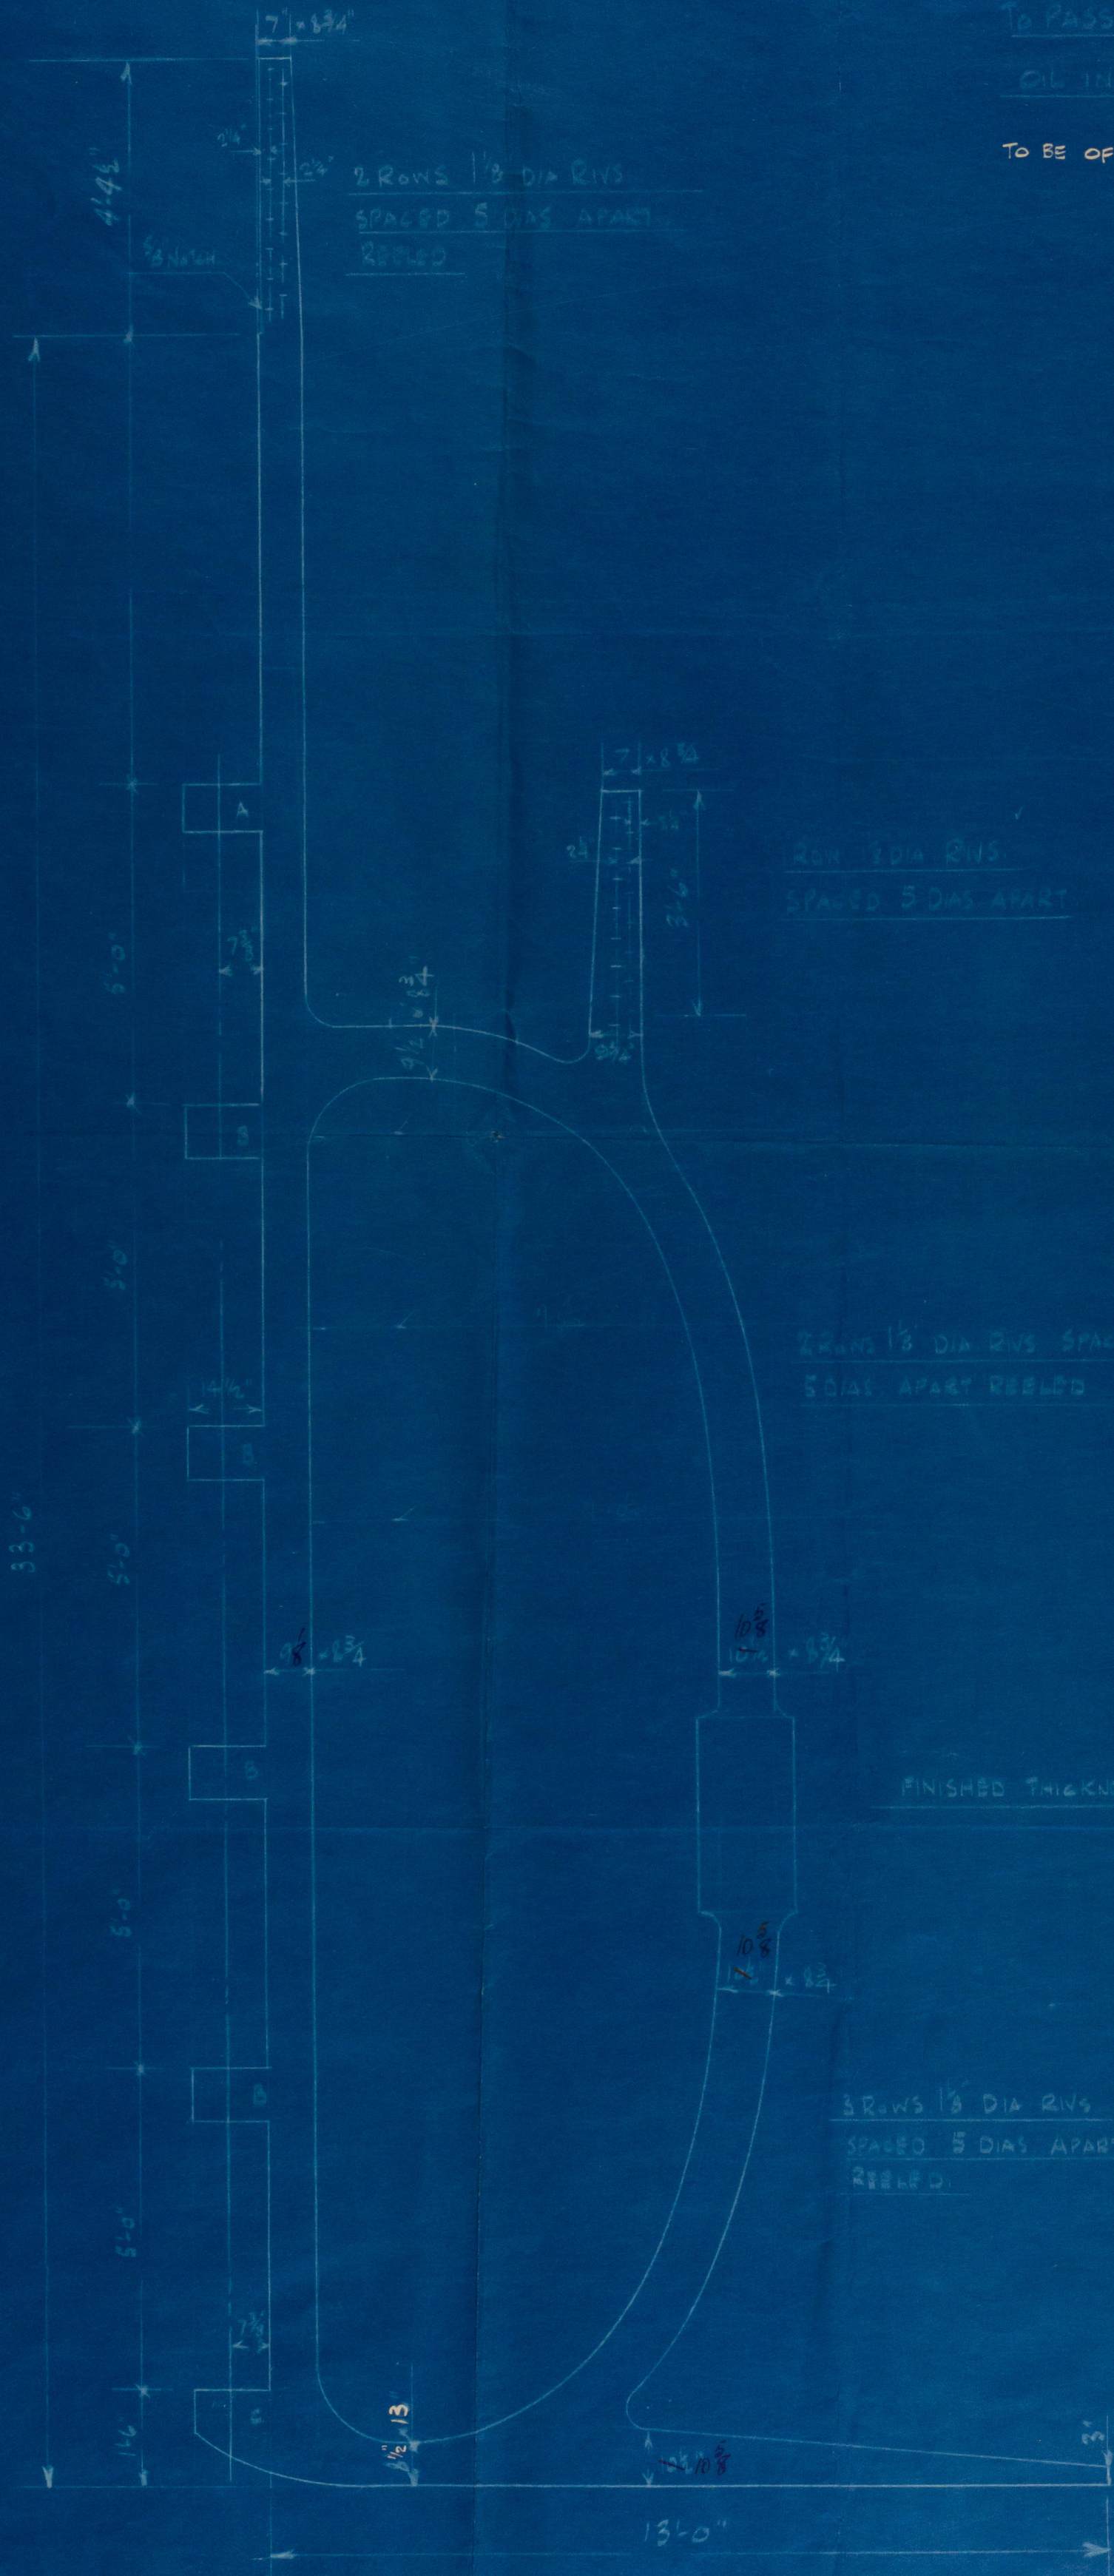

FOR DETAILS OF GUDGEONS SEE
RUDDERFRAME

FINISHED THICKNESS OF BARS - 5 1/4

664
24/11/26

(3)

Swan & Hunter.

— " —
No 1303.

— " —
Steer Frame

S.S. "Fontenac".

NEWCASTLE ON TYNE.

Report No. 82387.

S.S. "Marathon"

NEWCASTLE ON TYNE.

Report No. 85466



© 2020

Lloyd's Register
Foundation

002071-002078-0062