

8.3.04

STEEL SCREW STEAMER N<sup>o</sup> 175

MIDSHIP SECTION

SCALE 1/2" = 1 FOOT.

DIMENSIONS 132'-0" B.P. x 23'-0" M<sup>o</sup> x 10'-6" M<sup>o</sup>

TO CLASS 100 A.1. AT LLOYDS.




NUMERALS


1/2 GIRTH	20.5
1/2 BREADTH	11.5
DEPTH AS PER RULE	10.97
	$\sqrt{42.97} = 1^{ST} N^2$
	$\frac{131}{5629.07} = 2^{ND} N^2$
	$\frac{84 \times 5629}{51} = 451$
	$\frac{451}{6080.07} = EQUIR N^2$

PROPORTIONS

1/2	11.9
1/2	5.69

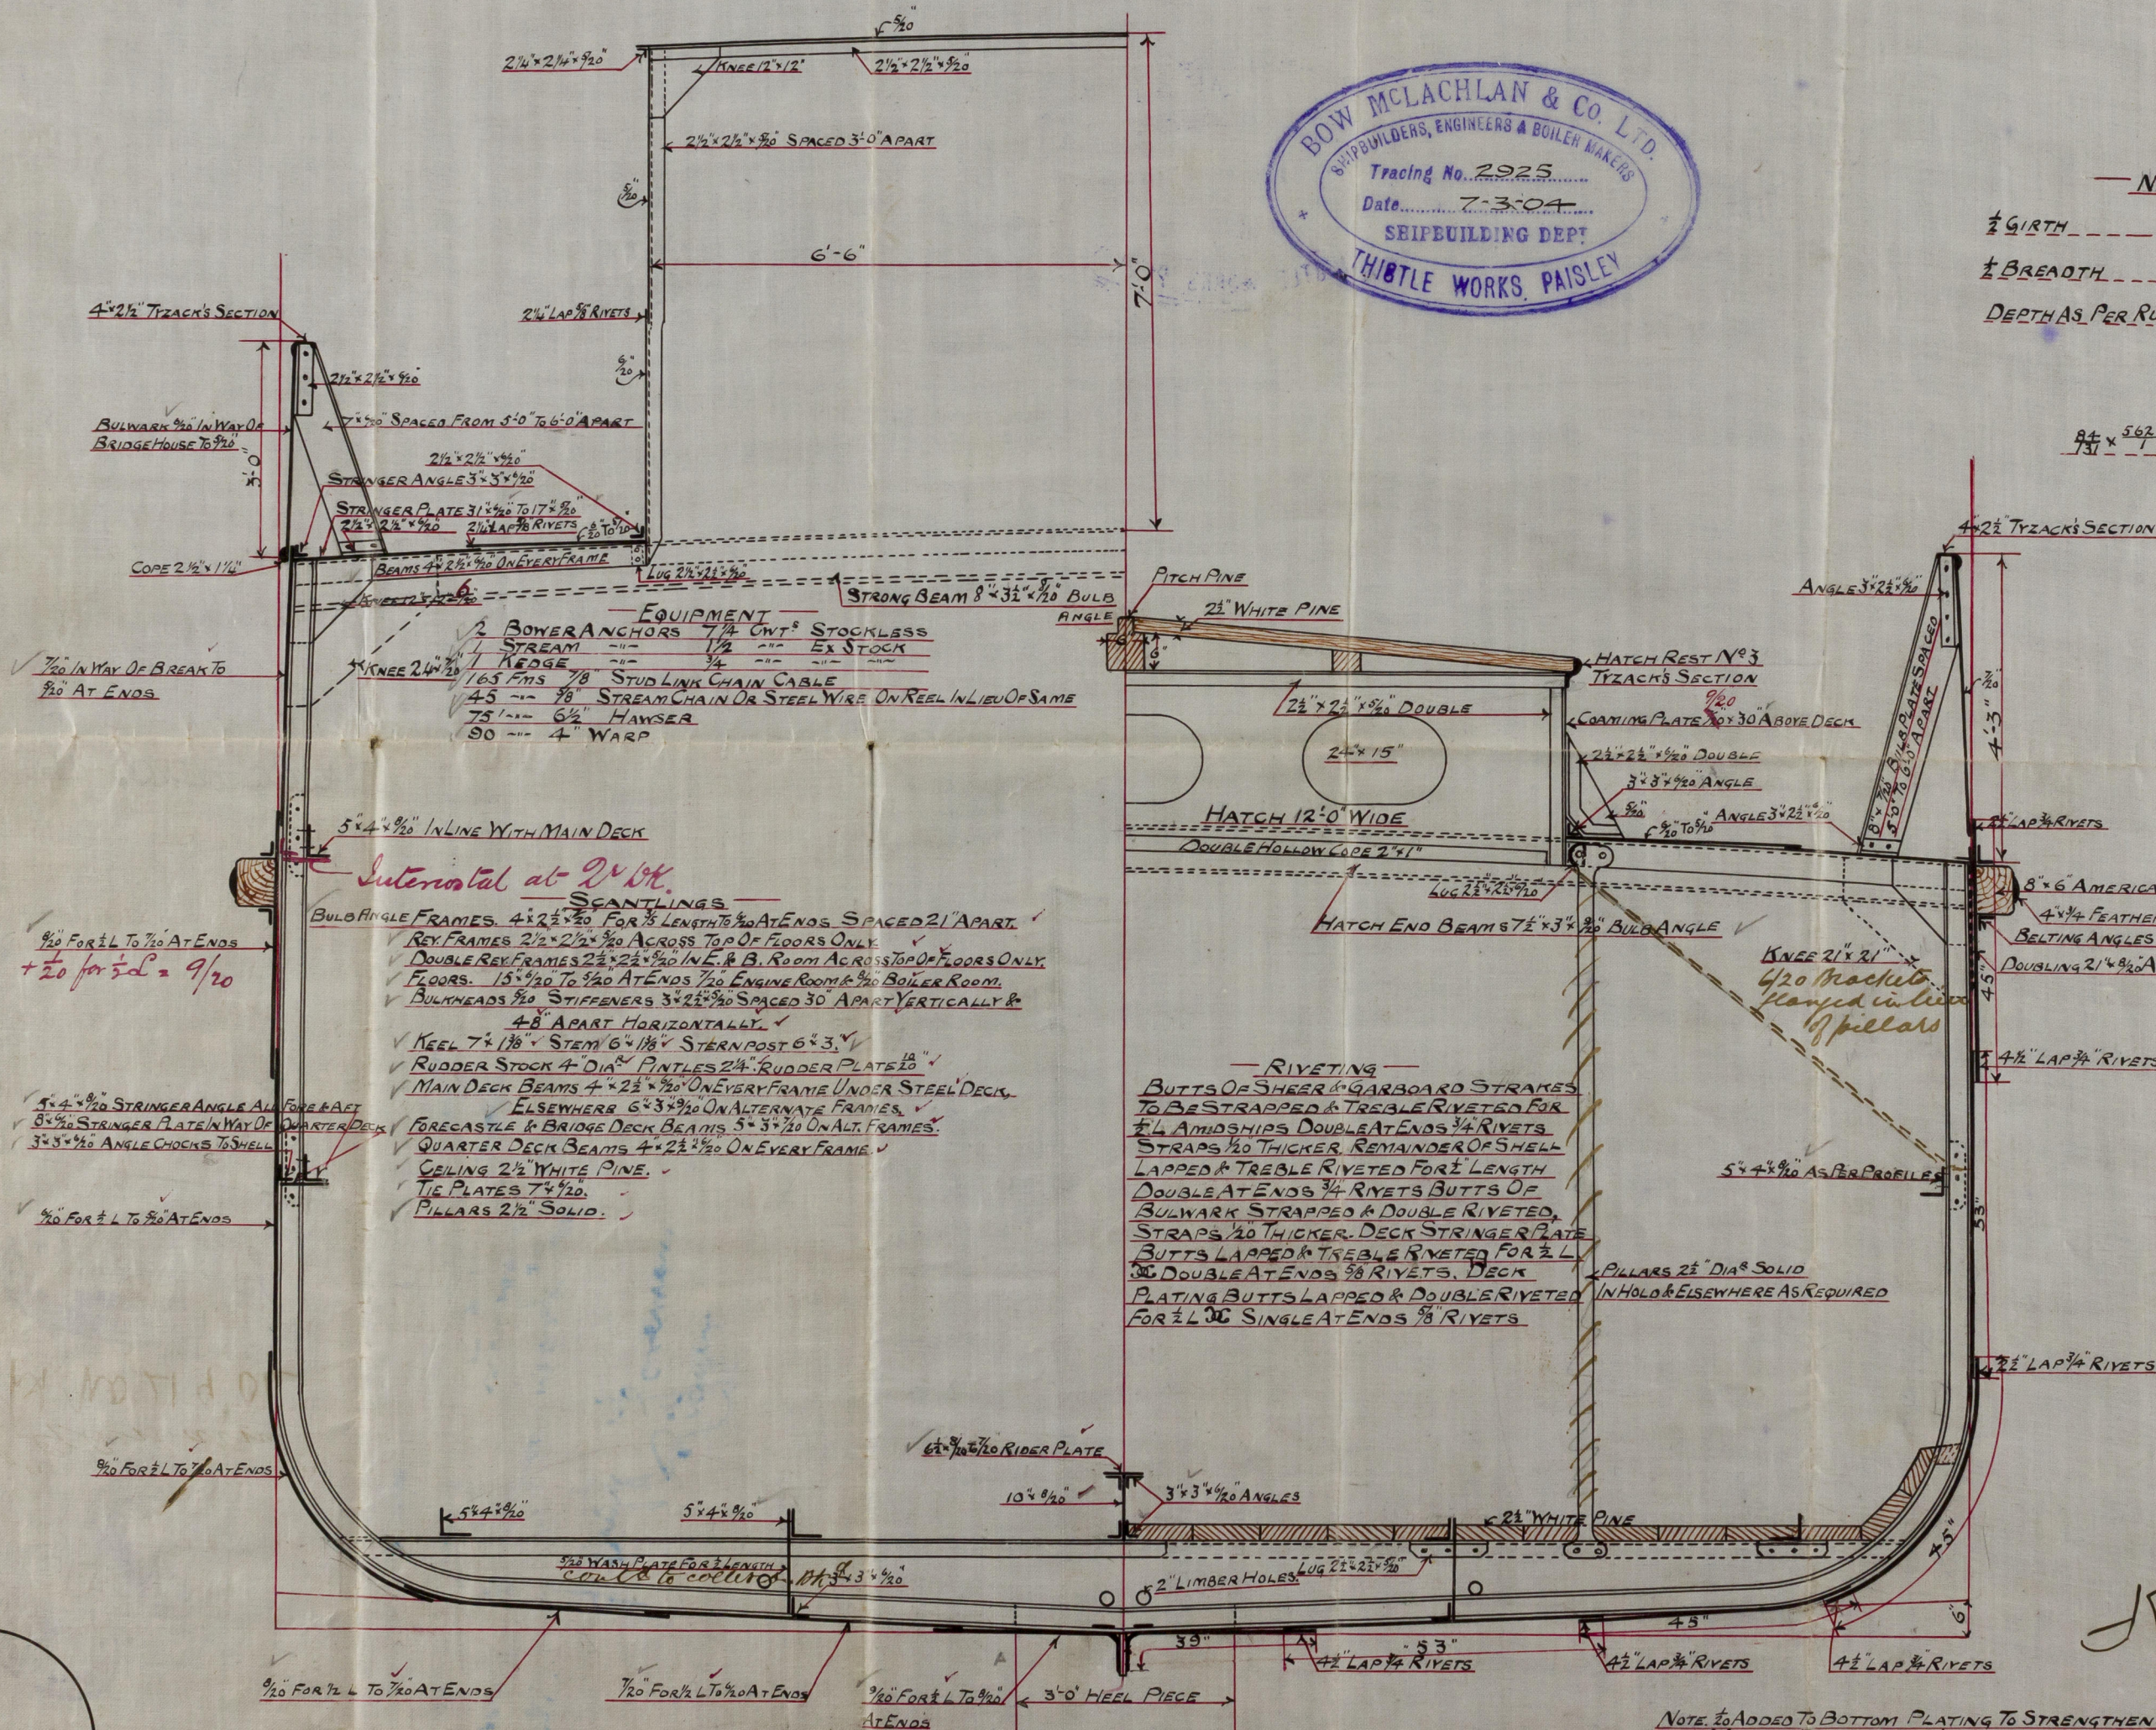

SKETCH SHOWING METHOD OF ATTACHING SIDE STRINGER TO BULW FRAME

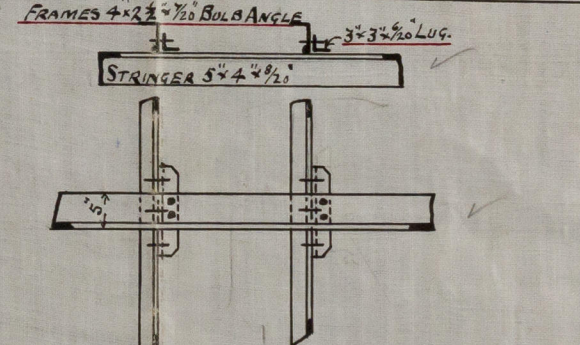

J.P.H.  
7/3/04

J.P.H.  
7/3/04

NOTE: TO BE ADDED TO BOTTOM PLATING TO STRENGTHEN VESSEL FOR LOADING OR DISCHARGING WHILE LYING AGROUND




Thos Bro M Lachlan

No 175

Indaship Section

ISLESMAN

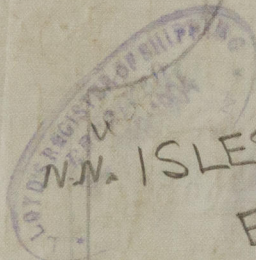


N. N. ISLESMAN

EX

S. S. "Glenarm"  
gls rkt NO 21904

ISLESMAN

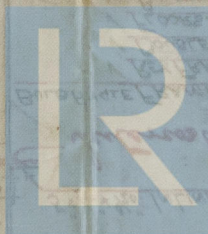

© 2020

Lloyd's Register  
Foundation

002071-002078-0079