

Lloyd's Register of Shipping.


Ship's Name ISLESMAN.Official No. 119143.

Memorandum of alterations reported since ship was surveyed for assignment of Load Lines
in _____

At a previous date the Forecastle has been closed as shown in
red below.


*Yballett
Cardiff.*

PLATING $\frac{1}{4}$ "
STIFFENERS $2\frac{1}{2}$ " X $2\frac{1}{2}$ " X $\frac{1}{4}$ " SPACING 36"
BRACKETED TOP AND BOTTOM.
 $1\frac{3}{4}$ " WOODEN DOORS 4'-0" X 2'-0"
WITH SILL 1'-6". HINGED AND
OPERATED FROM BOTH SIDES.

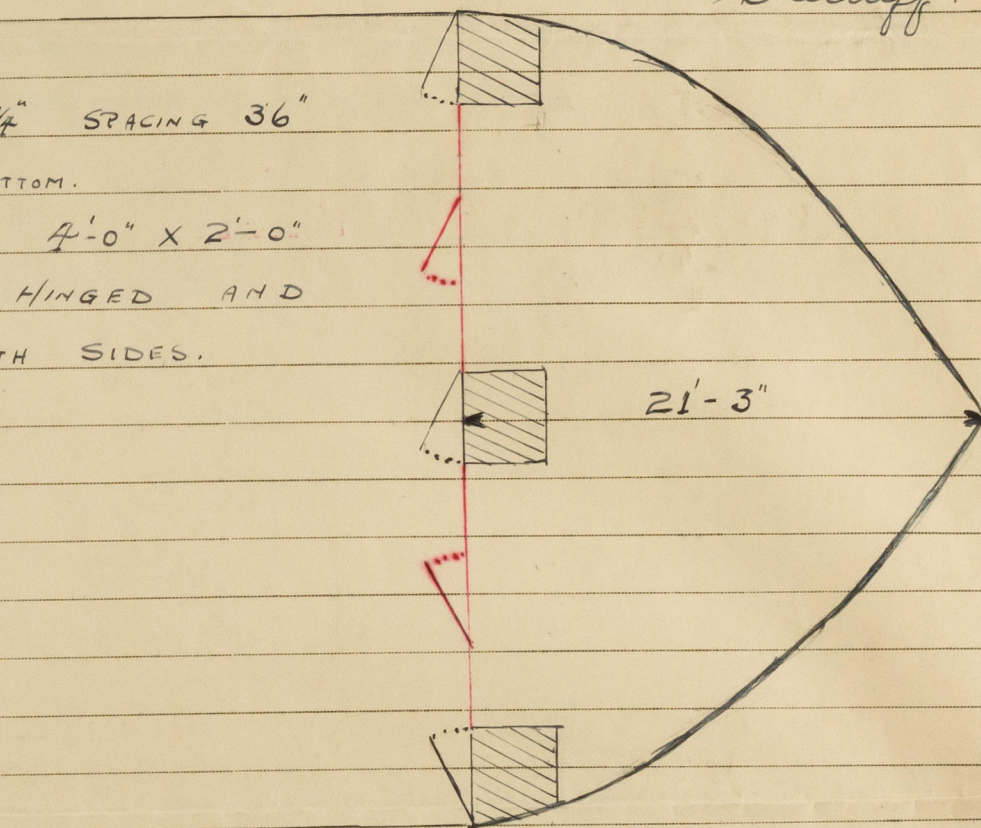

SURVEYOR TO
LLOYDS REGISTER
6 JUL 1944
CARDIFF

*Embayed
not affixed
S.B.
16.7.44*

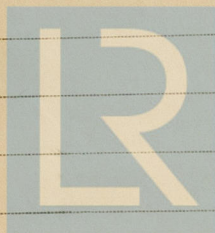

© 2020

Lloyd's Register
Foundation

002071-002078-0089