

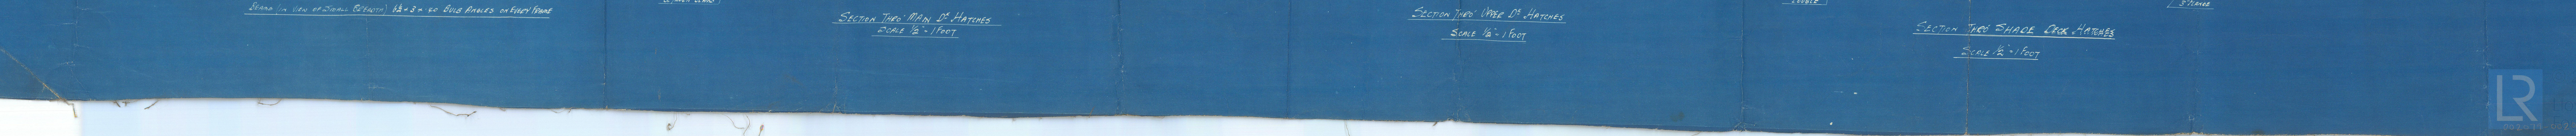
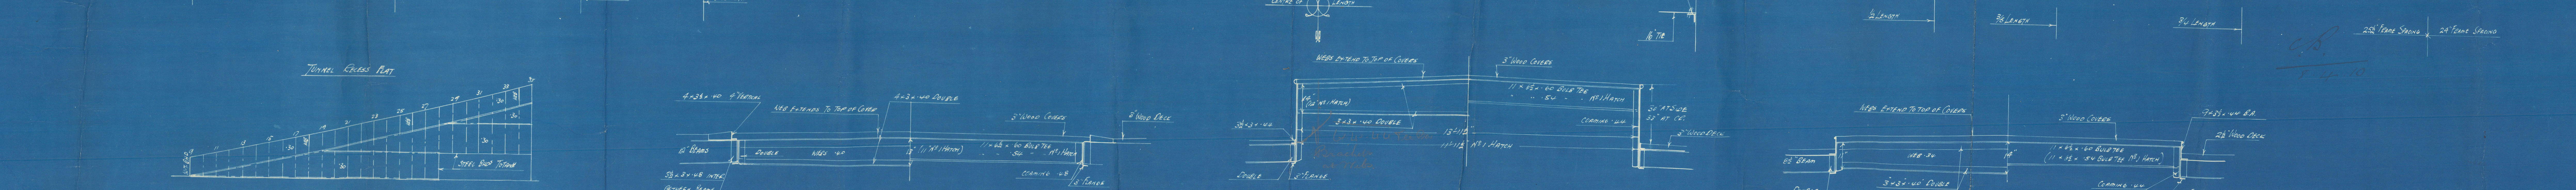
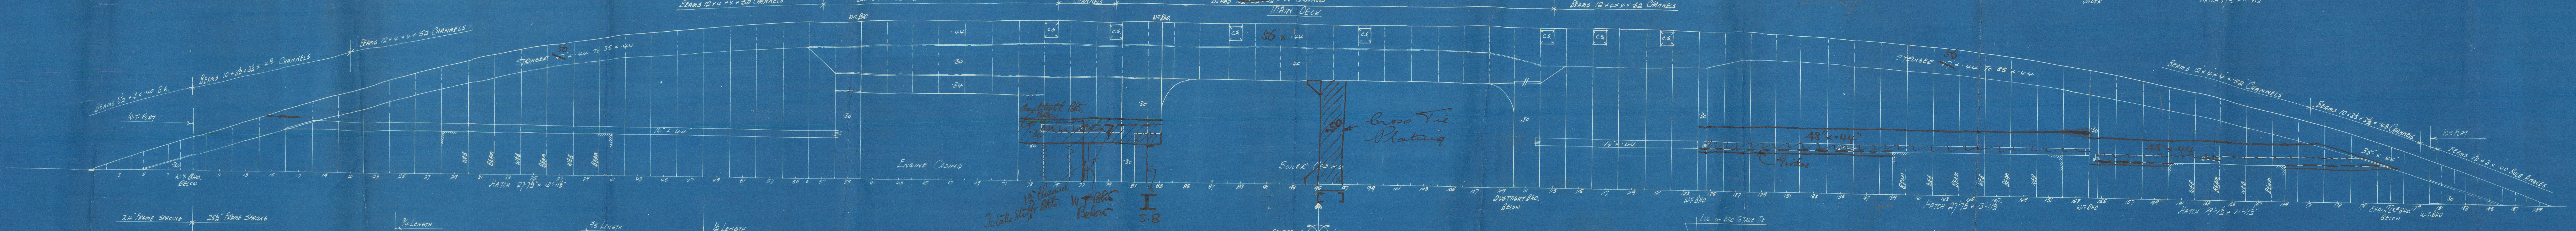
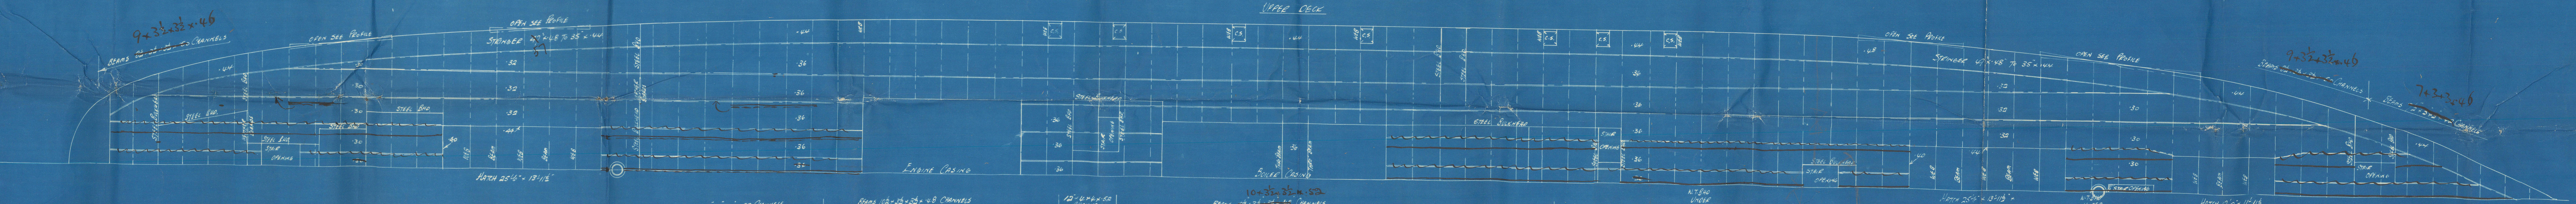
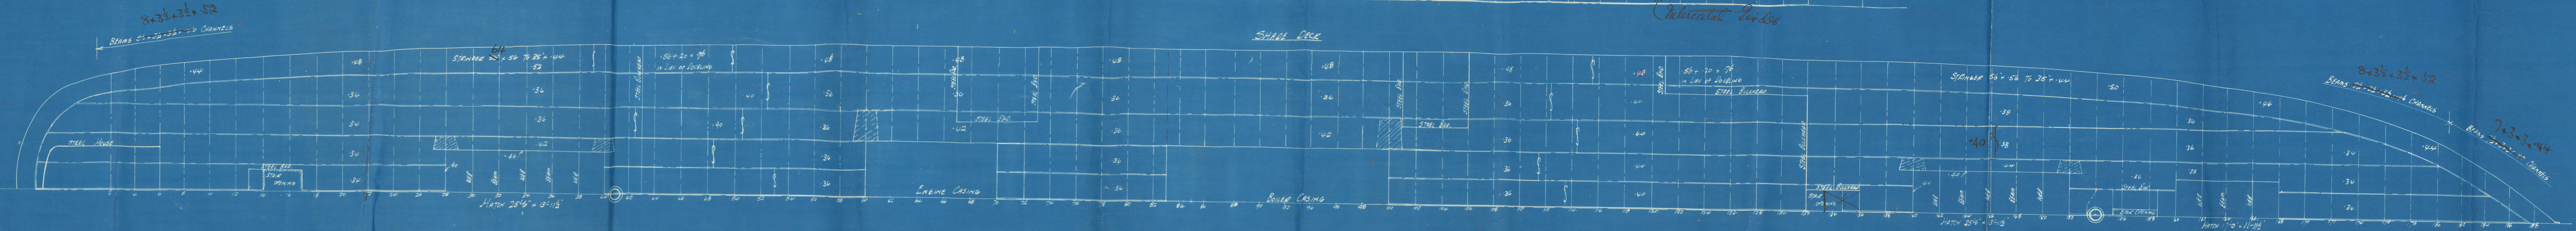


STEEL DECKS T-5-S-1 486-7

PLATE DIMENSIONS 400'0" x 52'8" x 28'0" TO VAMP DECK
TO CLASS 100 A.I. LLOYDS
SCALE 1/8" = 1 FOOT

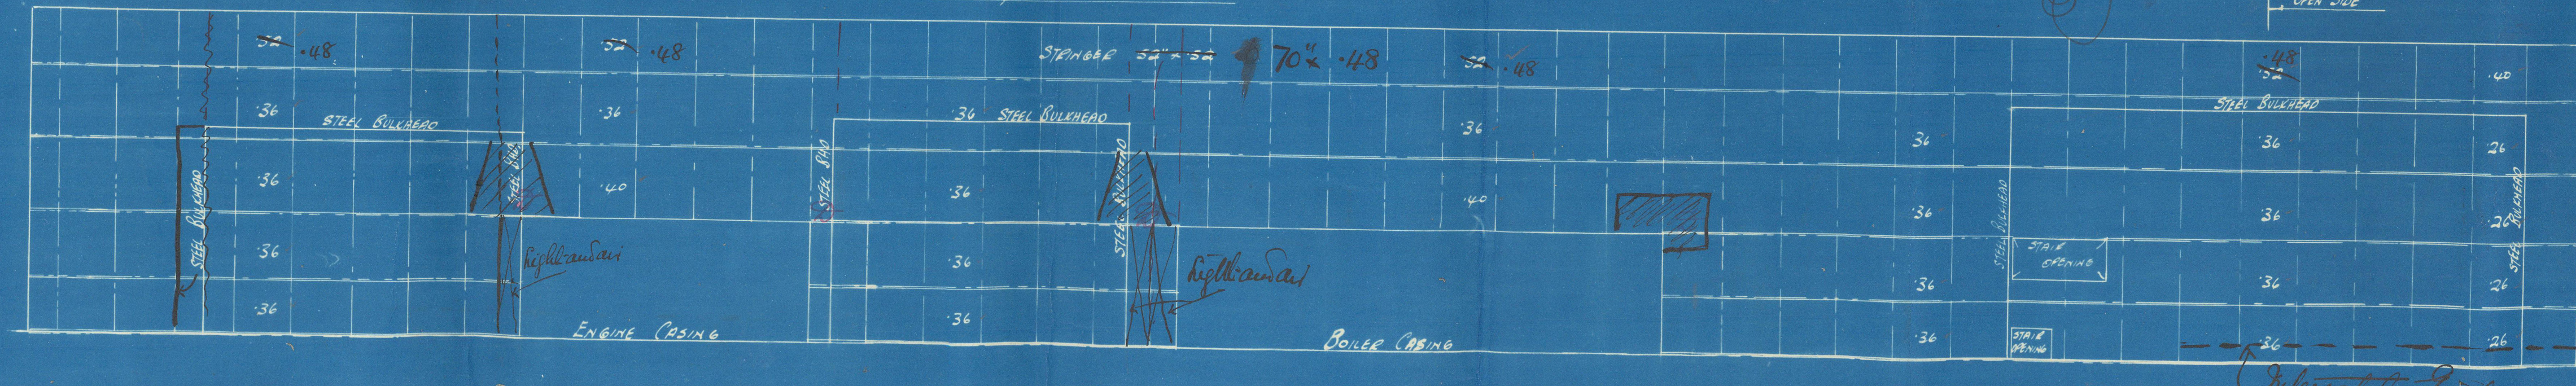

Lloyd's

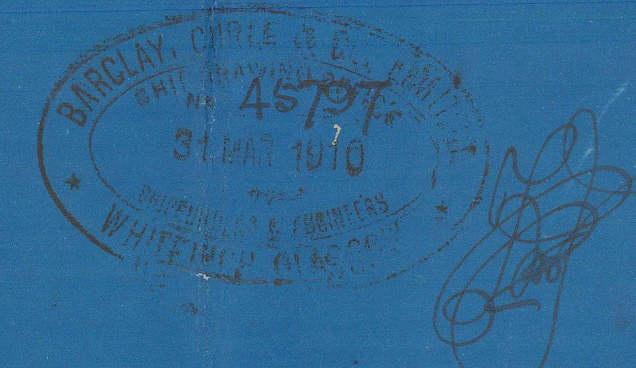

© 2020

Lloyd's Register
Foundation

Shrimad
Sachin

Lloyd





N^o 486

% "Edwina"




GLASGOW REPORT No. 30018

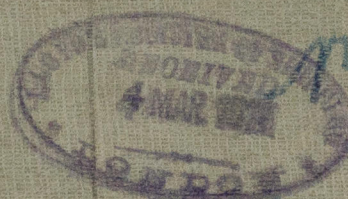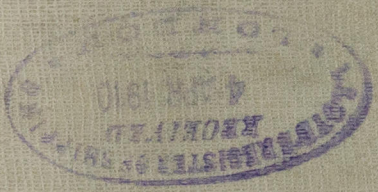

N^o 487

% "Elephanta"

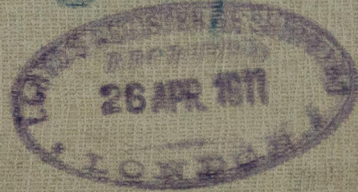

GLASGOW REPORT No. 30159

Jalagopal

002079-002084-0001



© 2020

Lloyd's Register
Foundation