

N<sup>o</sup> 177.  
MIDSHIP SECTION  
STEEL SCREW STEAMER.

LENGTH 258'-0", BREADTH M<sup>d</sup> 35'-6", DEPTH M<sup>d</sup> 18'-6" TO UPPER D<sup>k</sup>

SCALE: 1/4" = ONE FOOT.


CLASS 100 A.I.

PROPORTIONS.  
L = 258 D = 18.5 = 13.9 L = 258 D = 25.6 = 10.07.

LLOYD'S NUMERALS.

35.50  
18.50  
54.00 1st N<sup>o</sup> (B+D)  
258  
43200  
27000  
10800  
13932.00 2<sup>nd</sup> N<sup>o</sup> L (B+D)

1st MACHINERY 15'-8"  
2<sup>nd</sup> BOILERS 16'-8"

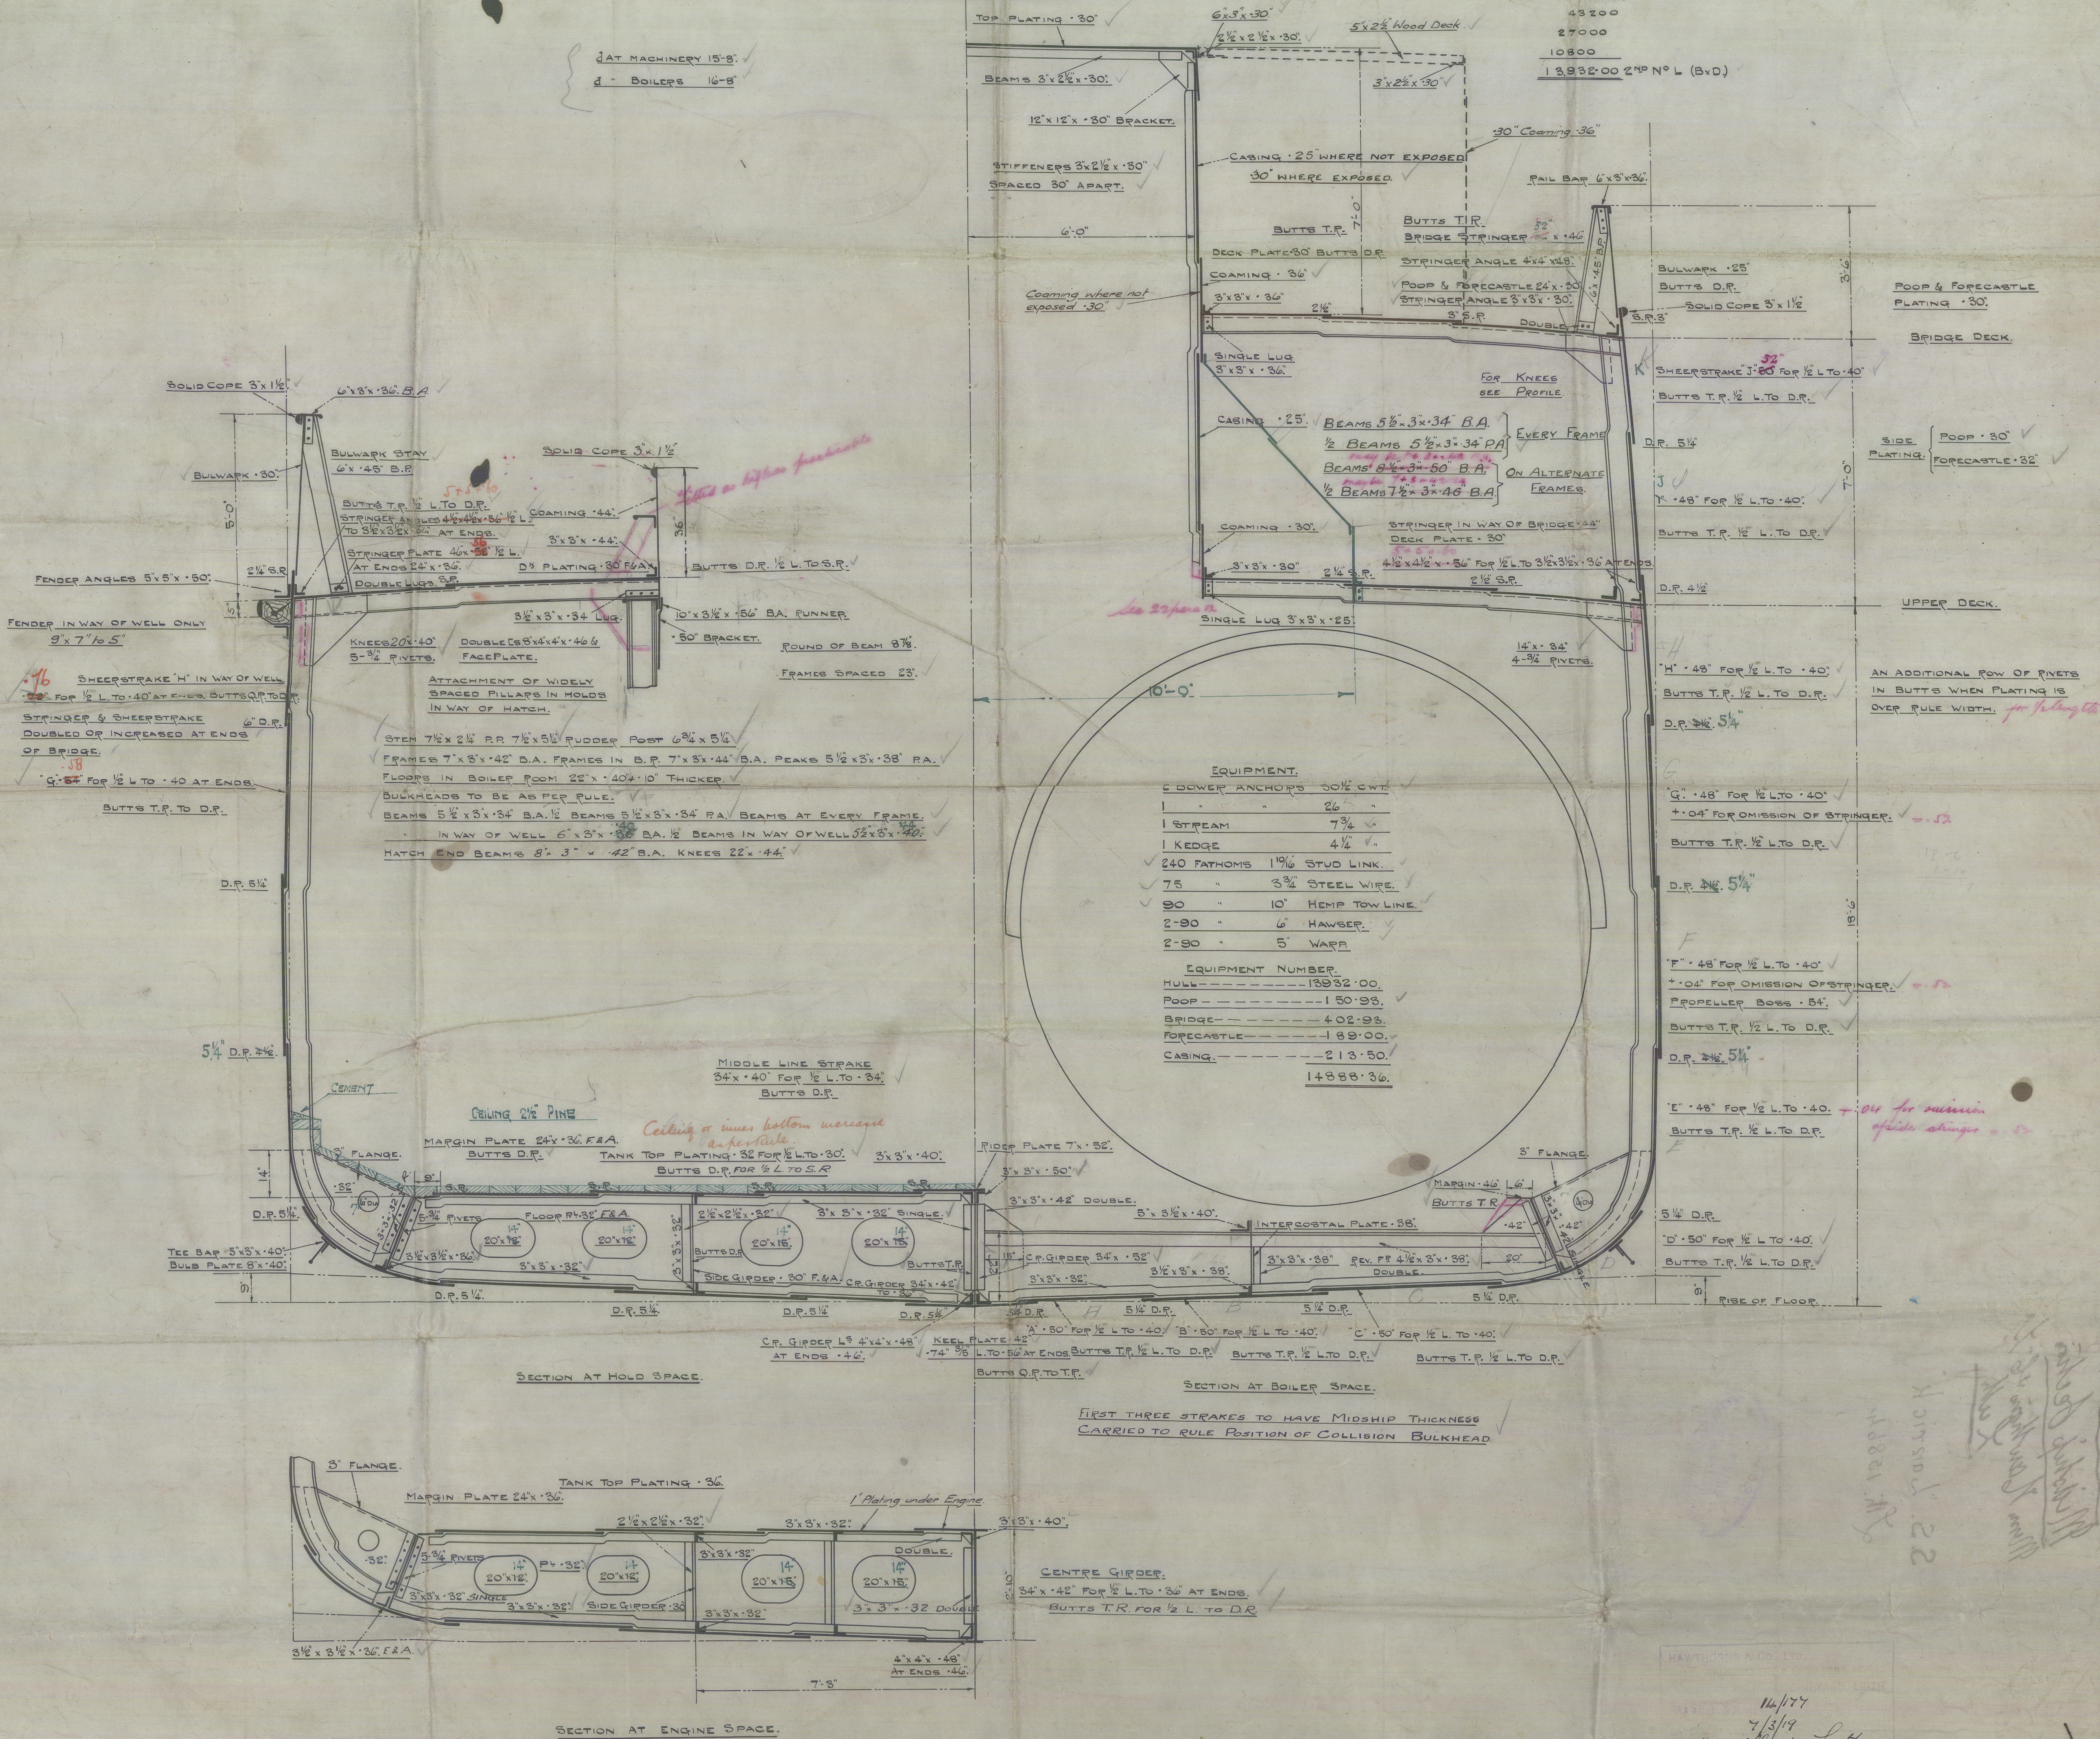

DRAWING N<sup>o</sup>  
14/177.

14/177  
7/3/19  
Wm Lloyd Smith



S.S. No 144

Midship Section

Mem. Hawthorn & Co. Ltd  
Luth

S.S. "Larrick"

Lth. 15864

"Belarock"



© 2020

Lloyd's Register  
Foundation

002079-002084-0161