

Nº 385

DIMENSIONS:- 160'-3" BY 24'-10" BREADTH MOULDED BY 12'-0" DEPTH MOULDED

Scale $\frac{1}{2}'' = 1$ Foot

SECTION THRO' QUARTER DECK

Bottom Strengthened Forward as per Section 12.A.

Vessel to Load on Ground

Strokes A, B. & C doubled for 8 frame
spaces about Collision Bulkhead

Mackie & Thomson Ltd.

N^o 385.

Amended Midship
Section

s.s. Bellavale
Glasgow Report


N^o 28480.



© 2021

Lloyd's Register
Foundation

002085-002093-0043

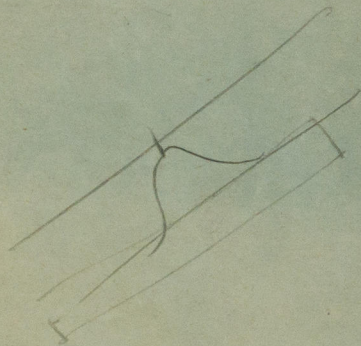

© 2021

Lloyd's Register
Foundation