



LONGITUDINAL SECTION & DECK PLAN

Nº 385


SCALE 1/4" = 1 FOOT

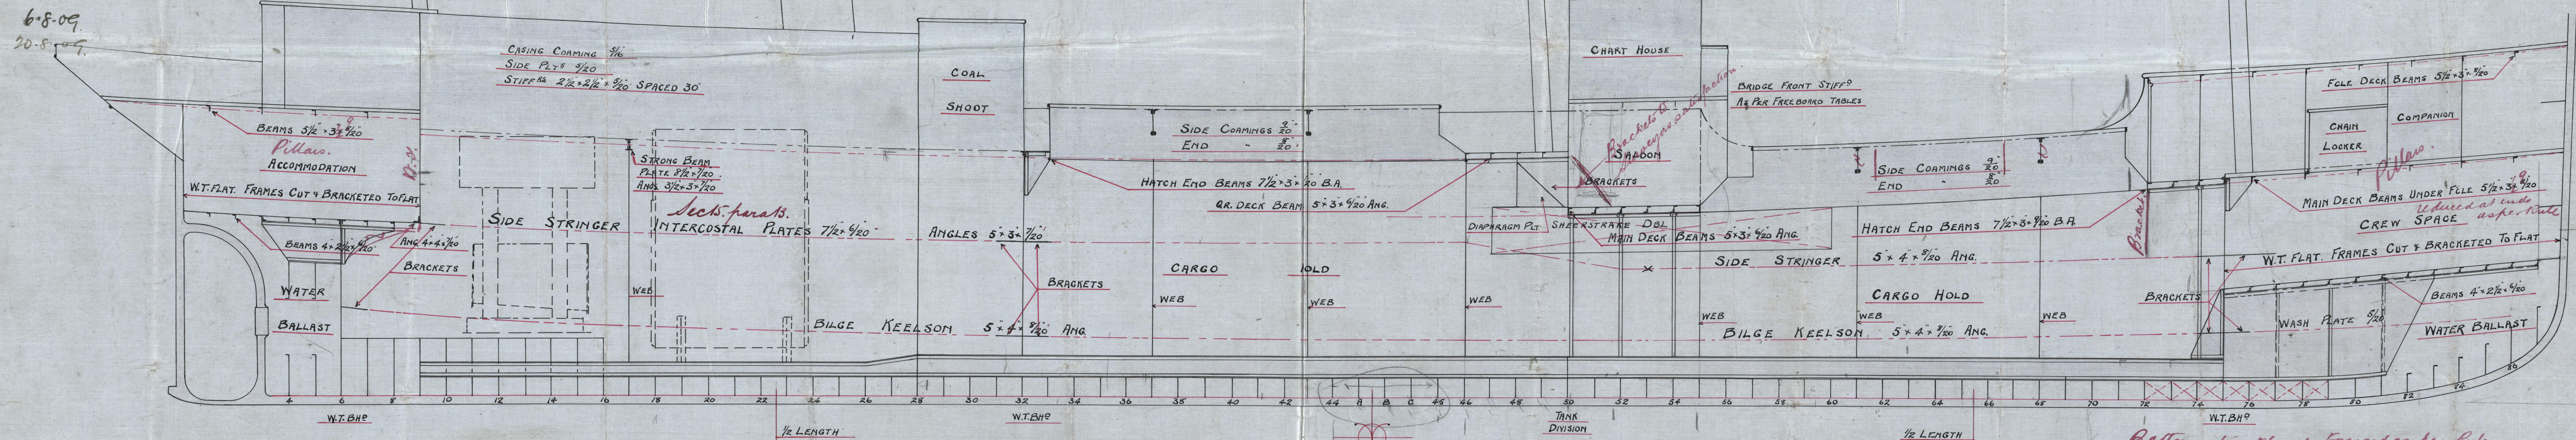


Bottom strengthened Forward per Rule.

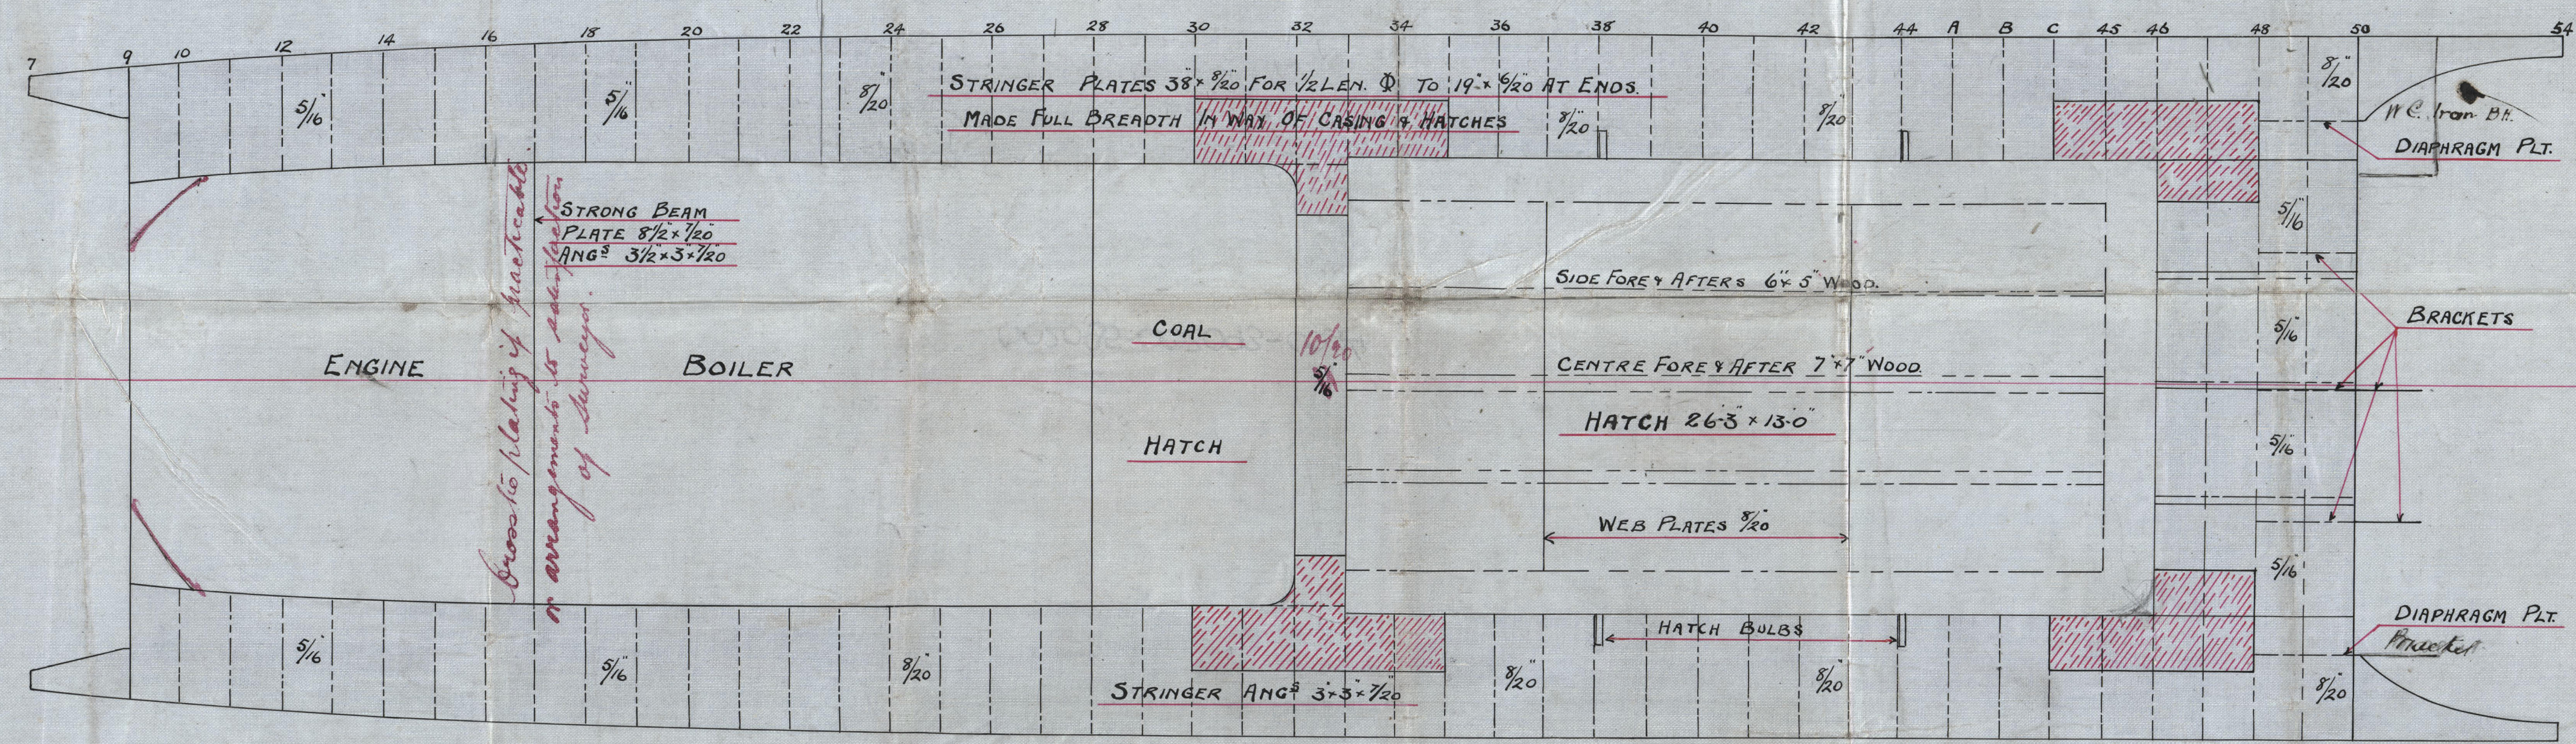


QUARTER DECK

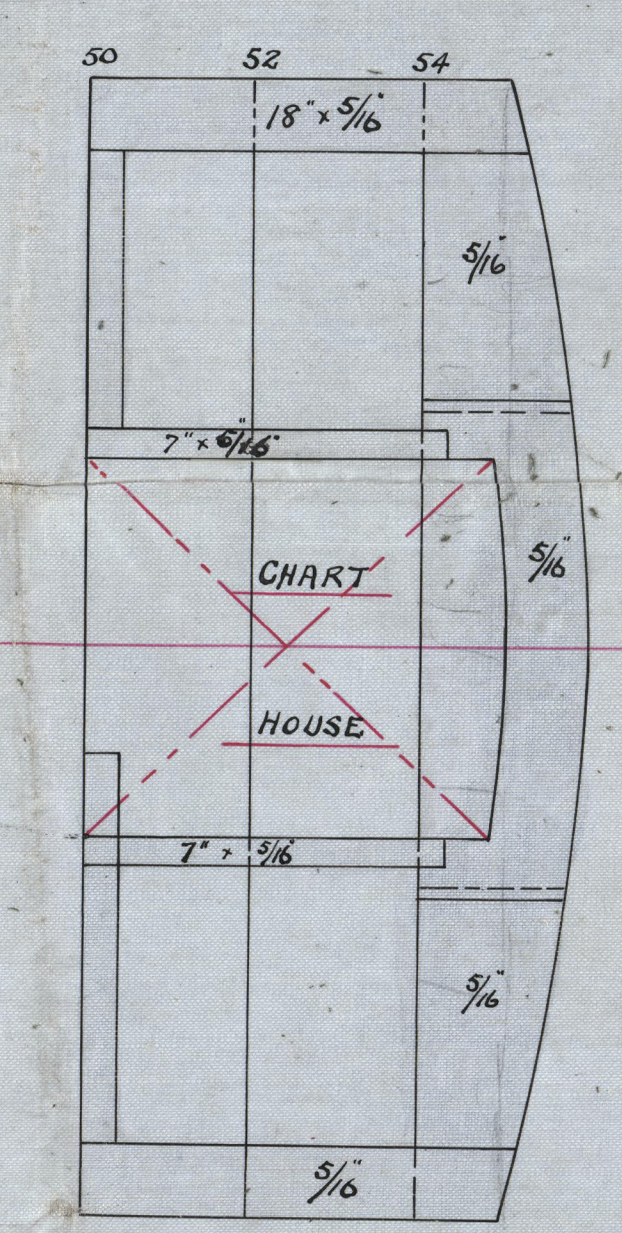



BRIDGE DECK

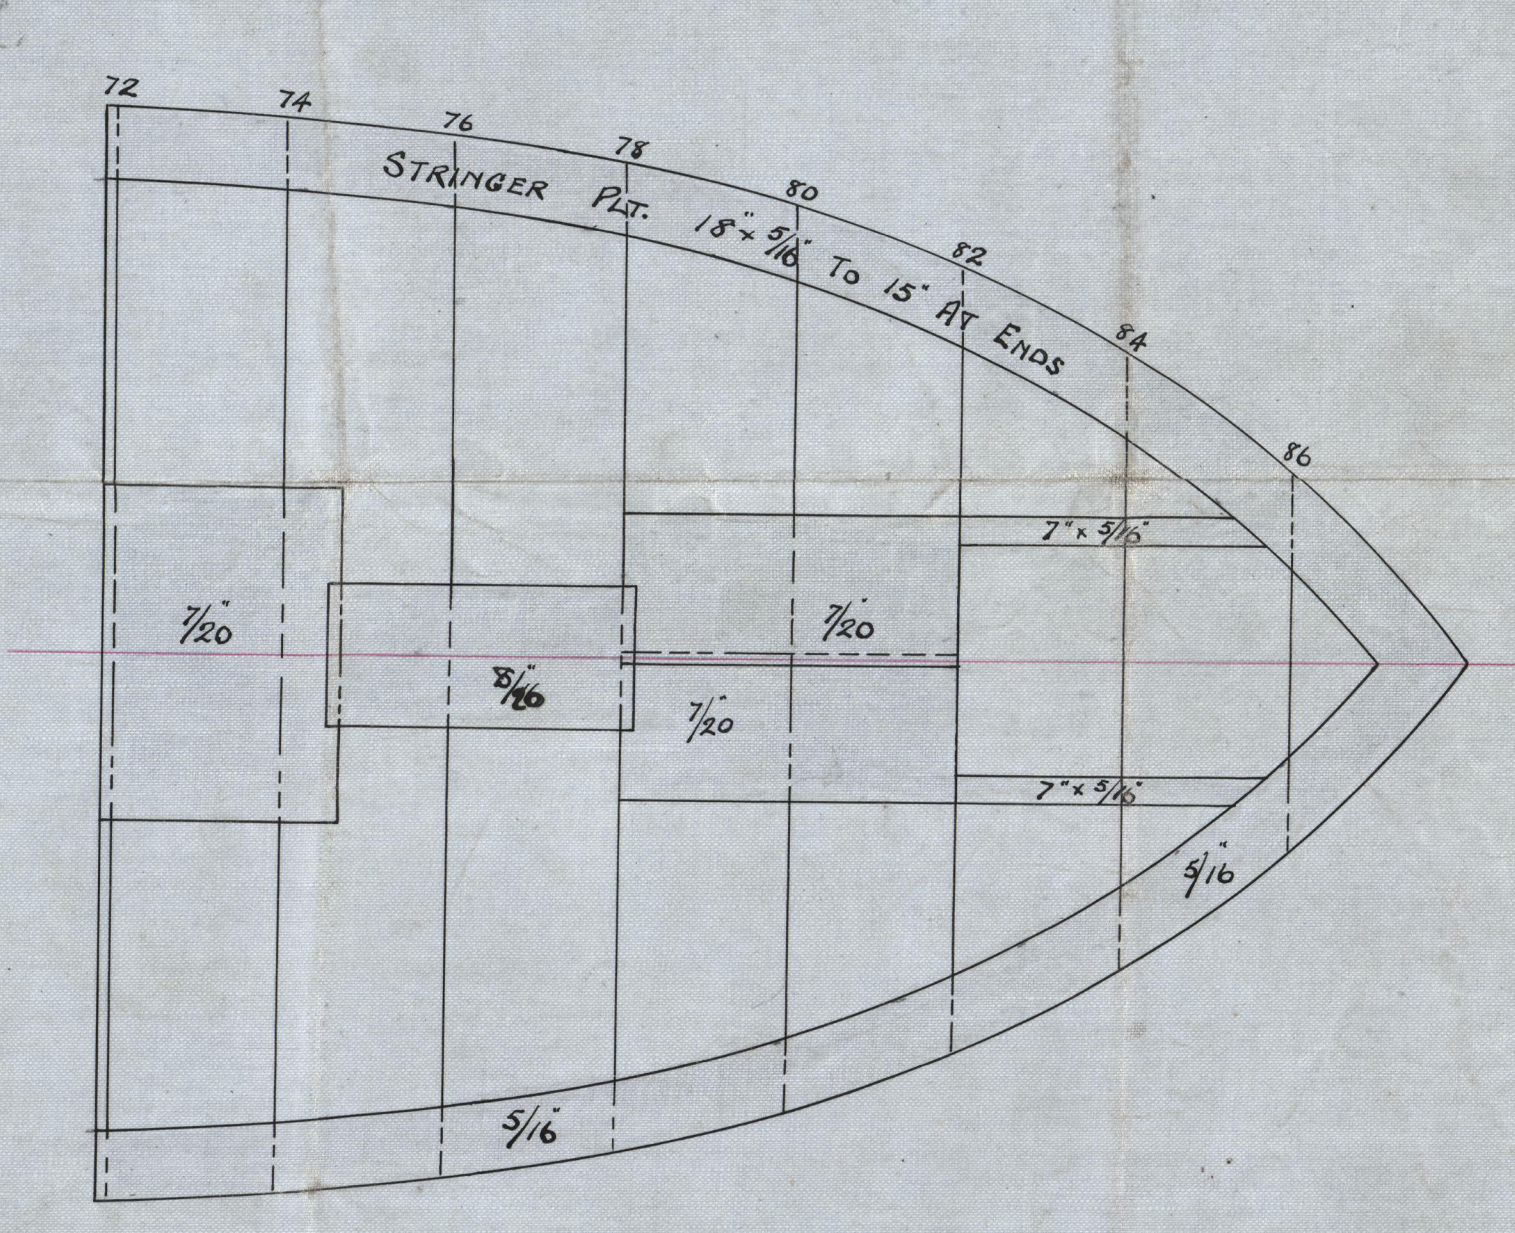

FORECASTLE DECK

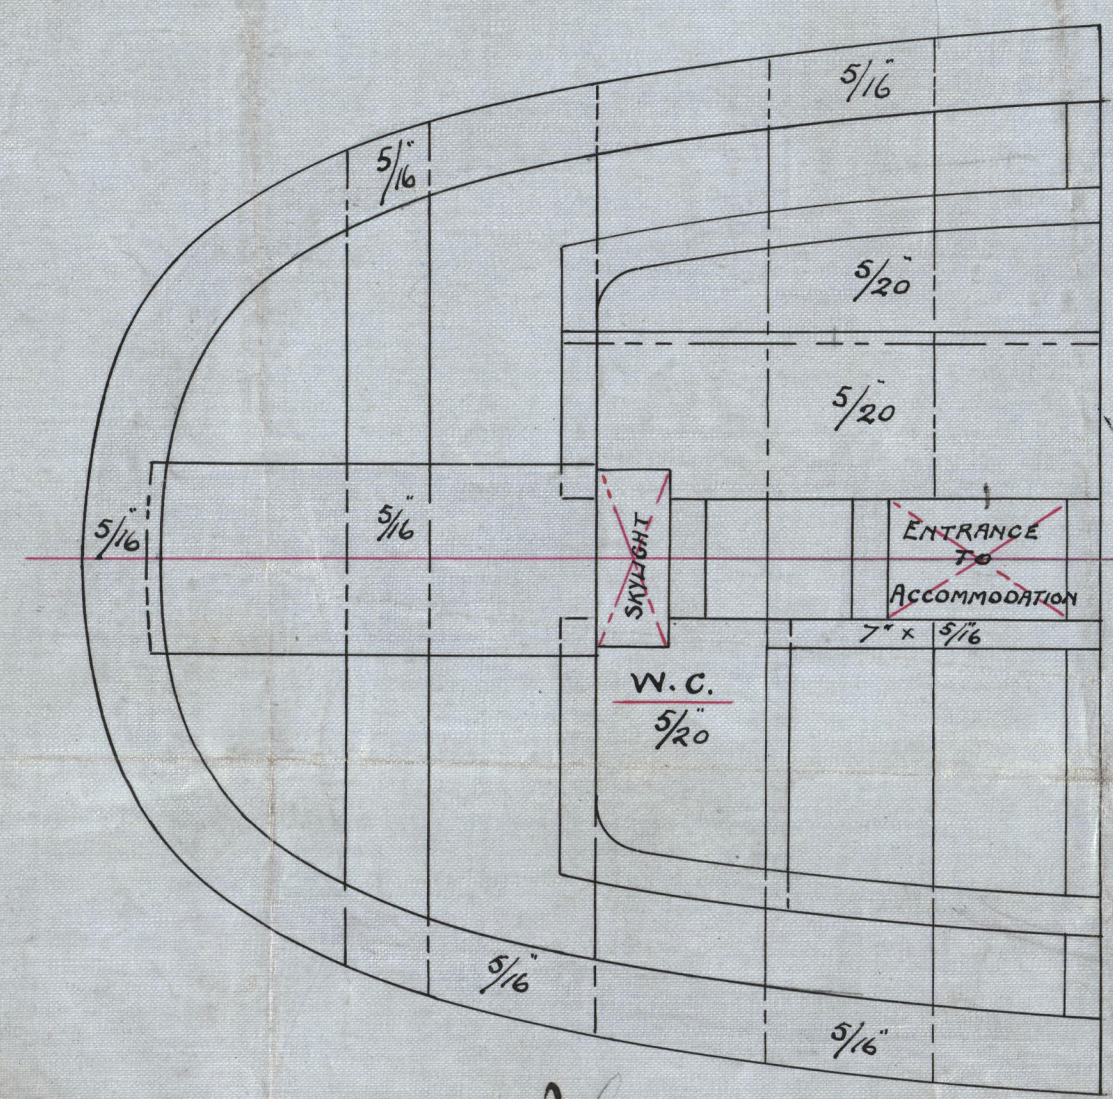

FORECASTLE DECK

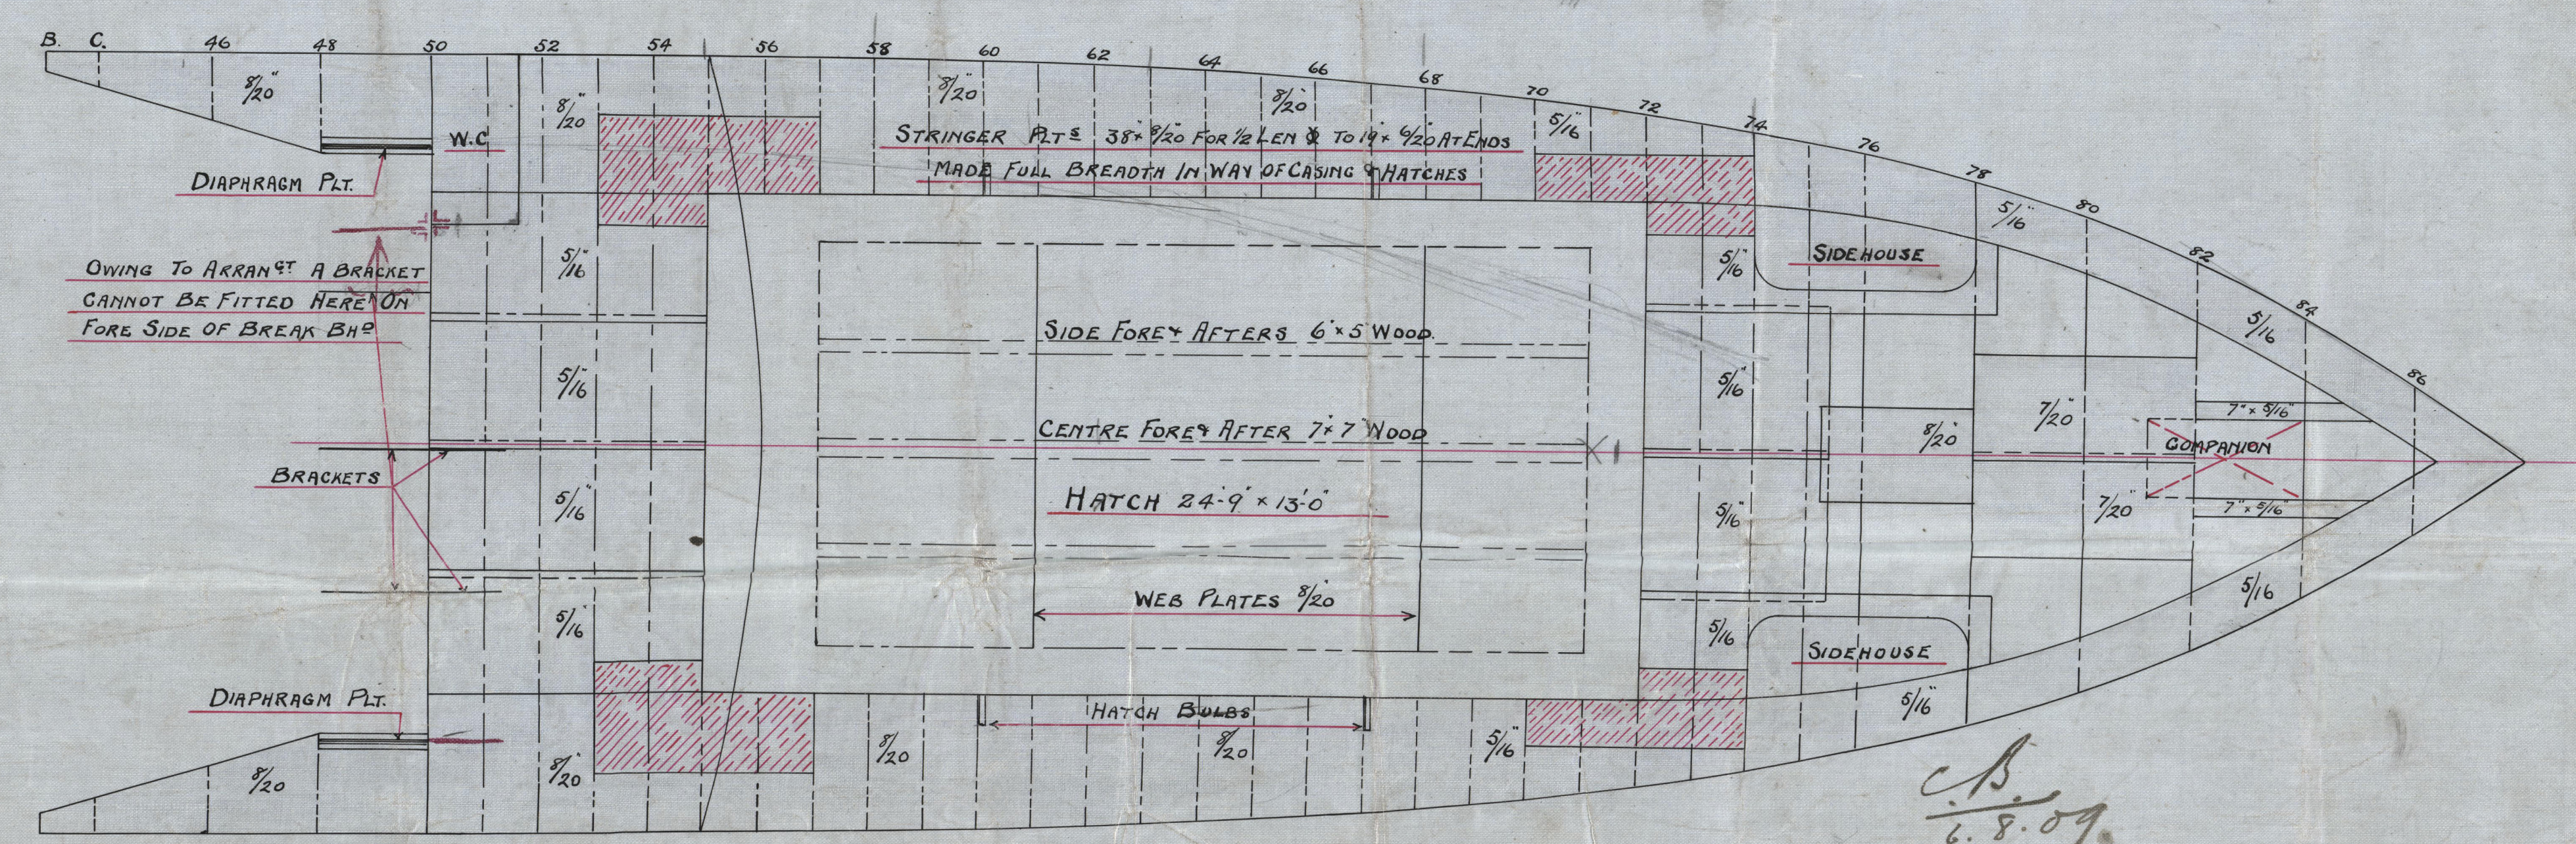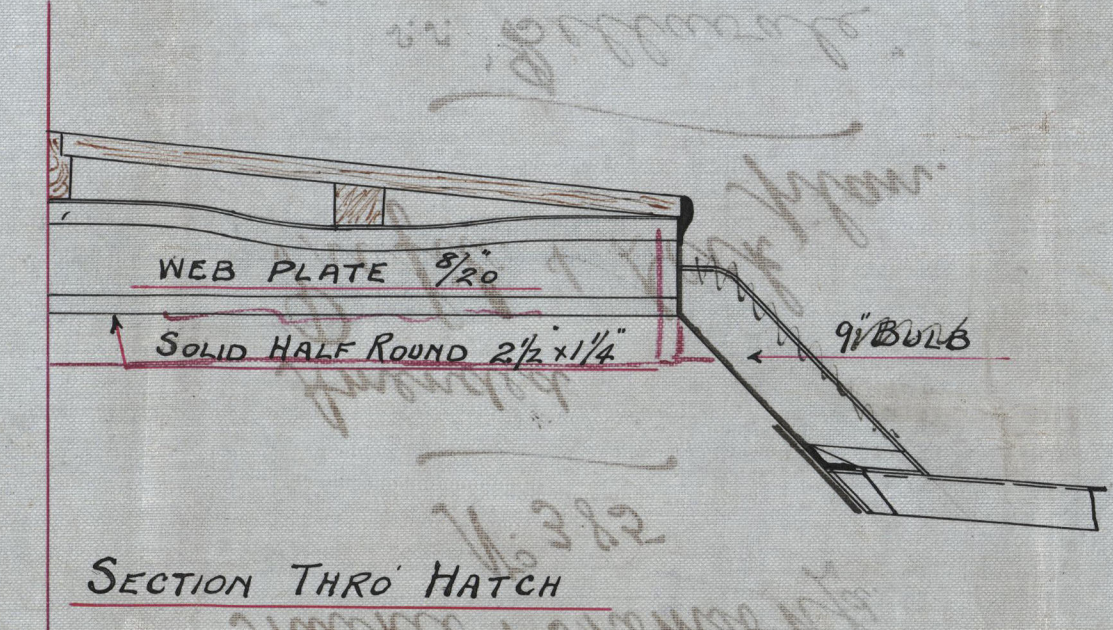

MAIN DECK

Mackie & Thomson & Co.
N^o 385

Amended
Profile & Deck
plan.

S.S. 'Bellavale'
Glasgow Report N^o 28480.



© 2021

Lloyd's Register

Foundation

002095-002093-0044