

9/1/24.


S. S. N^{os} 611 - 612.

PROFILE AND DECK PLANS.



SCALE 1/8 INCH = ONE FOOT.

LENGTH B.P. 240'-0", BREADTH MLD. 34'-0", DEPTH MLD. 16'-4".

LLOYDS CLASS 100 A.I.

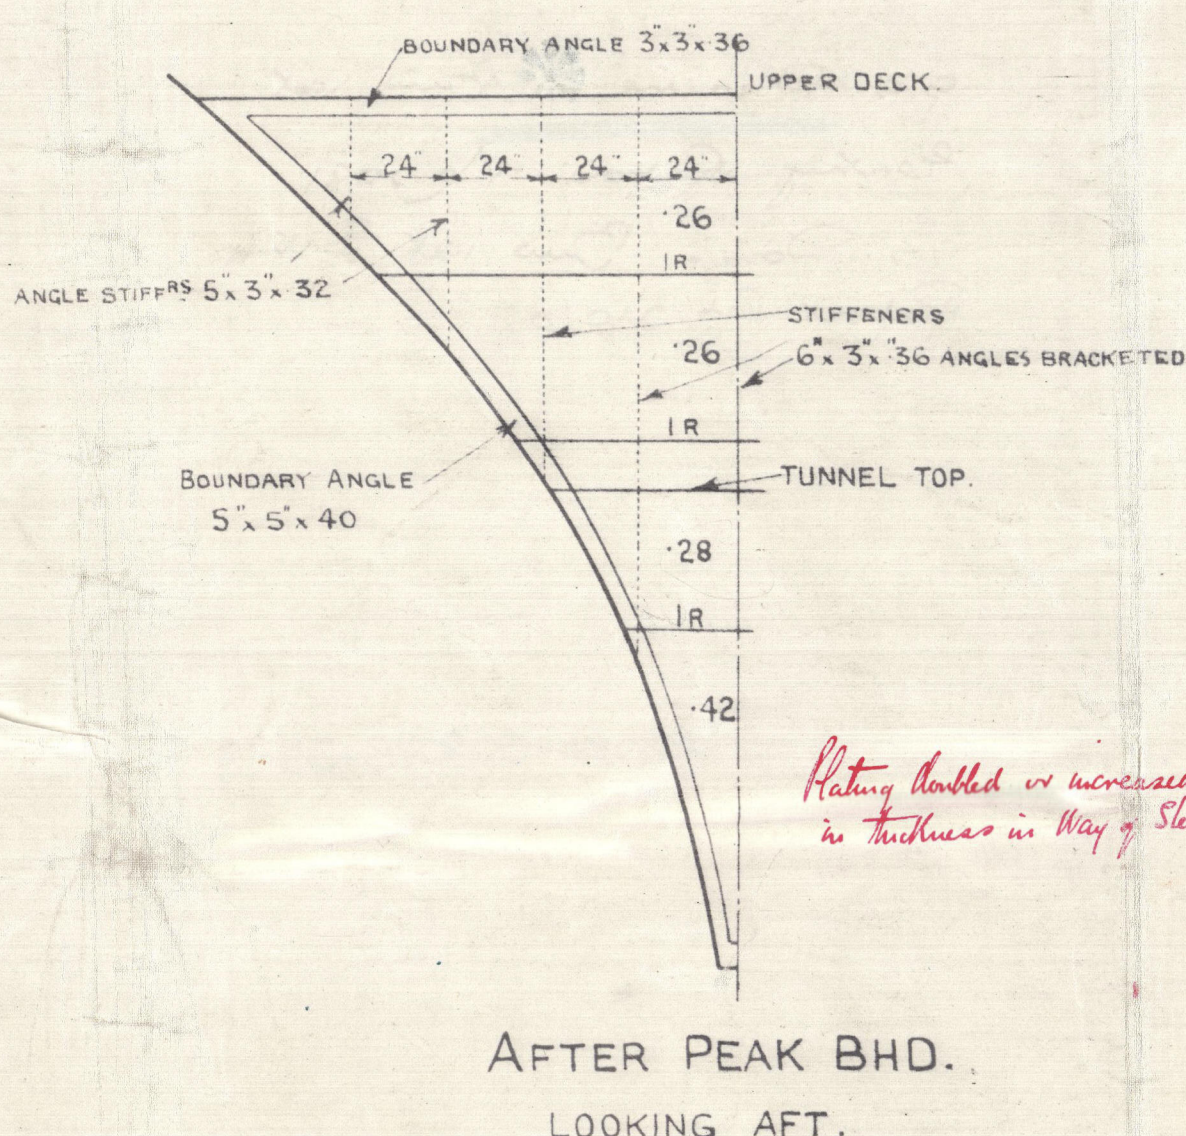


Plating doubled or increased in thickness in way of Stiffeners

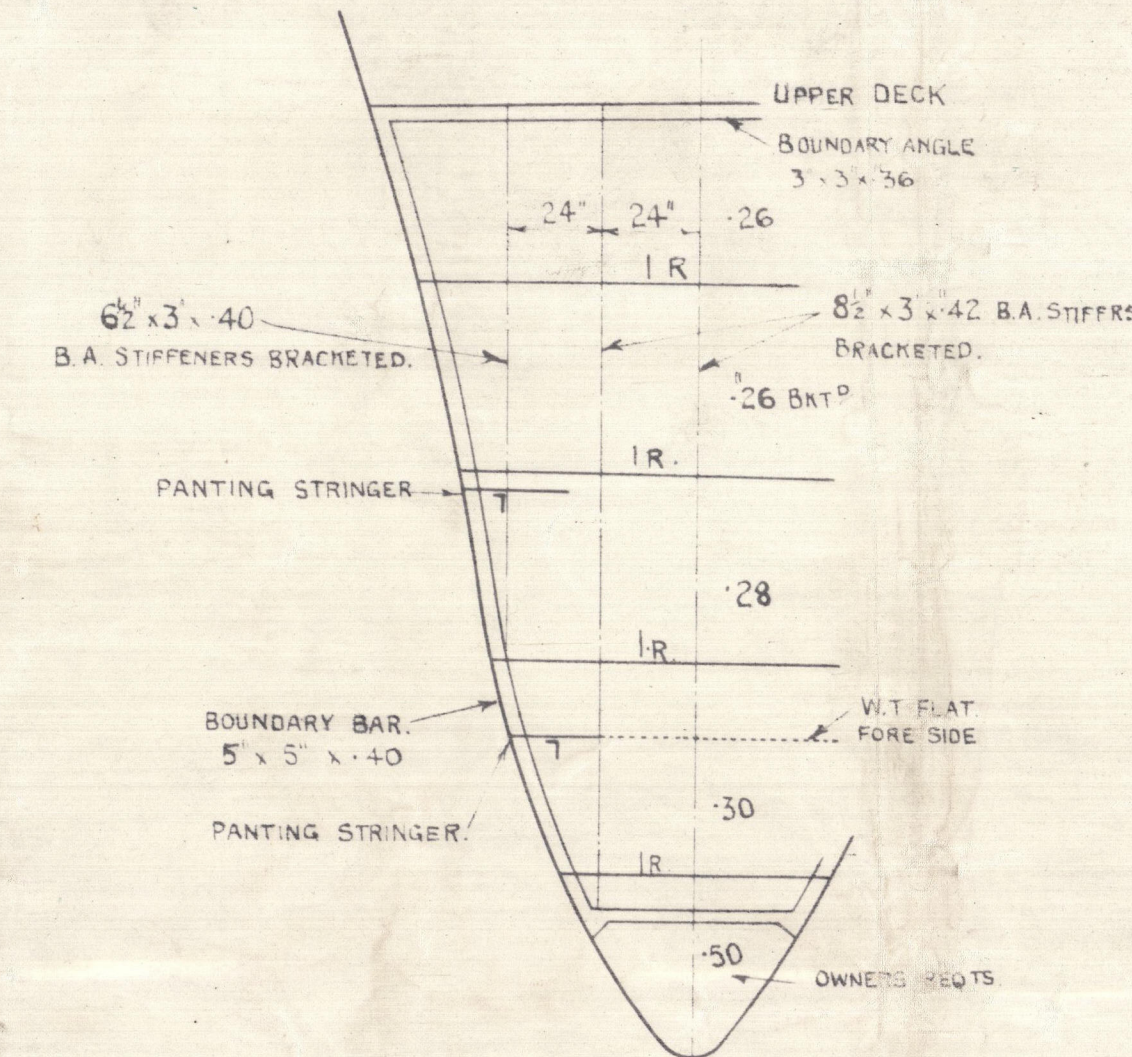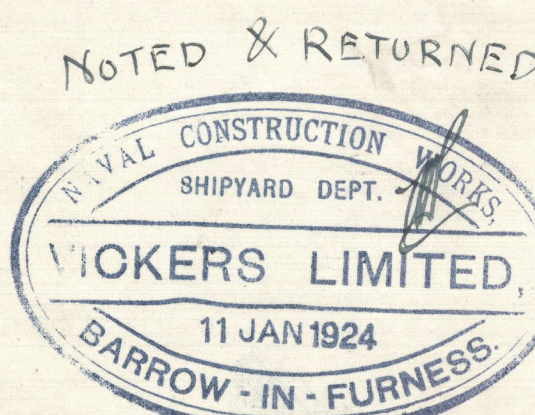

COLLISION BHD. LOOKING FORWARD.


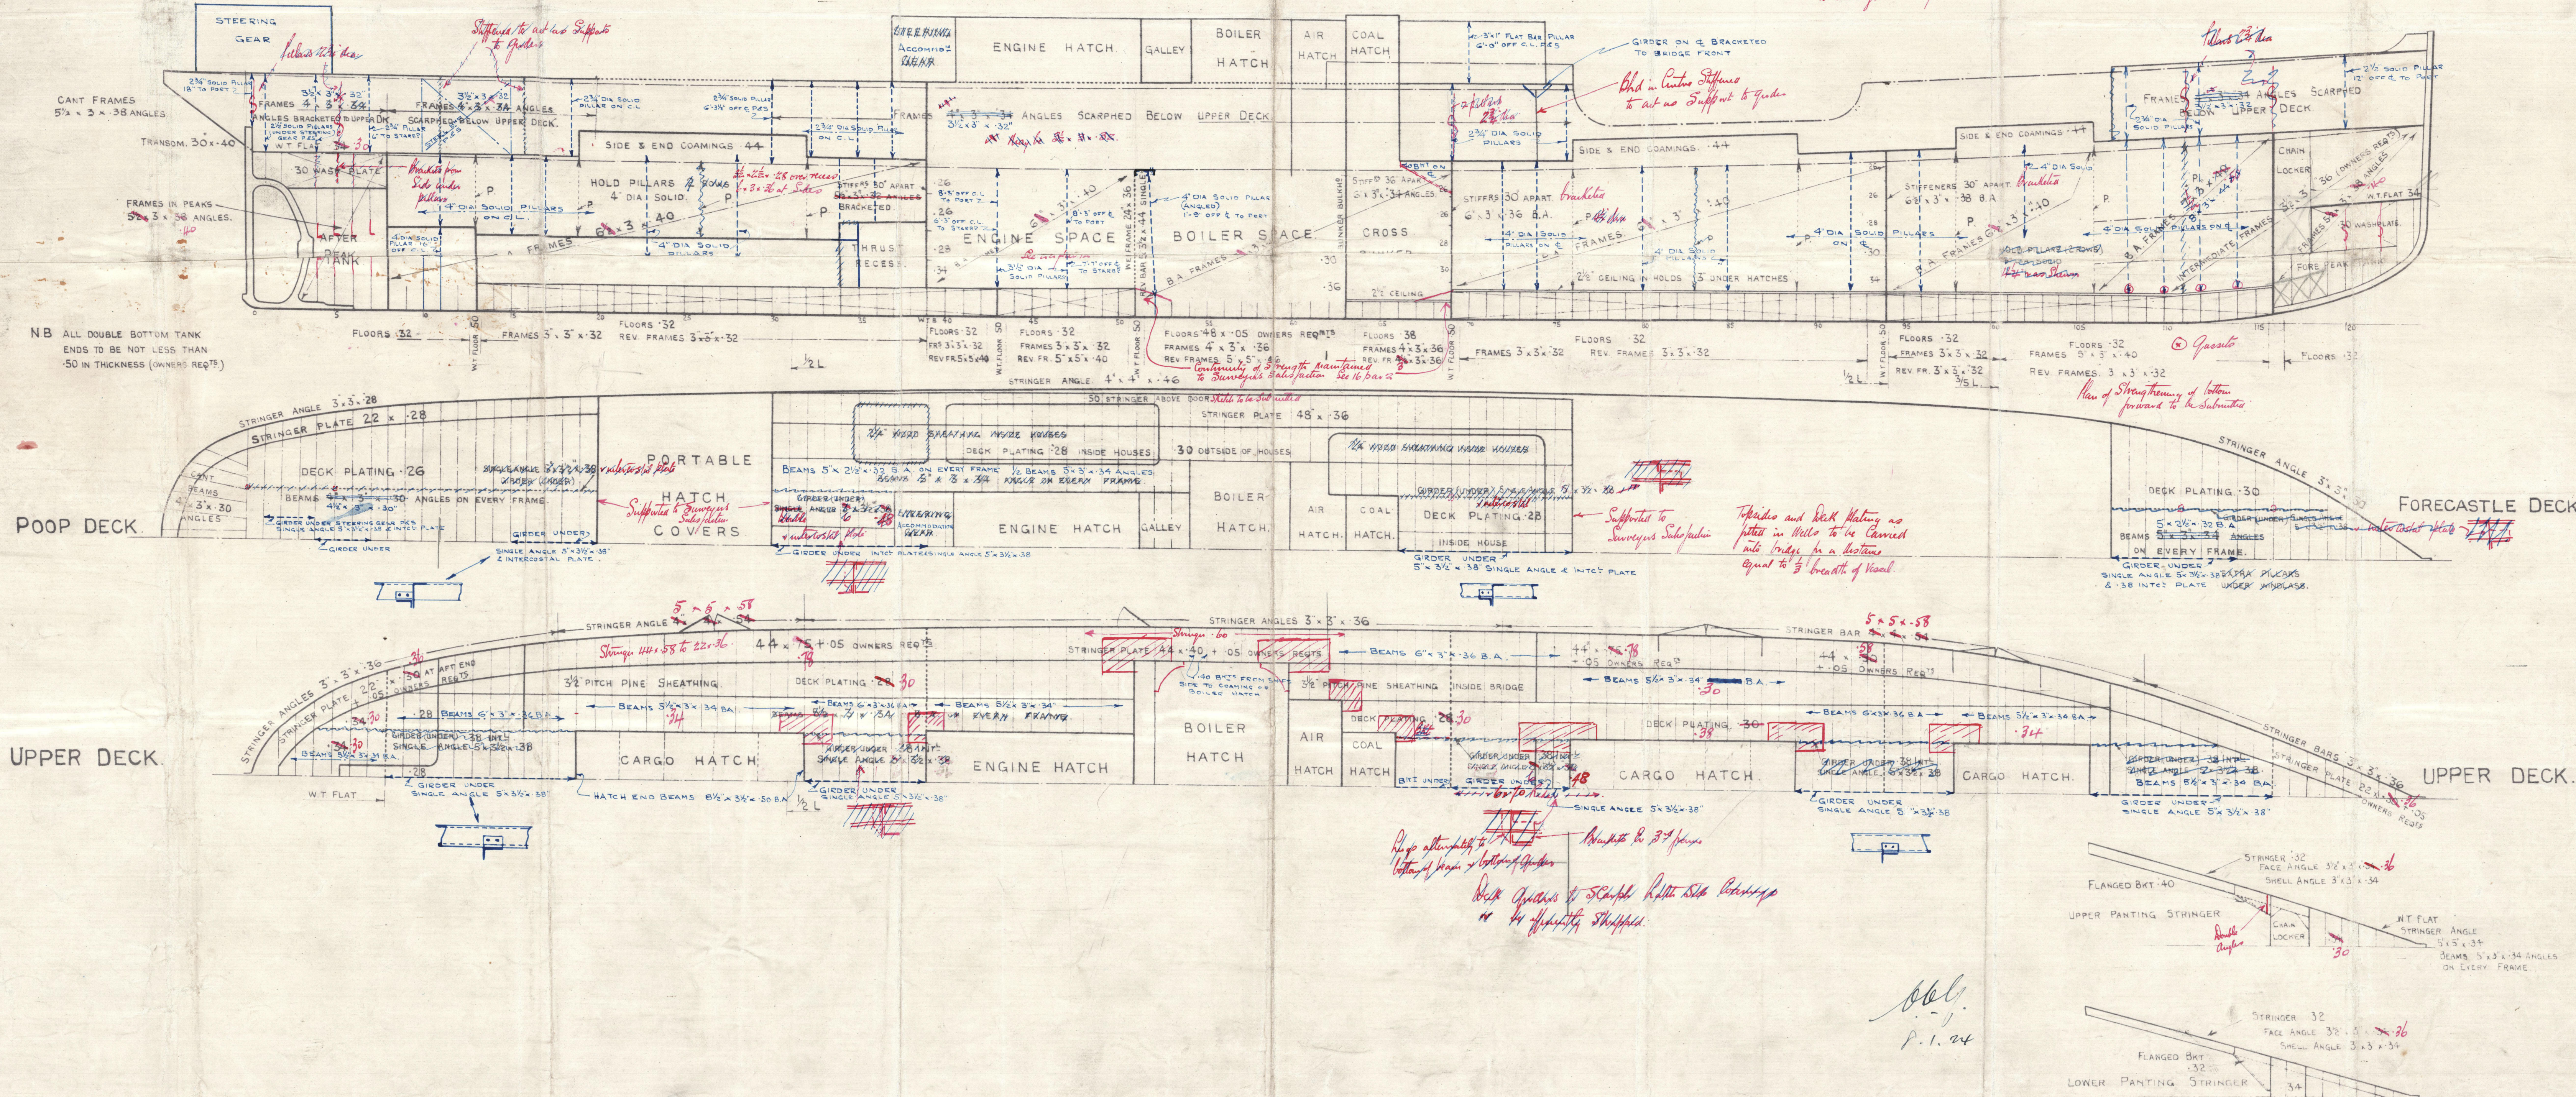

661.
P. 1. 24

Pickers La No 611 & 612

- Profile & Decks

G.S. "Deane"  Bus 1st

Entry Report No 2081

G.S. "Don" - Bus 1st Entry
Report No 2106.



© 2021

Lloyd's Register
Foundation

002085-002093-0053