


16/8/17

170
100
70
0.5

See details plan for framing in
Engine Room

 


LONGITUDINAL ELEVATION.

M.S. Nos 502c-3c-4c-5c-15c-16c-17c-18c.

485'-0" x 62'-0" x 39'-6" K to B.

TO CLASS 100 A1 AT LLOYD'S.

SCALE 1/8" = 1 FOOT.

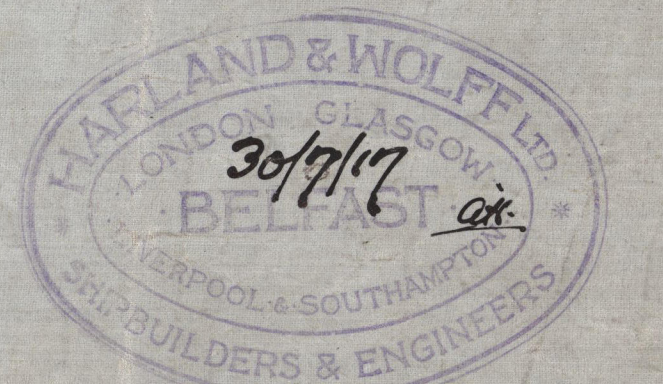

Profile

messrs Harland & Wolff & Co

Nos. 502. 3. 4. 5. 15. 16

17. 18

Penogle *


10030 L,
Penogle

10034 L

40694

515. "Denteldyk"

41732

 

© 2021

Lloyd's Register
Foundation

002085

002093

0120