


S.S. N° 106
PROFILE & DECK PLANS
SCALE 1/8" = 1 FOOT.

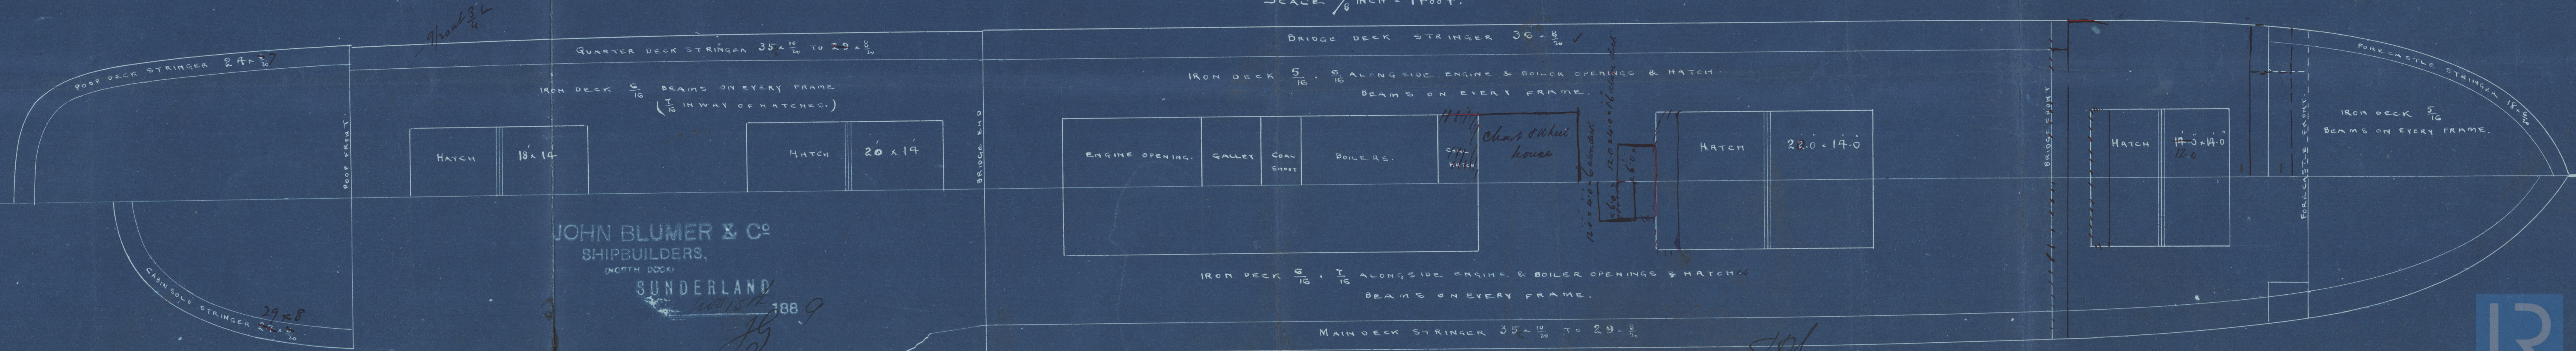

JOHN BLUMER & CO
SHIPBUILDERS,
SUNDERLAND
1889

Profile 106



"Eriksborg"

John Blumer & Co.

No. 106

"Eriksborg"
S.S. ^{ex} Lynton

Profile.

Gld. 15657

002085-002093-0142



© 2021

Lloyd's Register