





Nº 106

FOREMAST

Linkborg
S. Lynton Sld. report N. 15654

MASTS IN TWO PLATES
 BUTTS DOUBLED LAPPED BELOW PARTNERS
 BUTTS TREBLED LAPPED ABOVE PARTNERS
 SEAMS SINGLE RIVETTED
 DOUBLED AT PARTNERS AND HEEL

SAME FOR
 MAIN MAST

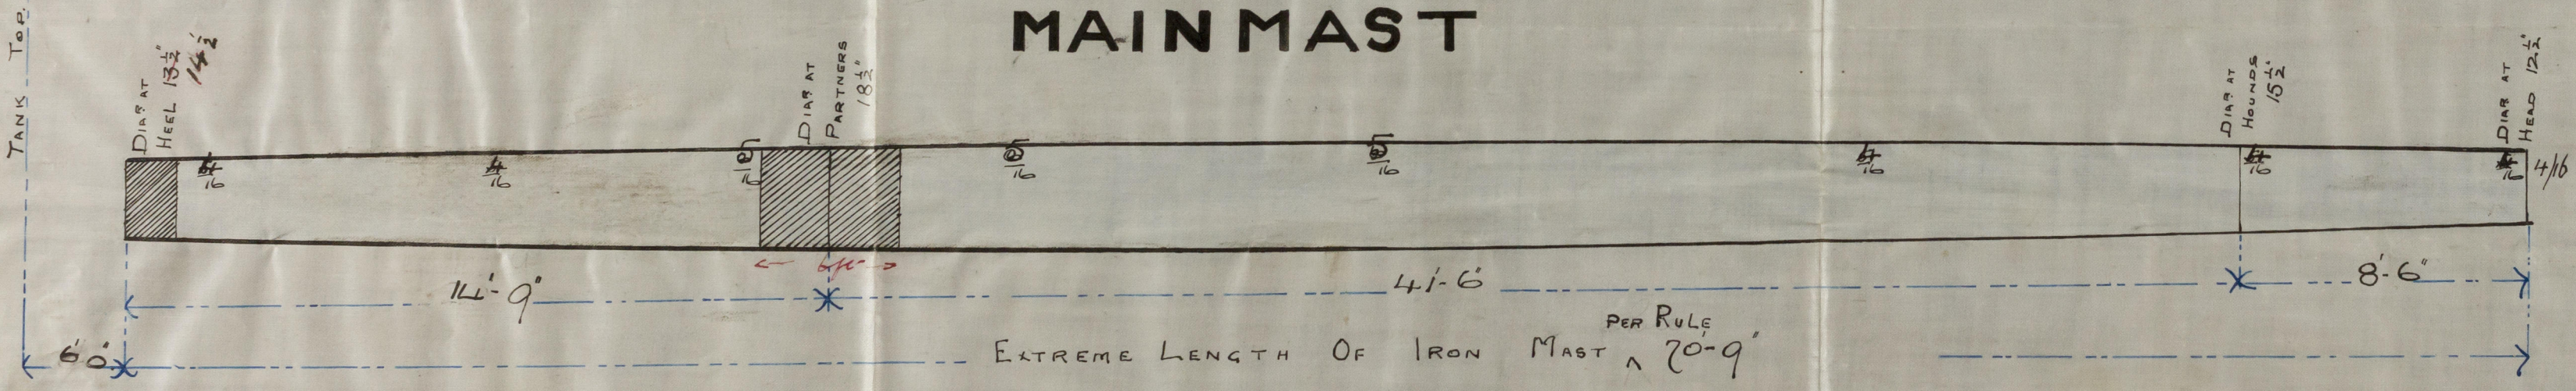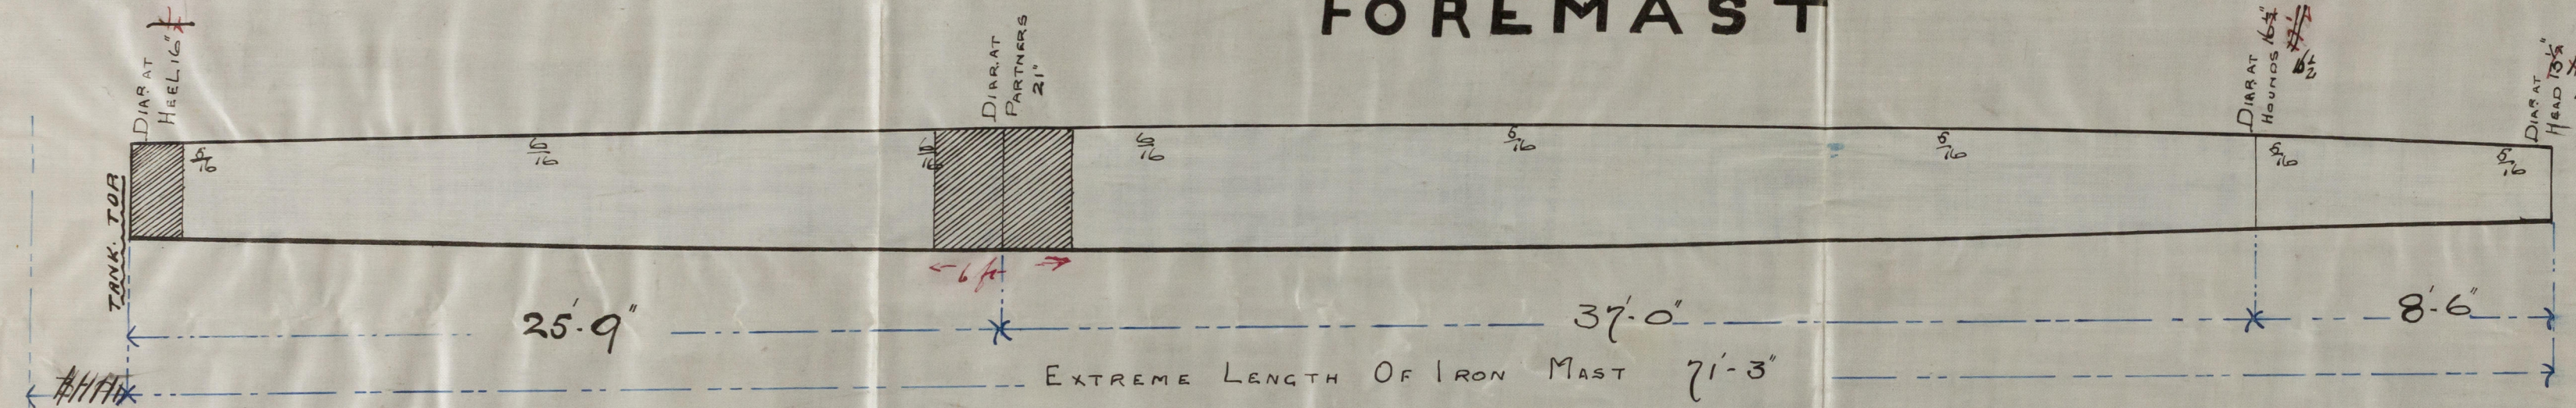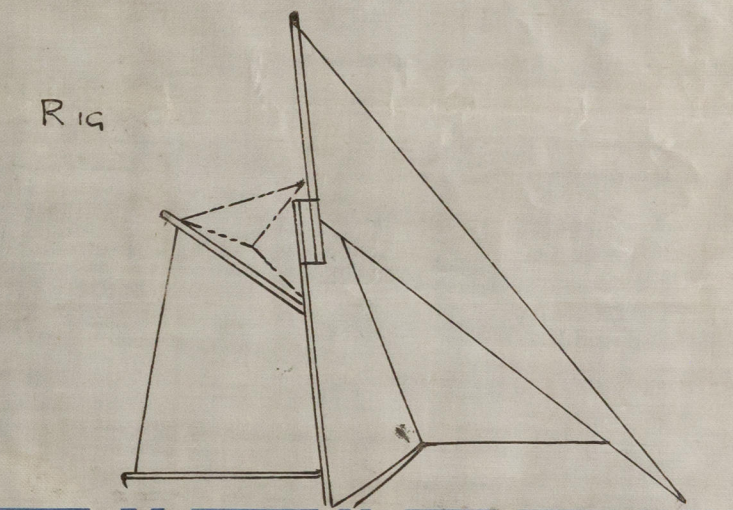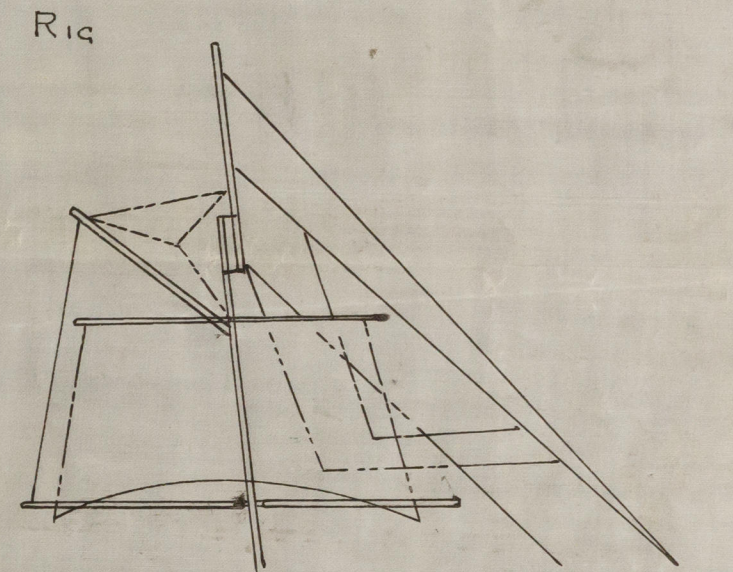

JOHN BLUMER & CO
 SHIPBUILDERS,
 NORTH DOCK
 SUNDERLAND

C.B. 30.1.90



© 2021
 Lloyd's Register
 Foundation
 002085-002093-0144