

"Lynton"

Received at

Office,

18

Lloyd's Register of British and Foreign Shipping.

(Report on Vessel No. 15654 Port Sunderland)

Sundr

No. 1599.a

SHIP FORGINGS OR CASTINGS.

The words FORGINGS or CASTINGS, IRON or STEEL, should be struck out as may be required.

I have to report that the undermentioned Iron or Steel Forgings or Castings, manufactured by R. P. Bagnall & Sons of Wylton for the Vessel No. 106, being built by Blumer Co. of Sunderland have been inspected by me as set forth below, and found to be, so far as can be seen, sound


Mark on Forgings.

Lloyd's
No. 1599.a
R. P. B.

Hugh Cameron
Sunderland
14th July 1890.

	STERN FRAME.	RUDDER FRAME.	STEM.
Material* - - - -	<u>Scrap iron</u>	<u>Scrap iron</u>	<u>Scrap iron</u>
How made - - - -	<u>Faged</u>	<u>Faged</u>	<u>Faged</u>
Dimensions - - - -	<u>8 1/2" x 5"</u>	<u>8 1/4" - 3 1/4"</u>	<u>8 1/2" x 2 1/2"</u>
Progress on Inspection -	<u>Faged & mitted</u>	<u>Faged & mitted</u>	<u>Faged</u>
Dates when Inspected	<u>June 9. 16. 20. 24 July 11/90</u>	<u>April 10. 12. 18. 22 May 1. 8. 12</u> <u>31 June 3. 10. 13. 16. 24. 25 July 1/90</u>	<u>July 18/90</u>

SKETCHES OF FRAMES SHEWING POSITION AND DESCRIPTION OF WELDS OF FORGINGS, OR PARTICULARS OF TESTS APPLIED TO CASTINGS.

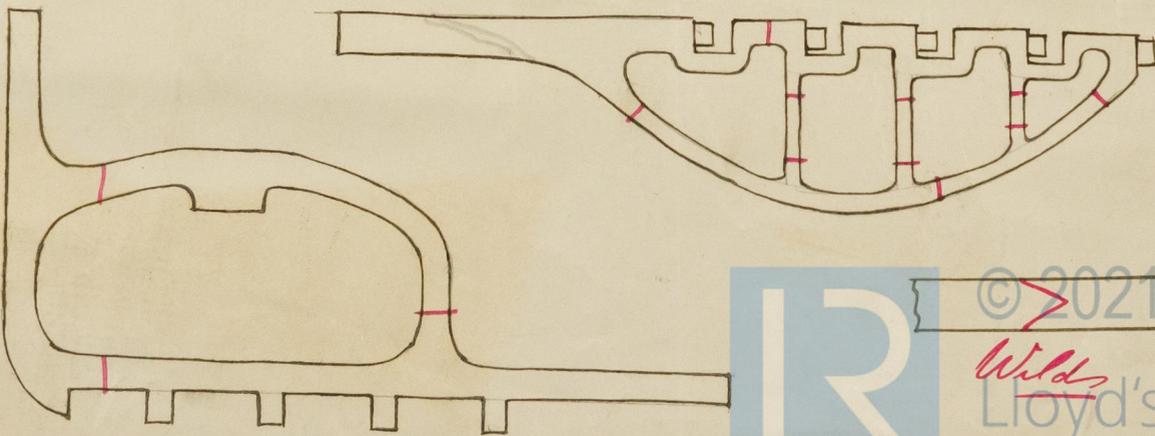

© 2021
Wills
Lloyd's Register
Foundation

* If of Iron, state whether scrap or puddled Iron.