

J. H. Laidman
Manager, Woolston Works.

— N^o 424 — — MIDSHIP SECTION —

— STEEL SCREW TUG —

DIMENSIONS 75'-0" x 18'-0" x 8'-10 1/2" MLD
PER RULE 74.1 x 18.0 x 9.25

— NUMERALS —

1/2 GIRTH	16.1
1/2 BREADTH	9.0
DEPTH	9.25
	34.35 = 1 ST N ^o
	74.1
	2545.33 = 2 ND N ^o

CLASS 100 A.I. TOWING PURPOSES

SCALE 1/2" = ONE FOOT


PROPORTIONS

B.TOL	4.1
D.TOL	8.0

— EQUIPMENT —

2 BOWERS (EX STOCK)	3 1/2 CWT
1 STREAM (EX STOCK)	3/4 DP
1 KEDGE	1/2 DP
120 FATHOMS	1 1/16" CHAIN CABLE
45 "	8/16" STREAM CHAIN
75 "	5 1/2" TOWLINE
90 "	3" HAWSER

SECTION CENTRE KEELSON
FOR² AND AFT OF E & B SPACE

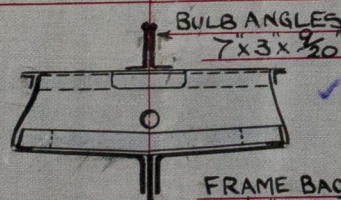

FRAME BACK BARS
3'-0" FOR 3/4 L.

CENTRE KEELSON
ANGLES 4 x 3 x 3/20 THROUGHOUT
INTERCOSTAL 5/20 IN E & B SPACE

KEELSON
5 x 4 x 3/20
LUG 5 x 2 1/2 x 7/20

PILLARS 2 3/8

IRON CHEQUERED PLATE DECK 1/4"
BEAMS 4 x 2 1/2 x 9/20 EVERY FRAME
FRAMES 2 1/2 x 2 1/2 x 5/20 SPACED 20"

REVERSE FRAMES 2 1/4 x 2 1/4 x 5/20 TO UPPER TURN OF BILGE

DOUBLE IN ENGINE & BOILER SPACE

FLOORS 13 1/2 x 5/20 IN ENGINE SPACE 5/20 IN BOILER SPACE 7/20

BULKHEADS 5/20 STIFFENERS 2 1/2 x 2 1/2 x 5/20 SPACED 30V + 48 H

KEEL 6 x 1 1/8" STEM 6 x 1 1/8" STERN FRAME 5 1/4 x 2 1/4"

RUDDER HEAD 3 1/2" PINTLES 2 MAIN PIECE 2 1/4" PLATE 15/20

ENGINE & BOILER SEAT ANGLES 3 x 3 x 6/20

BUNKERS 3/16" STIFFENERS 2 1/4 x 2 1/4 x 5/20

STRINGER PLATE
20 x 3/20
STRINGER ANGLE
3 x 3 x 8/20

BULB ANGLE 5 x 3"

1'-0"

6 x 6" WOOD RUBBER

1'-0"

0'-0"

0'-0"

SKETCH SHEWING
N^o OF RIVETS IN FORE &
AFT FLANGE OF
KEELSON LUGS
5 x 4 x 3/20 KEELSON

5/20

5/20

— RIVETING —

BUTTSTRAPS OF SHEERSTRAKE
DECK STRINGER ONE BILGE STRAKE
FOR 2 L TO BE 20" THICKER & DOUBLE RIVTD.
RIVETS THRO. FRAMES & FLOORS BOILER
SPACE 3/4" PITCH 5 1/4" ELSEWHERE 5/8" PITCH 4 1/2"
RIVETS THRO. SIDE & BILGE KEELSON 3/4"
RIVETS THRO. SHEERSTRAKE 5/8" REMAINDER
OF SHELL 5/8"

2Q2

J.H.L.
15/6/05




© 2013/6/05
Lloyd's Register
Foundation

002094-002100-0169


Poderoso

Com. 5999

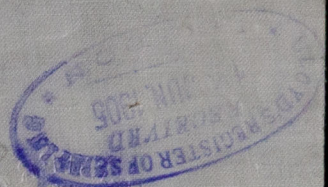

RETAIN

RETAIN

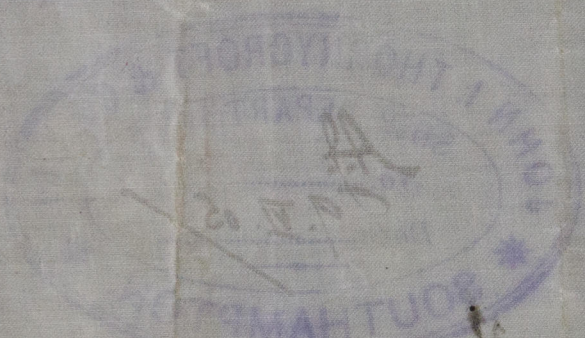







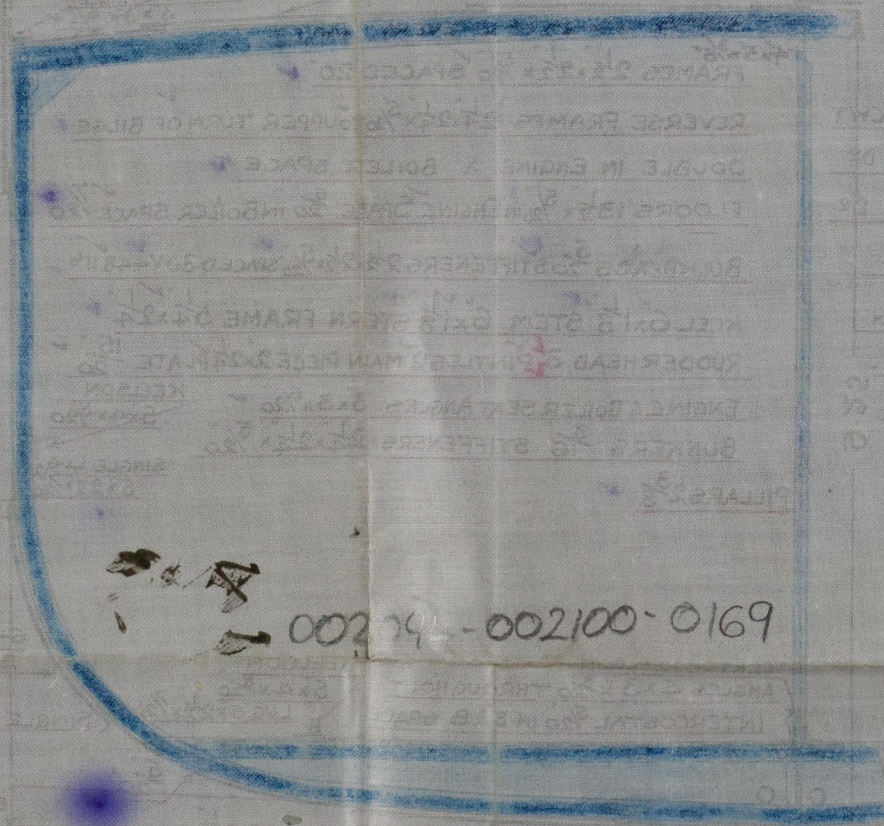












© 2020
Lloyd's Register
Foundation