

61 SHIP CO.

S. S. N° 507-S

MIDSHIP SECTION.

SCALE 1/2 INCH = ONE FOOT.

CLASS. 103A- with freeboard corresponding to a summer moulded draught of 18'-0"

DIMENSIONS

LENGTH (L)	310'
BREADTH (B)	42'
DEPTH (D)	26'
DRAFT (A)	18'

#### HOLD FRAMES








STEM: S° = 2° STERNFRAME: S° = 6° (Bolt Boss) CLASHWHEEL  
T° = 10° INCREASED AS PER RULE

RIBBON AS PER RULE FOR SPACER OF 12 KNOTS  


















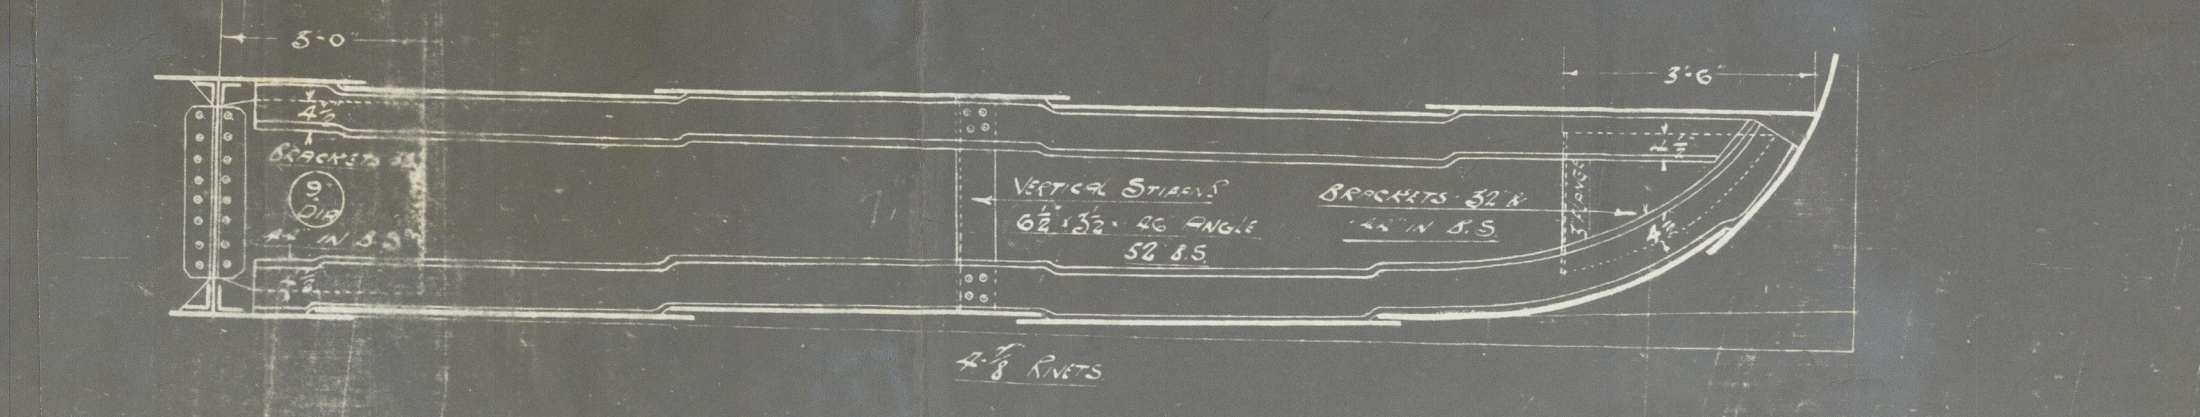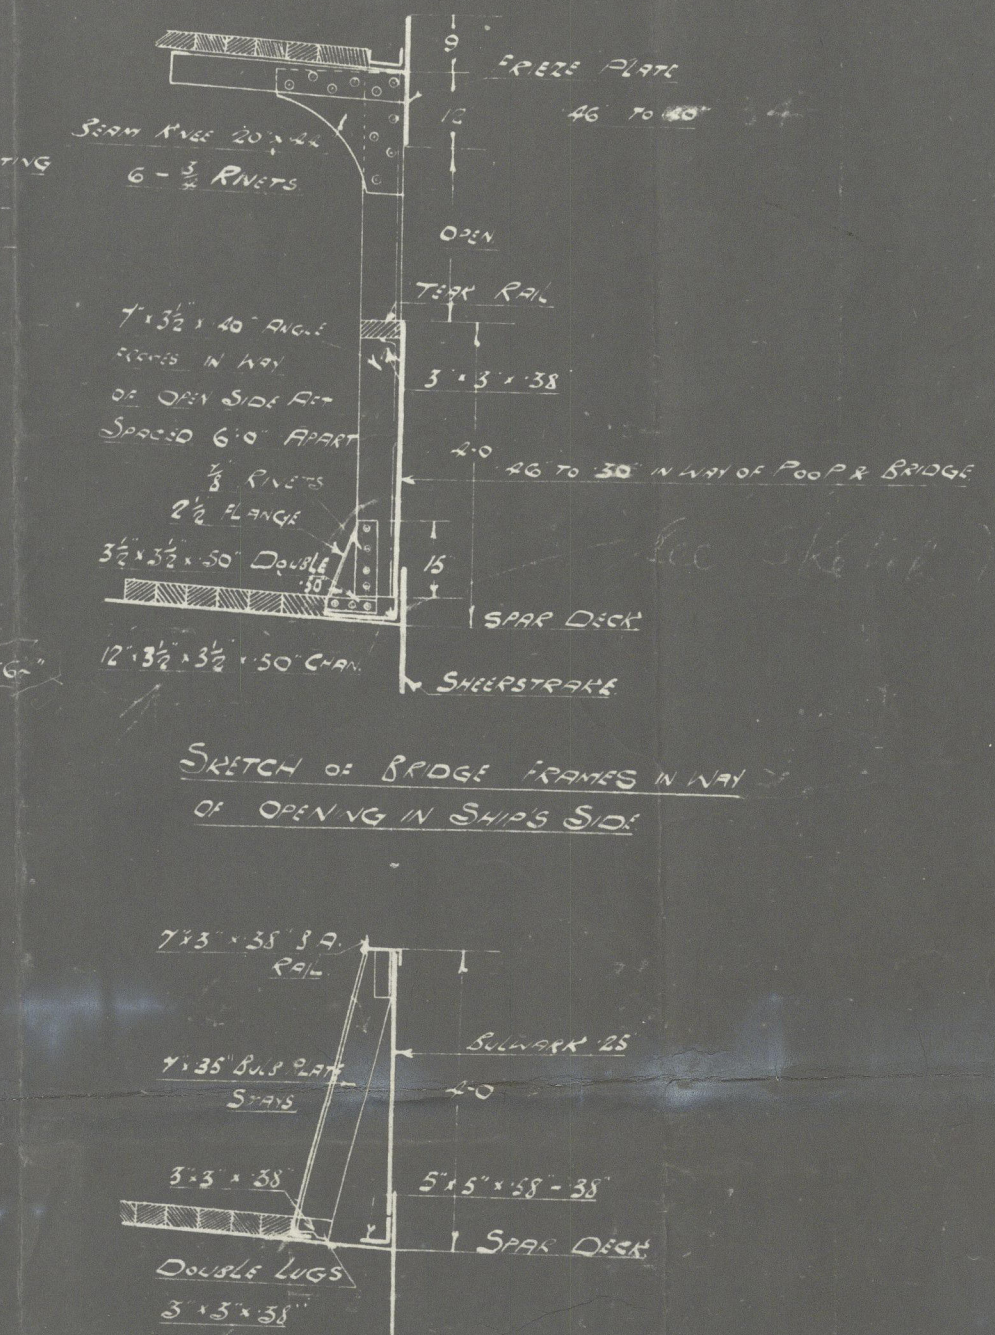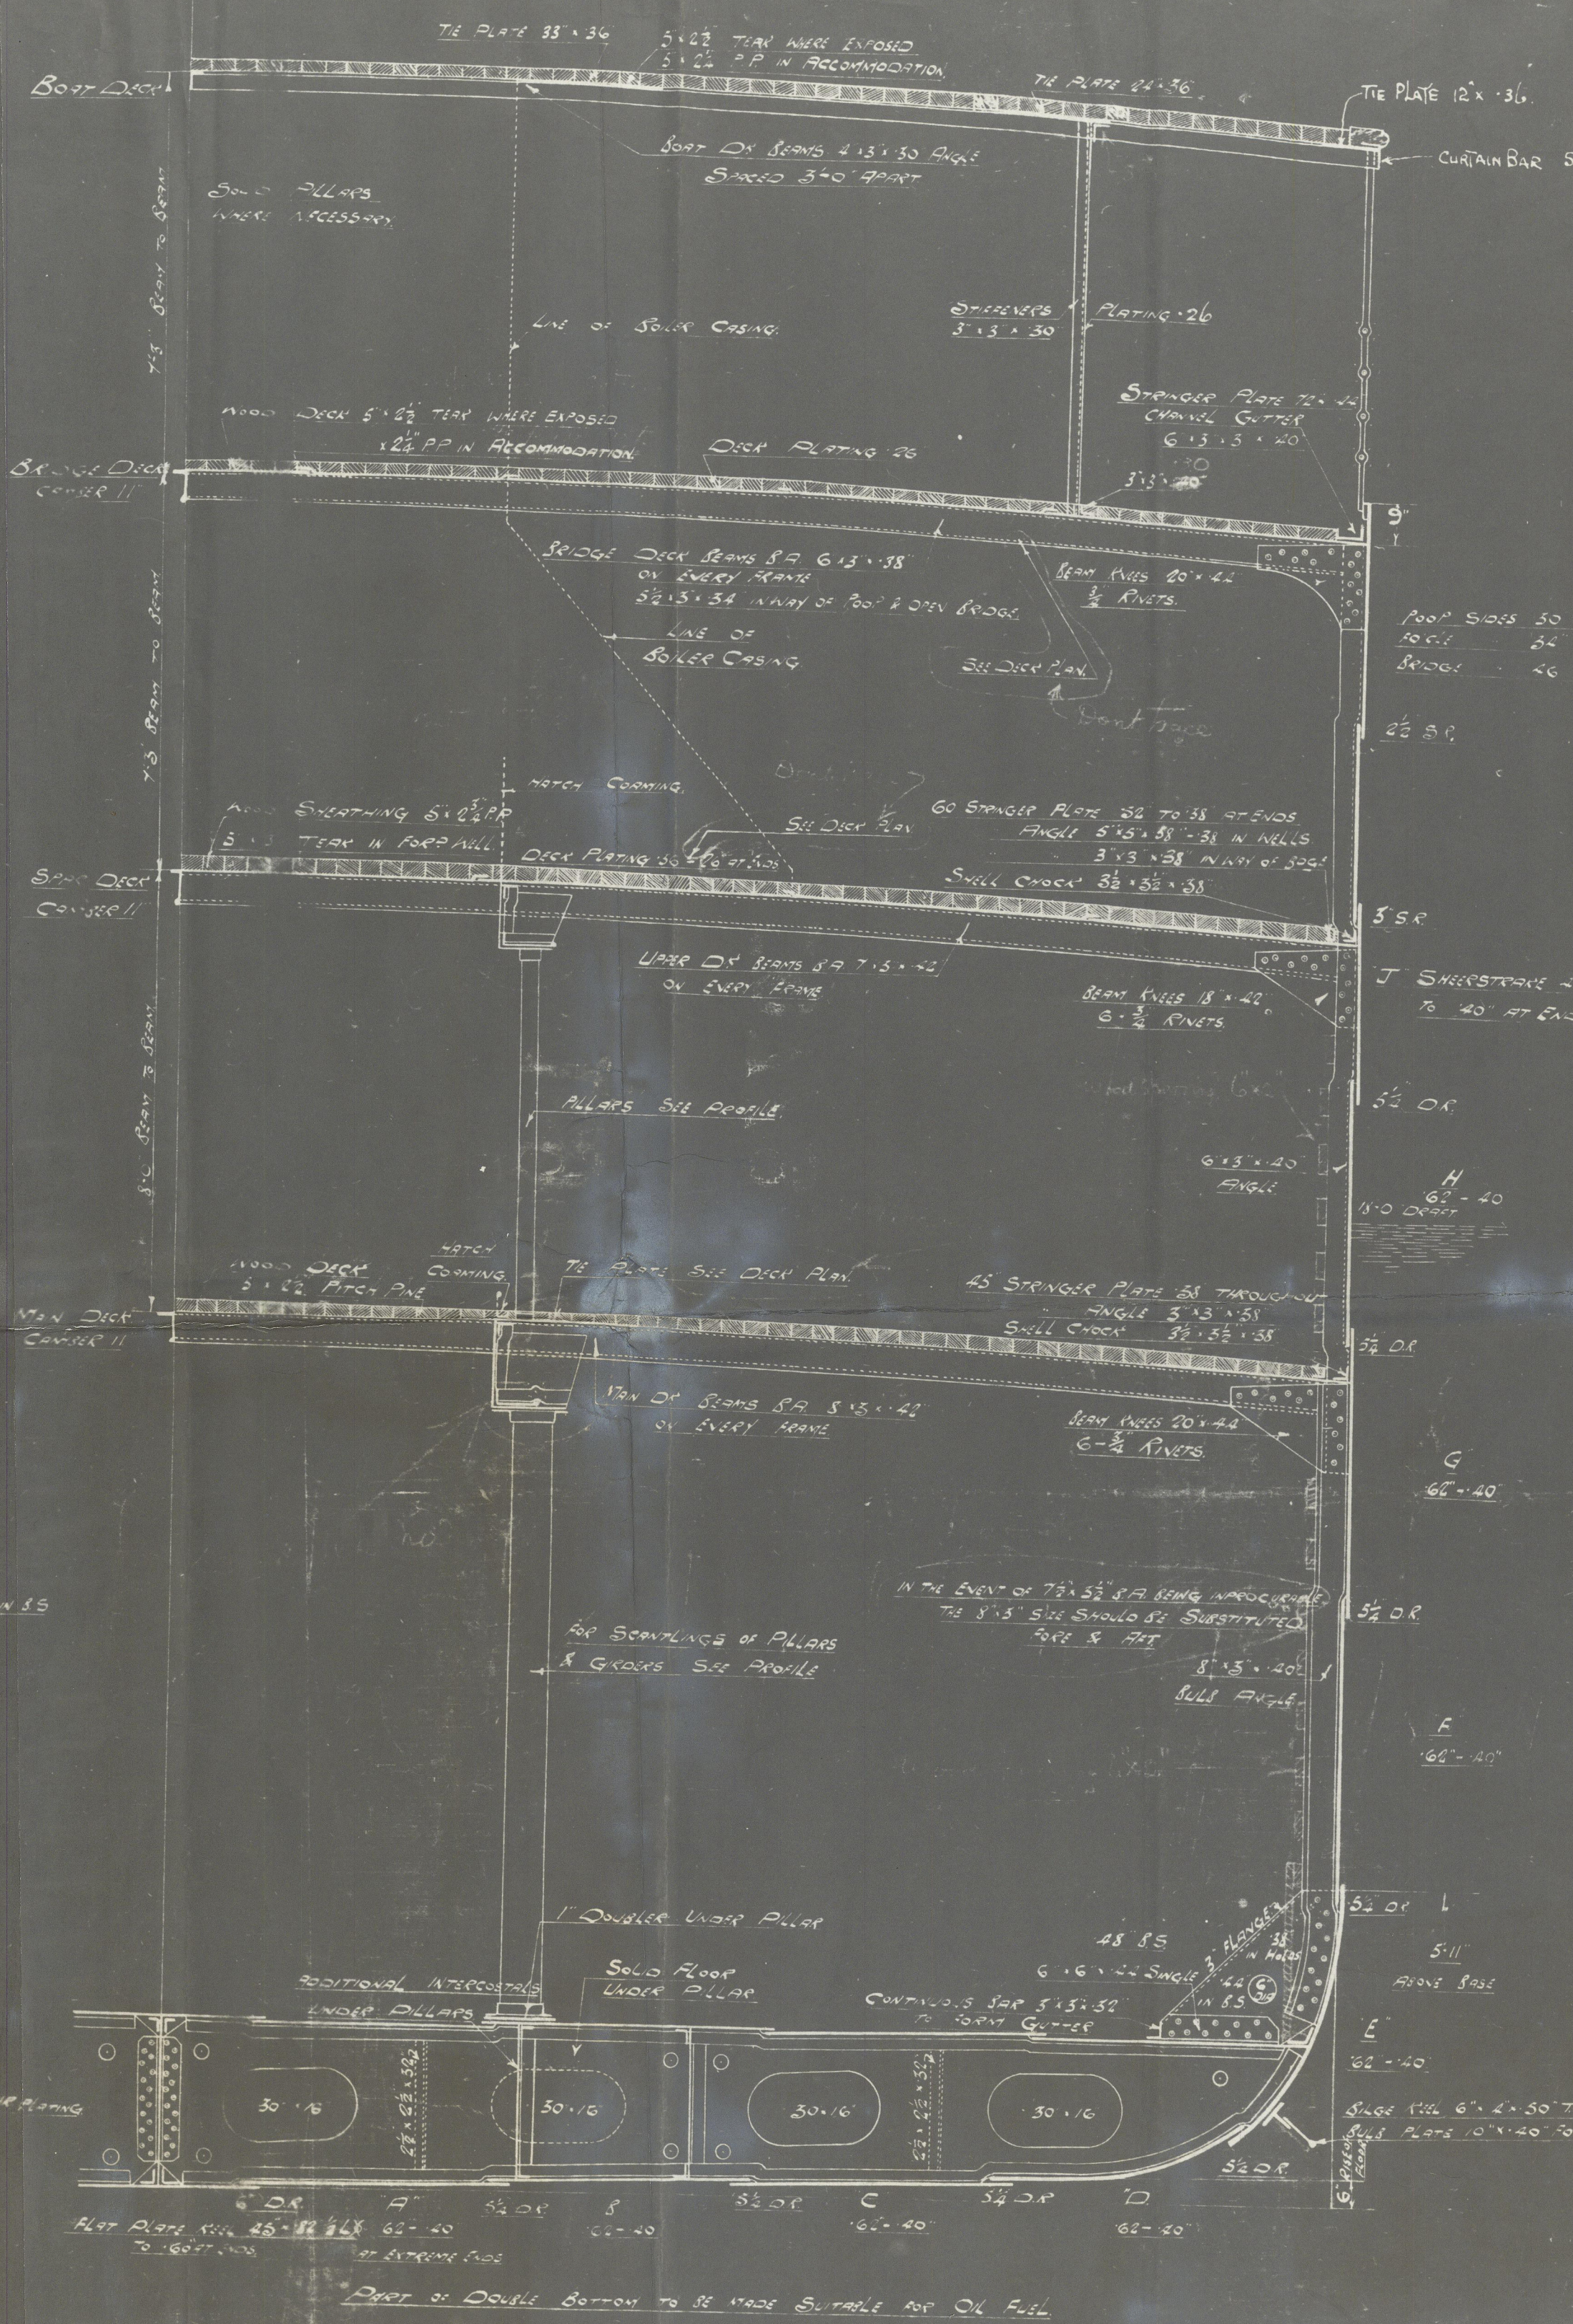


SECTION IN WAY OF BRACKET FLOOR  
POSITION AS SHOWN ON PROFILE



"KILWA" \* "KIUNGCHOW"

Midship section

Born. Rpt. No. 8476

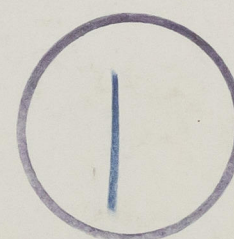

Midship Section

002094-002100-0302



© 2020

Lloyd's Register  
Foundation