


BOAT DECK

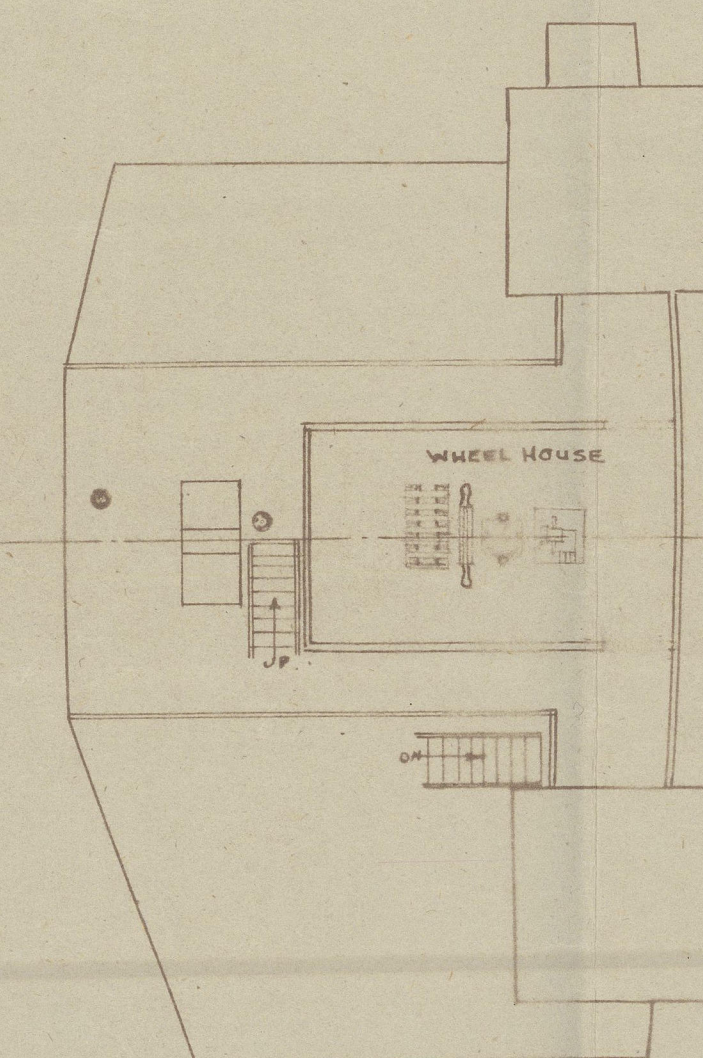


NAVIGATING BRIDGE


S.S. KILWA
GENERAL ARRANGEMENT.

SCALE $\frac{1}{8} = 1-0$


ALTERATIONS NOT SHOWN IN RED.

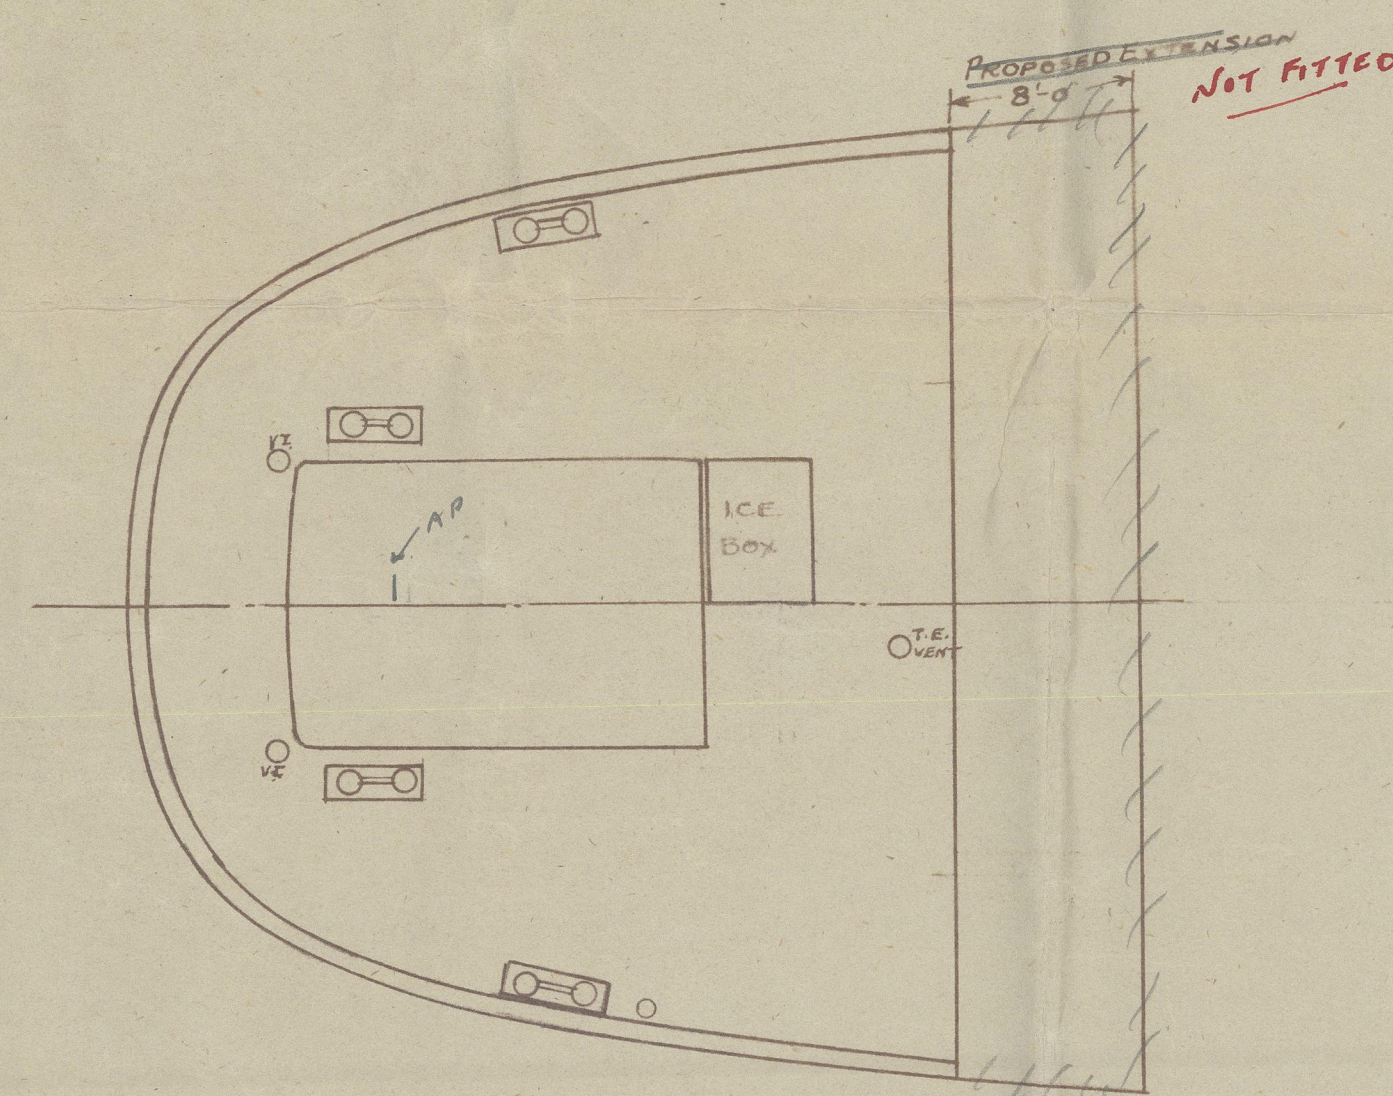


POOP DECK

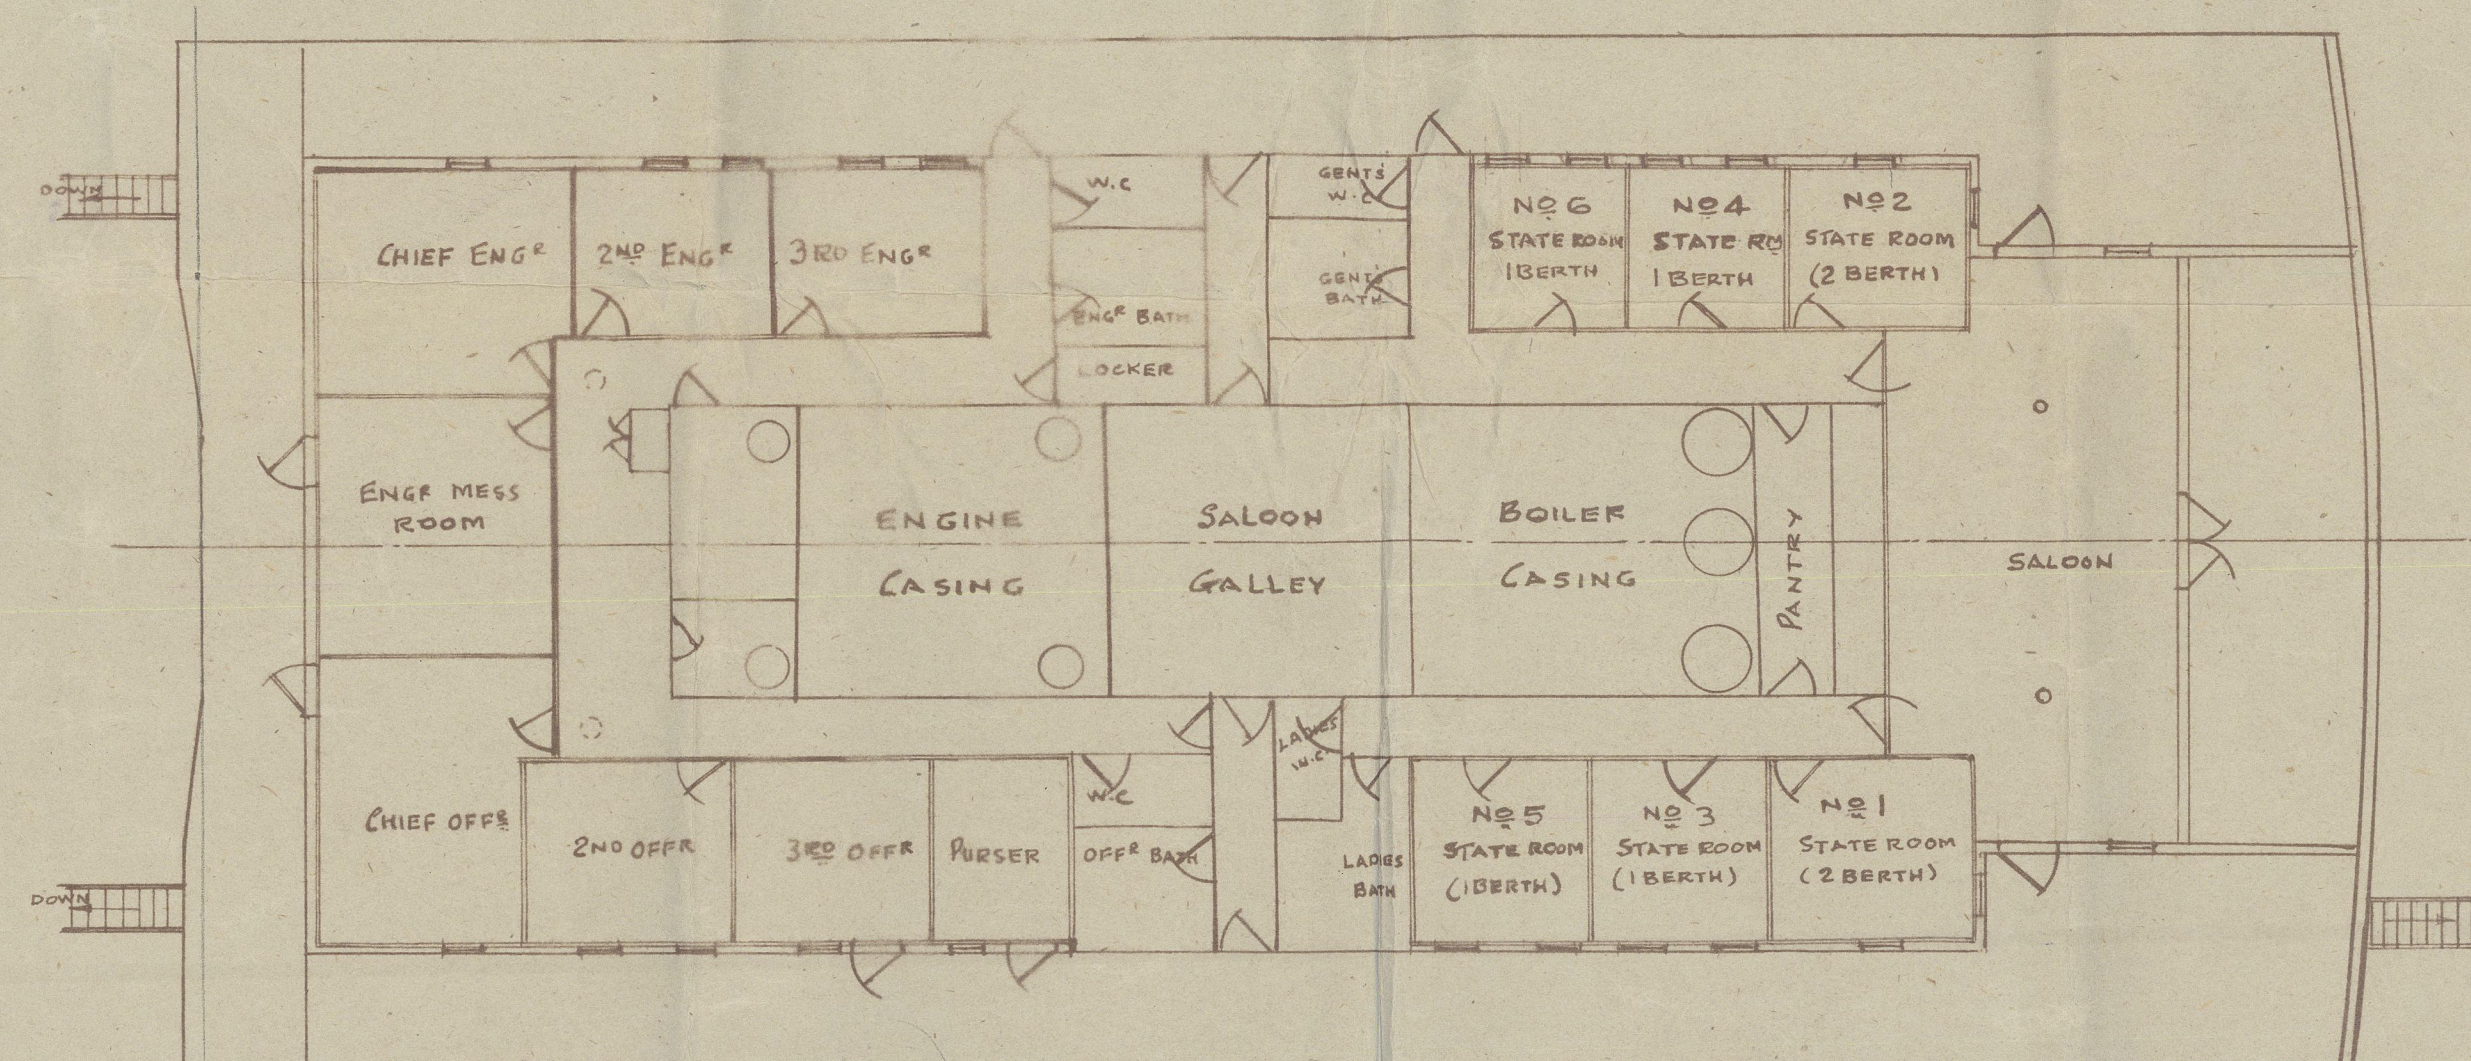


PROMENADE DECK

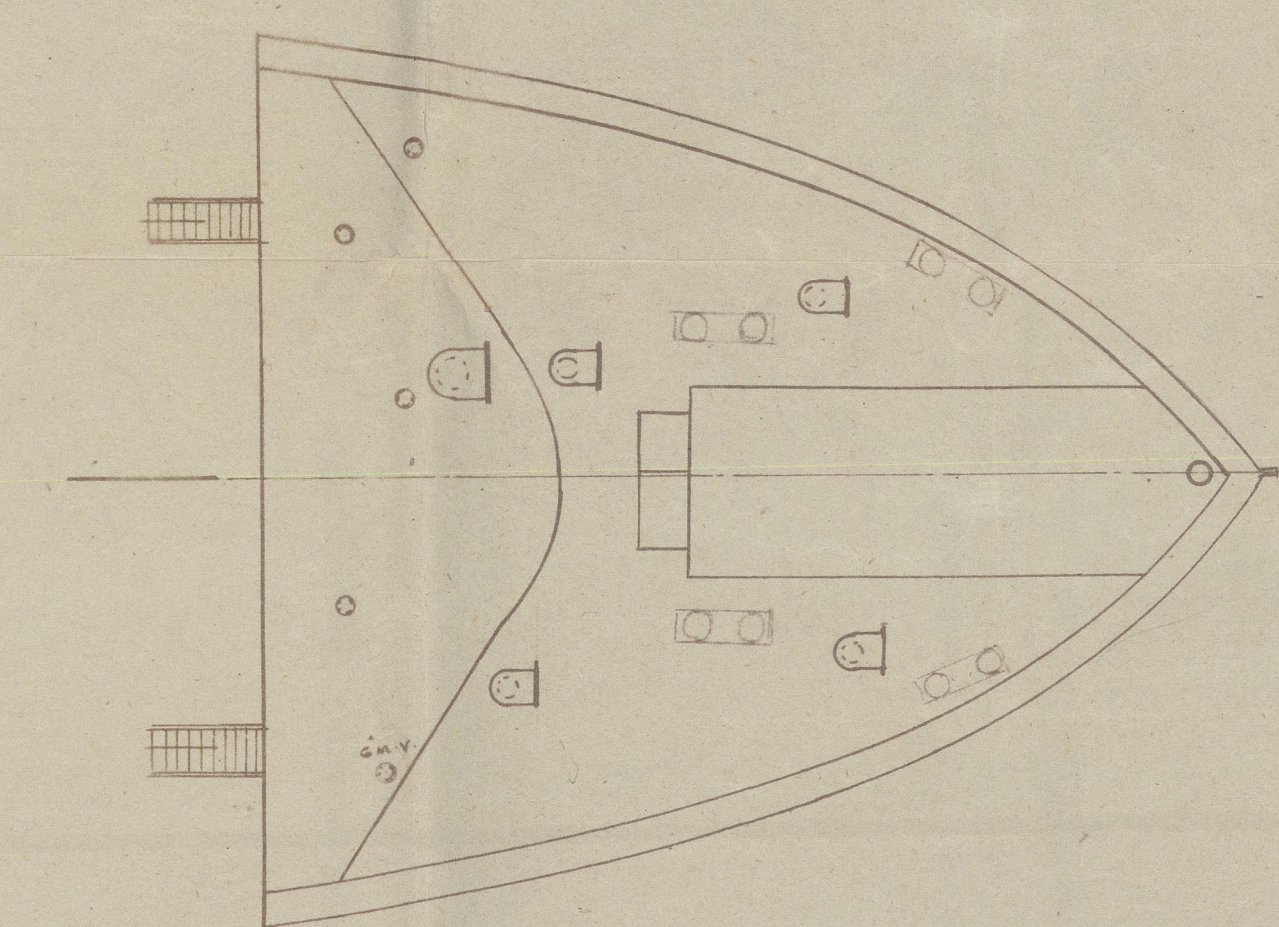

FORECASTLE DECK

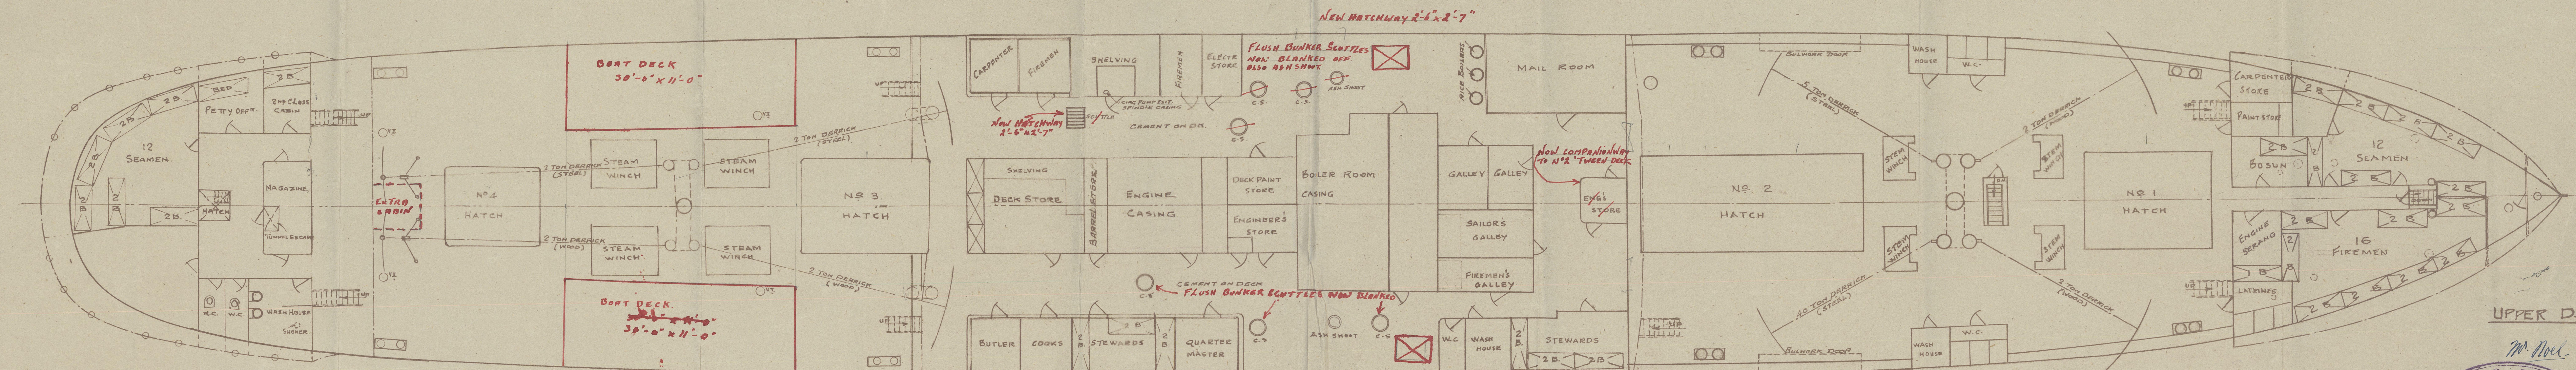

UPPER DECK

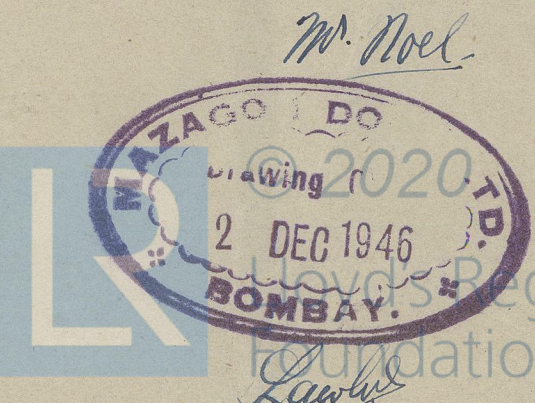

S. S. "KILWA" (EX KIUNG CHOW) *

GEN: ARRGT. (PLAN.)

Bombay Plt. No. 8476

3

002094-002100-0304



© 2020

Lloyd's Register
Foundation