

Lloyd's Register of Shipping.

23 FEB 1953

Ship's Name S.S. "KILWA"

Official No. 146136

Memorandum of alterations reported since ship was surveyed for assignment of Load Lines in 1947.


Two trimming hatches have been fitted in No. 3 Tween Deck.

These openings are provided with substantial wood coamings bolted to the deck beams.

Height of coamings above the deck beams 3".

Hinged wood covers with locking bars are provided.

Location and size of Trimming Hatches indicated on diagram below.

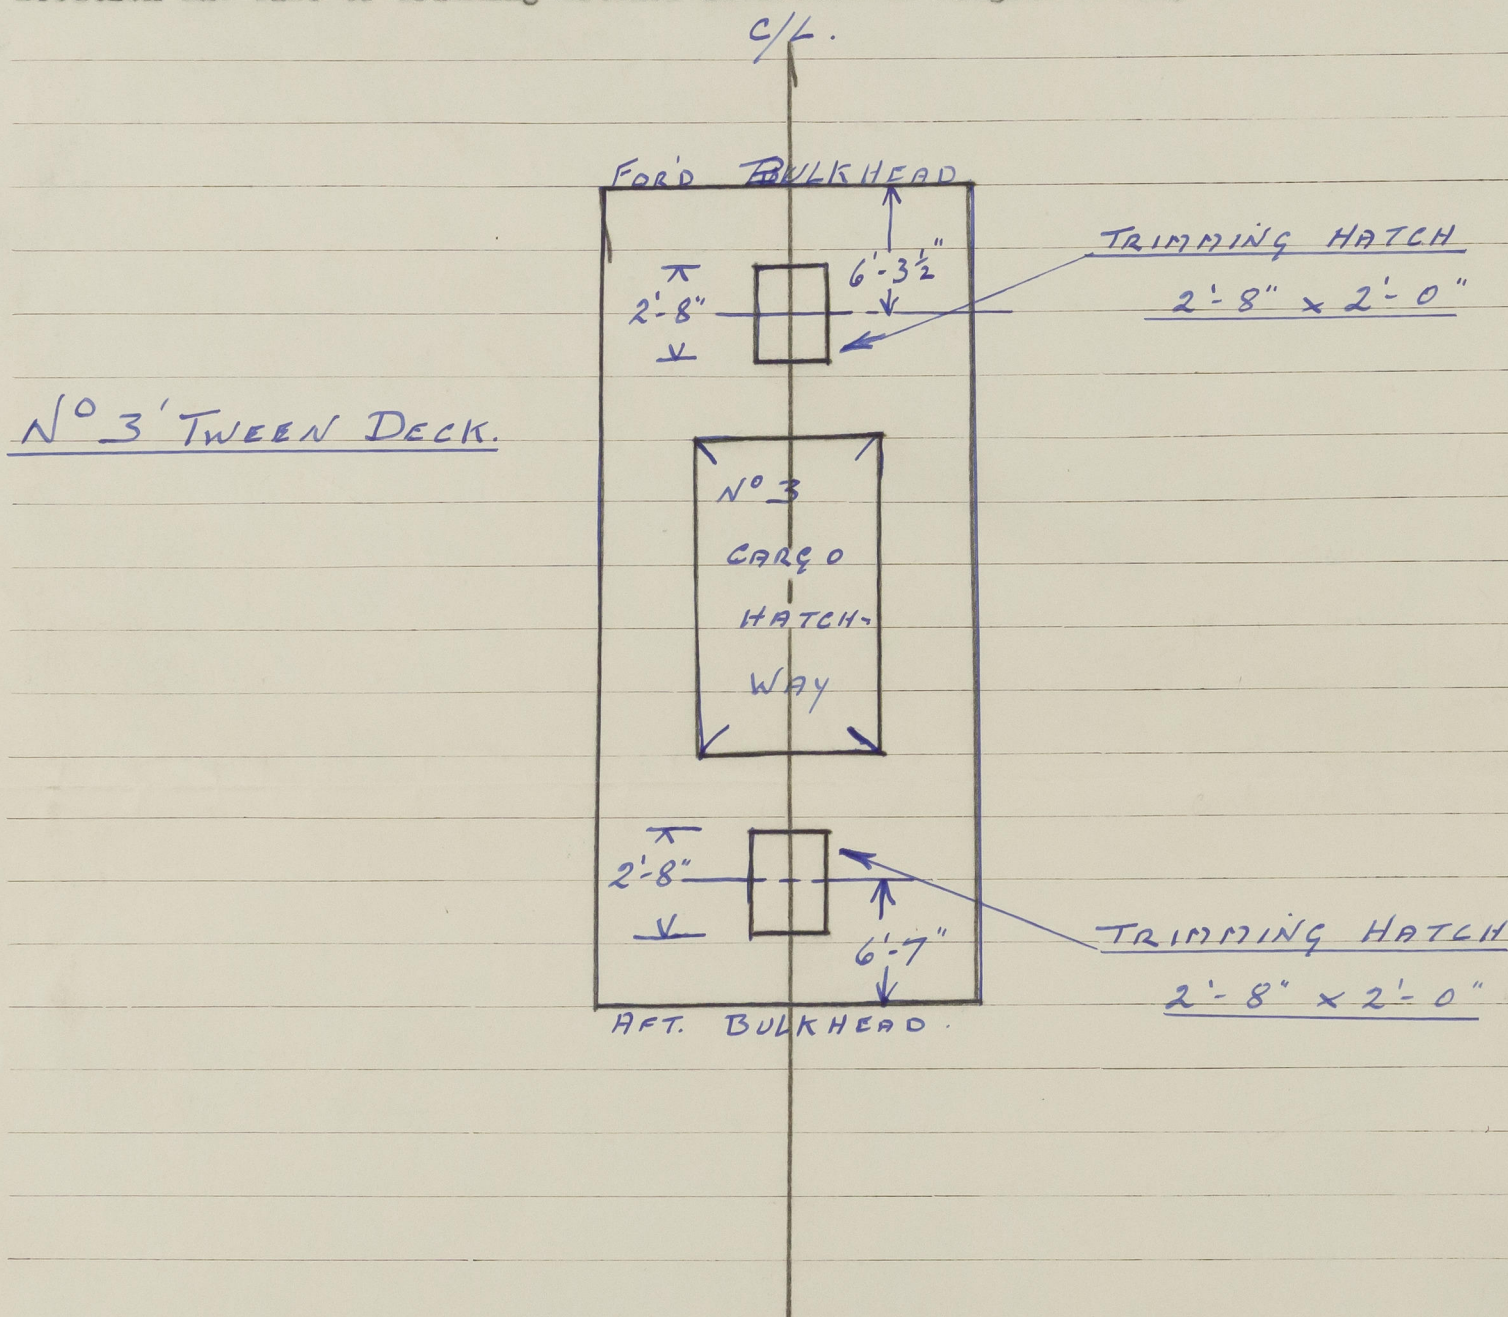

T.H. Noël
Darban.

2nd February, 1953.

hc

26 FEB 1953



© 2020

Lloyd's Register
Foundation

002094-002100-0329