
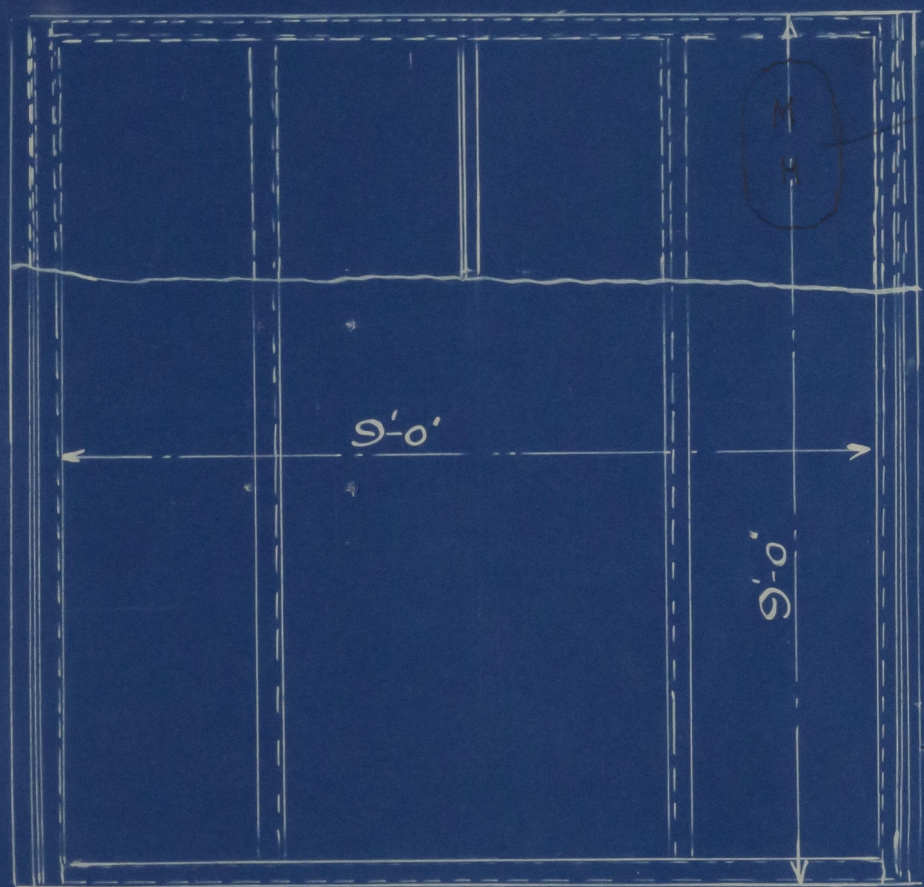
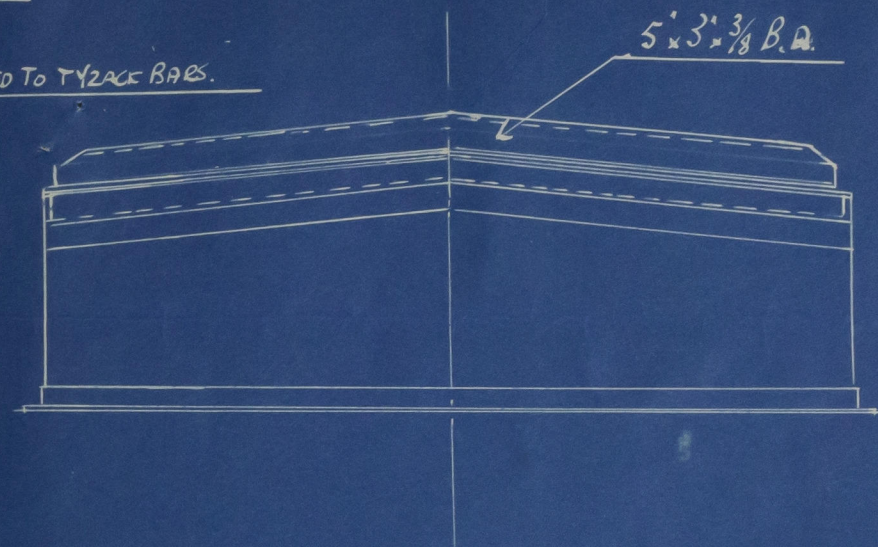


32' 9"

M/V "CLYDEFIELD"  
 PROPOSED ALTERATIONS TO FORD HATCH.  
 SCALE -  $\frac{1}{2}$ " = 1 FOOT.

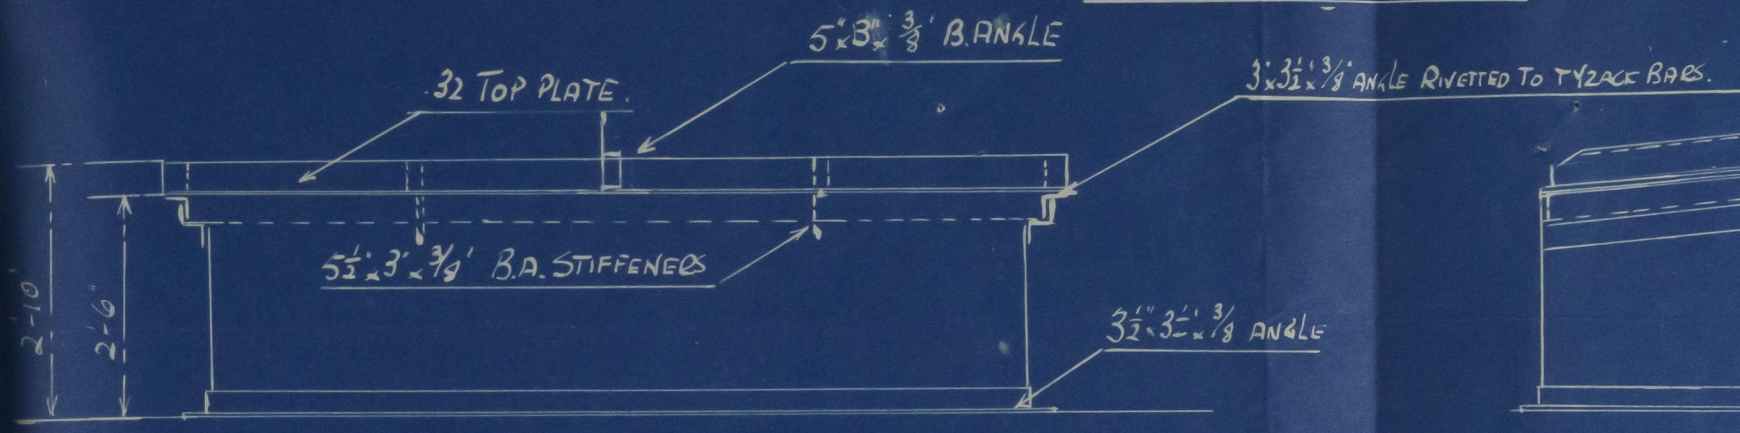

Sketch across plate

FORD

9/2/23

