


-T.S.M.V. "ENERGIE"-

-GENERAL ARRANGEMENT.-


-DIMENSIONS 150'-0" BP x 27'-6" x 10'-9" ML<sub>0</sub>-

-SCALE 1/4"=1 FOOT.-


-AS FITTED.-

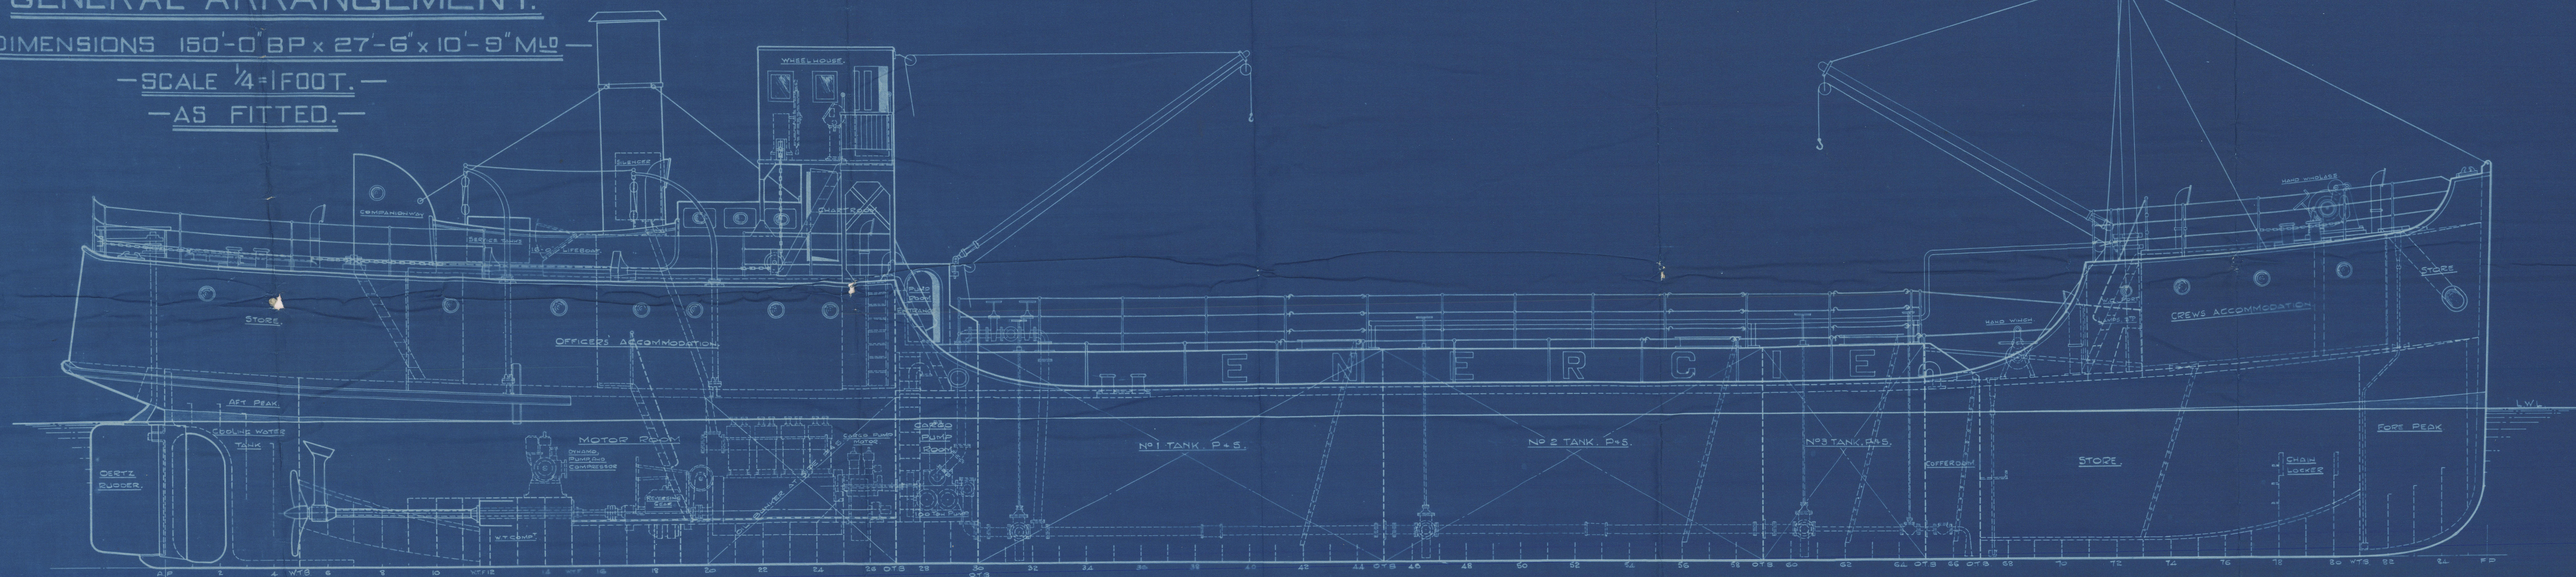


POOP DECK.

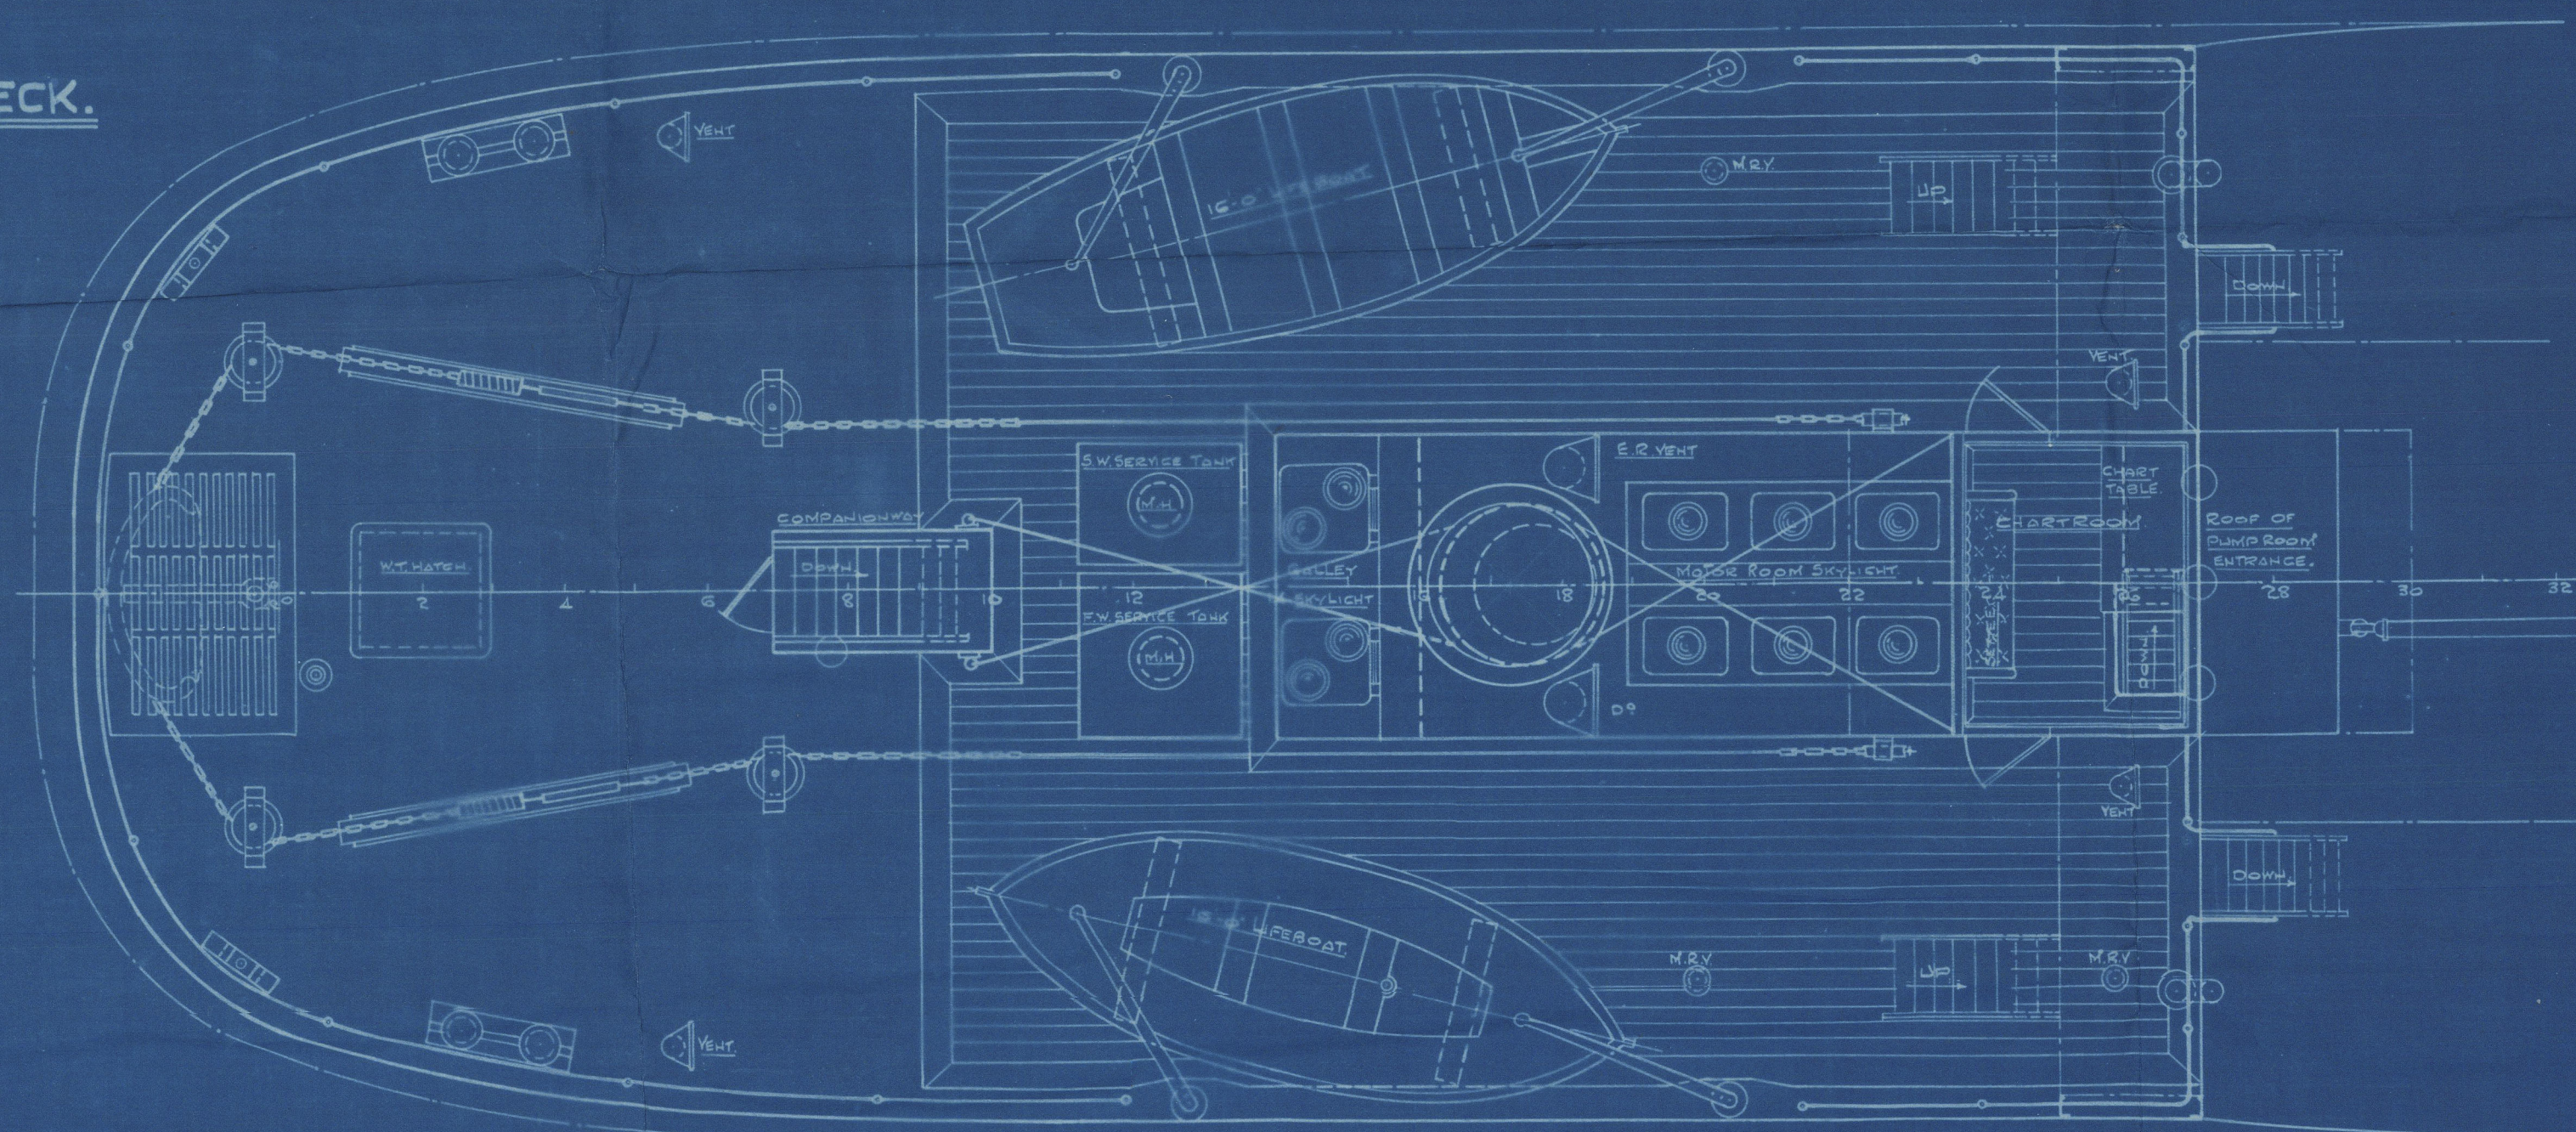


FLYING BRIDGE.

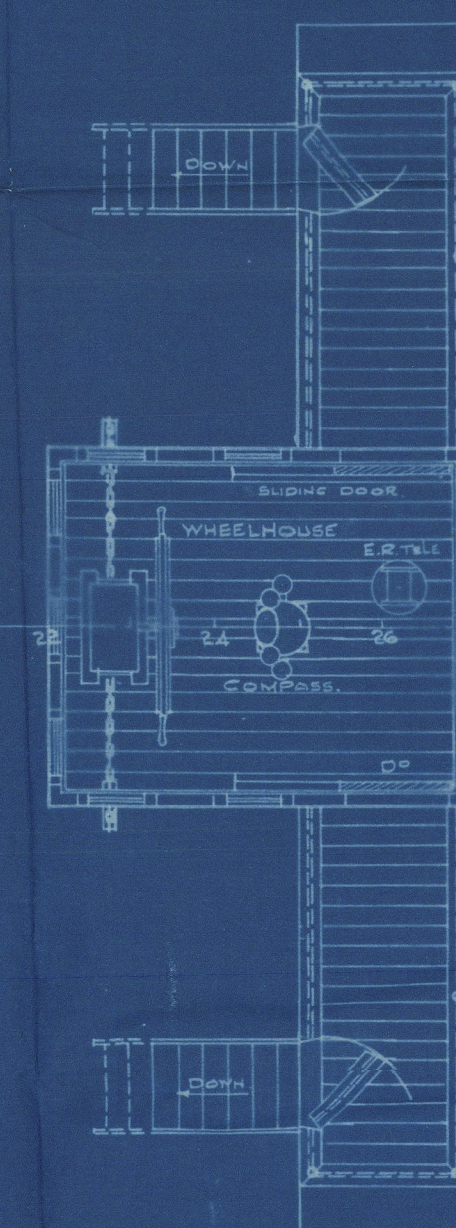

FORECASTLE DECK.

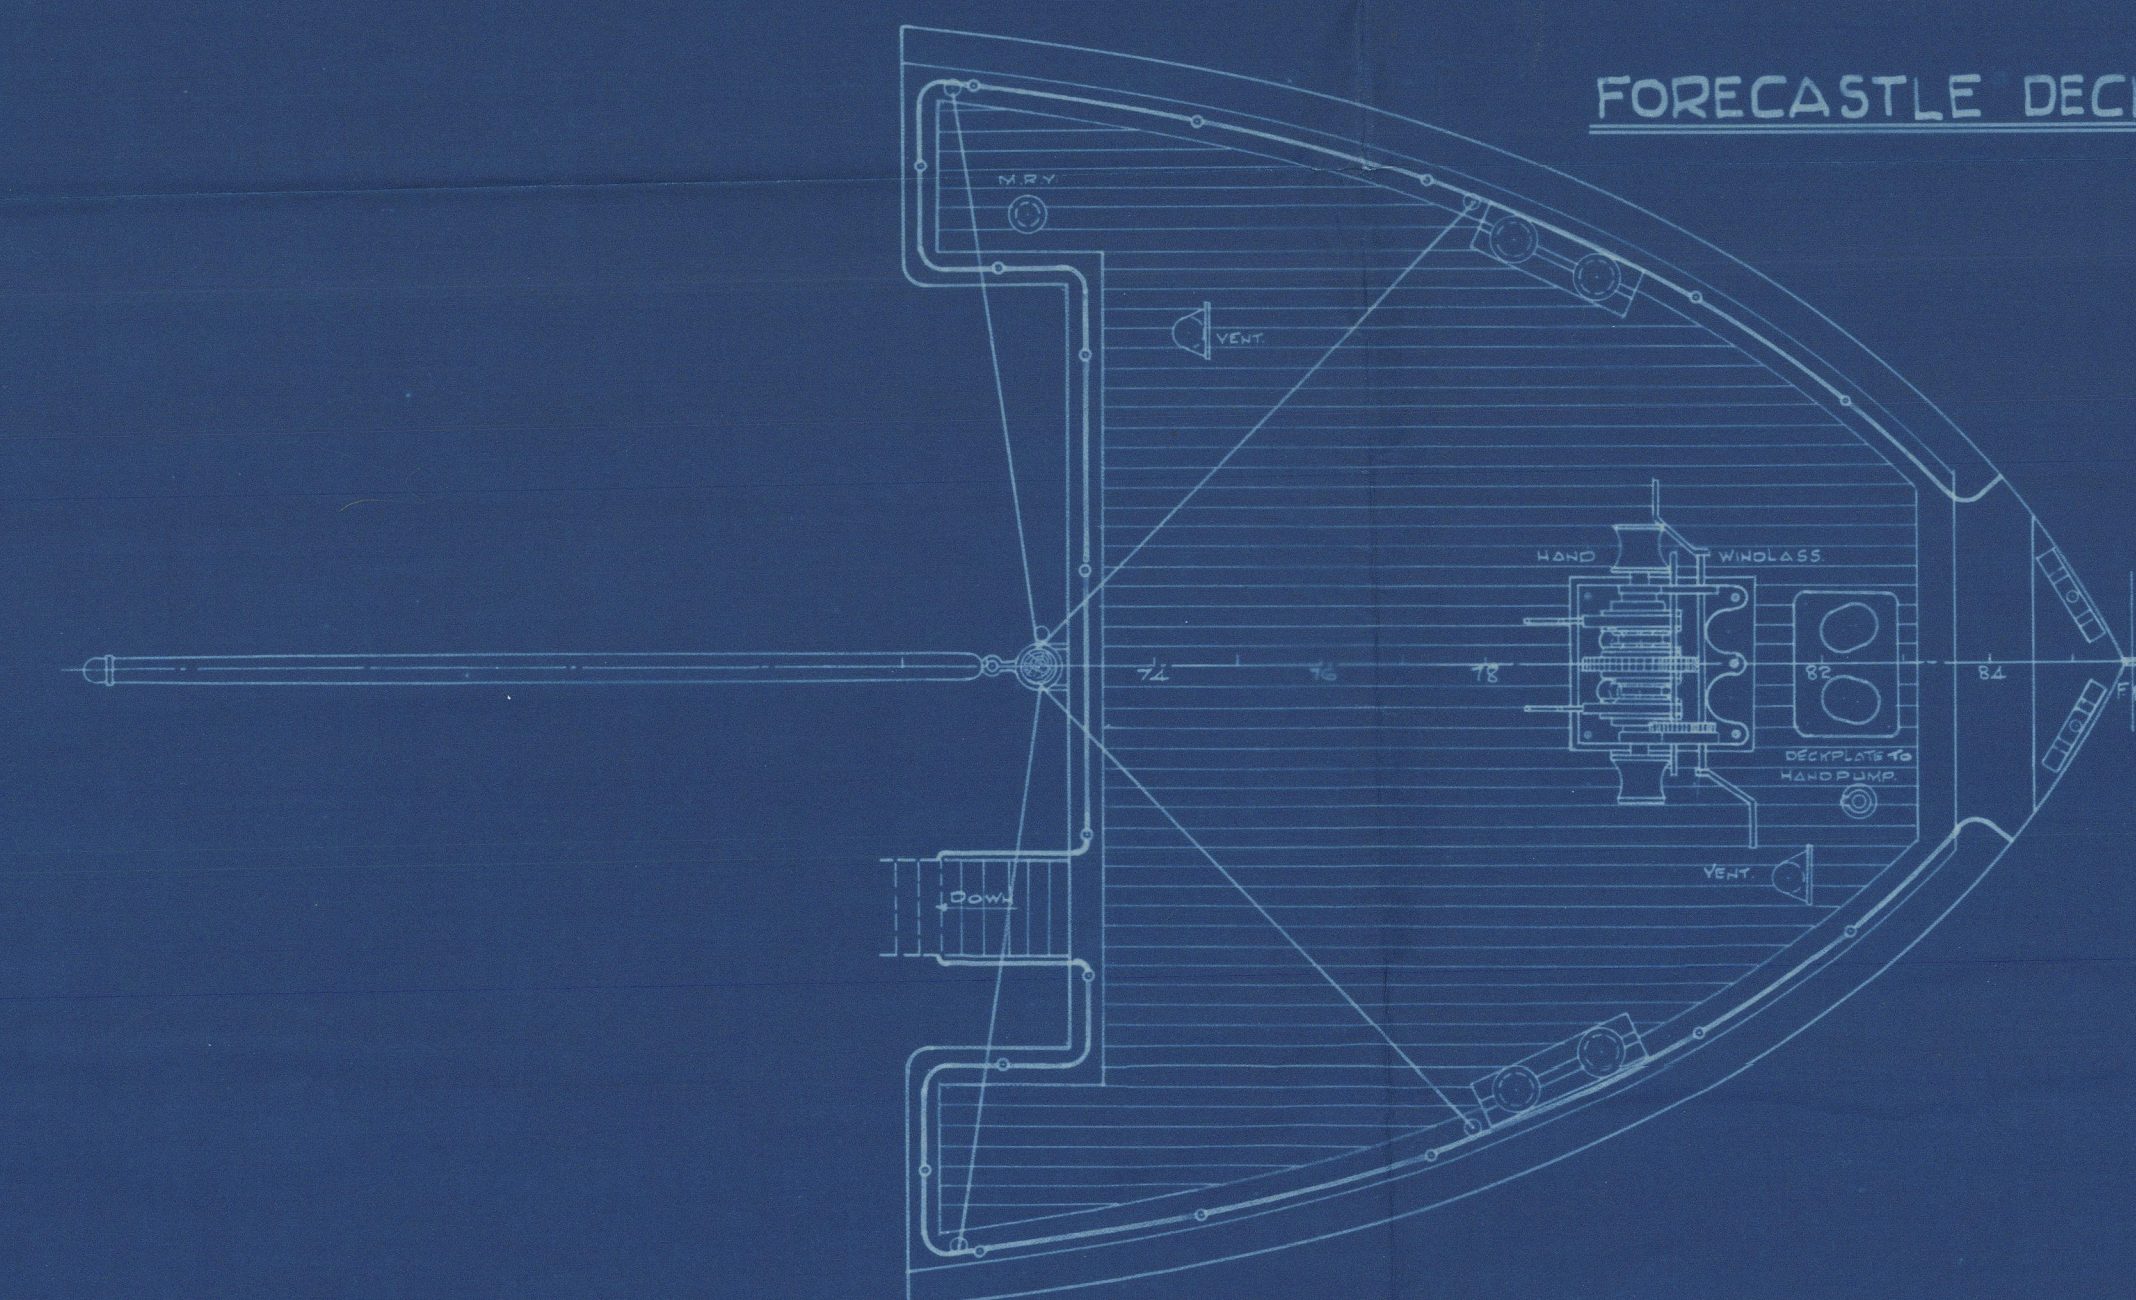

UPPER DECK.

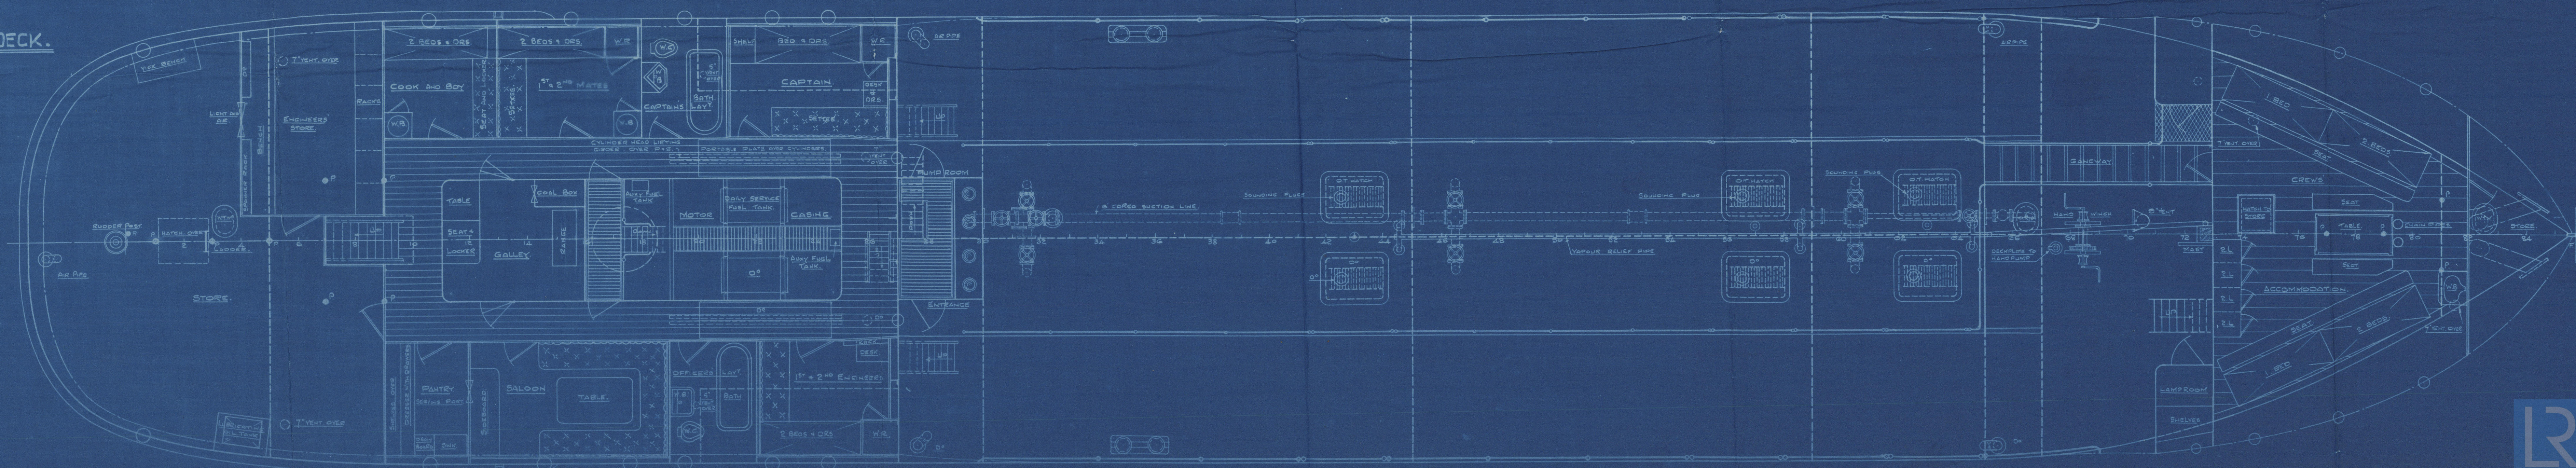



General Arrangements built:

Merron Abadie + Mitchell

Jan N° 5355

S. S. *Energie*

LIVERPOOL

Report No. *94350*



© 2020

Lloyd's Register  
Foundation

002101-002108-0187