


26/1/28

POOP, FORECASTLE, AND UPPER DECK PLATING.

SCALES:- $\frac{1}{4}" = 1 \text{ FOOT.}$
 $1" = 1 \text{ FOOT.}$

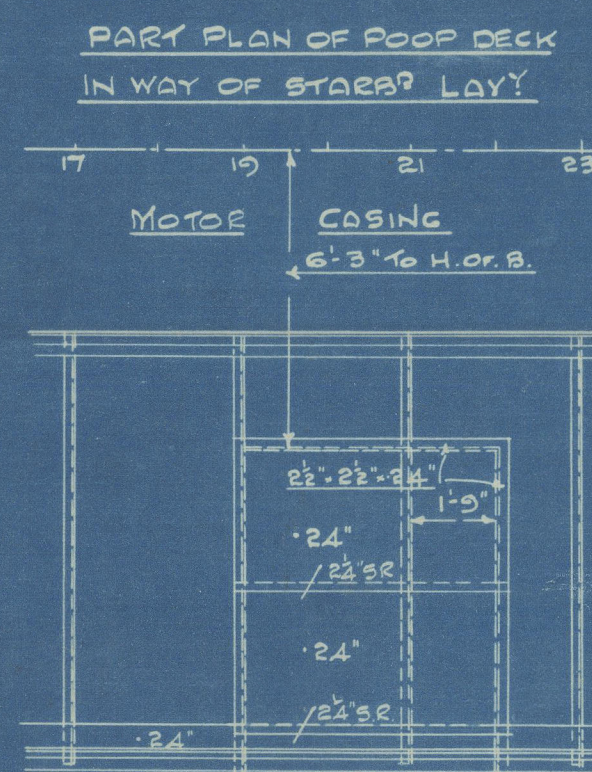

POOP DECK.

UPPER DECK.

DETAIL OF BEAM CONNECTION TO
SIDE OF OIL TRUNK, UPPER DK.

DETAIL OF BEAM CONNECTION
TO MACHY: CASING, UPPER DK


DETAIL OF BEAM CONNECTION
TO MACHY: CASING. POOP DECK

FORECASTLE DECK.

Pop, Tide & M. M. M.

W. M. & M. M.

Jan 20 5.35

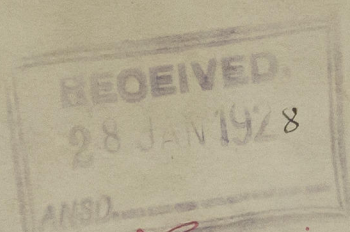

S. S. *Energie*

LIVERPOOL.

Report No. *94350.*

10/11

12/40

002/01-002108-0188



© 2020

Lloyd's Register
Foundation