

1 AUG 1928

In

Register of Shipping.

FOR FREEBOARD.—STEAM SHIPS.

APPLYING TO ALL STEAM SHIPS EITHER FLUSH DECKED, OR WITH
FORECASTLES, SHORT POOPS AND BRIDGE HOUSES DISCONNECTED, OR
GALLANT FORECASTLES, HAVING LONG POOPS, OR RAISED QUARTER DECKS
CONNECTED WITH BRIDGE HOUSES, OR OTHERWISE.

Port of Survey

Singapore

Date of Survey

Wharf Building

Name of Surveyor

Geo. P. P. L.

POWER PETROL

Ship's Name.

Port of Registry
and Nationality.
*Rochester
British*Official
Number.
*160692*Gross
Tonnage.
*✓*Date of Build.
*1928.*Particulars of Classification.
*100 Gt. Carrying Petrol in Bulk
Contemplated.*

Number in Register Book

Registered dimensions from Ship's Register.	LENGTH.	BREADTH.	DEPTH.	UNDER DECK TONNAGE.
	150.2.	27.6	10.2.	300.19.
Length on LOADLINE.	150.2.	Frame Depth 4 Rule 3 $\times 2 = -1.14$ No sparring + .33	Ceiling + .20 Sheer - .11	Peak { <i>fuel</i> . Tanks
CORRECTED DIMENSIONS.	150.2	27.76	10.29	300.19

Co-efficient of fineness.....

.40 ✓

Any modification necessary [Para. 4 (a) to (e)]*

✓

Co-efficient as corrected

*.40 ✓*Sheer { Stem..... *43* } *67* - $\div 2 = 33\frac{1}{2}$... Mean *11* ✓at { Sternpost ... *24* } *23* - $\div 2 = 11\frac{1}{2}$... Mean *14* ✓Sheer at $\frac{1}{3}$ of the length from { Stem *14* } *23* - $\div 2 = 11\frac{1}{2}$... Mean *9* ✓Gradual mean Sheer *20.91* $\div .55 = 20.91$ Standard mean Sheer [Table, Para. 18] *25.02* CorrectionDifference *4.11* $\div 4 = 1.02$ § If limited as Para. 18 (f) *+1" ✓*Rise in Sheer { At front of bridge house.....
from amidships } At after end of forecastleFall in Sheer { Para. 18 (d) } $\div 2 =$

Length uncovered Correction

ALLOWANCE FOR DECK ERECTIONS :—

Freeboard, Table C.....

0 - 2 1/4

Correction for Length, if required (Para. 12, 13, and 14)

+ 1

Freeboard by Table A. corrected for sheer, and for length, if required (Para. 12, 13, and 14)

0 - 3 1/4

Difference

1 - 8 1/2

Percentage as below.....

*1 - 5 1/4**36.16%**6.24*

Correction for R. Q. Dk. if engine and boiler openings not covered by bridge house (Para. 11)

- 6 1/4

Allowance for Deck Erections

- 6 1/4

Length.....

*Length.**Length allowed.**Height.*

Forecastle.....

*22.25 + S.H.**23.40**7.5*

Bridge House.....

*83.5 x 12.0 x 2.25 x 8 x 1/10 2 = 12.19**2.69**2.5'*

+ Raised Q. Dk.

*✓ 27.5**47.25**7.5*

Poop.....

*47.25**82.84**.552*

Total

150.2

Length of Ship

Corresponding percentage { (Para. 11, 12, 13, or 14) }

*36.16% ✓*FREEBOARD recommended amidships from centre of Disc to top of Statutory Deck Line, ~~W.M.~~ (Steel) Deck :—

Fresh Water Line above centre of Disc

Indian Summer Line " " "

Winter Line below " " "

Winter North Atlantic Line " " "

8 AUG 1928

MARKING FORM

21 AUG 1928

RECEIVED

NOTE.—If the depth is measured when vessel is afloat, the details of measurement should be reported.

Moulded Depth as measured..... *10.75* ✓

... 10.9

Addition for Keel below base line for draught record..... ✓

inches.

CORRECTION FOR LENGTH.

Length of Ship on Loadline..... *150.2.*Length in Table *129.0*Difference *21.2*Correction for 10ft., Table A *.9* Table C. .5x Difference divided by 10 *1.908* (if required.)If $\frac{1}{10}$ ths length covered divide by 2 *+2" ✓*

+1" ✓

P. T. C. = .470 Trunk = .242 Total = .712

CORRECTION FOR IRON DECK.

Proportion covered, if less than $\frac{1}{10}$ ths length coveredThickness of usual wood deck, less stringer *3" ✓*

- 3"

CORRECTION FOR ROUND OF BEAM.

Breadth at Gunwale amidships..... *27.5*

NOTE.—The round of beam should be reported on the full breadth of vessel at the gunwale.

Round of Beam *7*Normal round..... *6.875*Difference *.125* $\div 2 = .06$

Proportion of Deck uncovered (Para. 19)

Freeboard, Table A

1 - 5 1/2

Correction for Sheer

+ 1

Correction for Length

1 - 6 1/2

Allowance for Deck Erections

- 6 1/4

Correction for Round of Beam

1 - 2 1/4

Correction for fall in Sheer (if any)

- 2

Correction for Steel Deck (if required)

*- 3*Additions for non-compliance with provisions of Para. 11 (d) and (e) $\frac{1}{2}$ *- 8*

Other Corrections (if any)

0 - 11 1/4

Winter Freeboard

0 - 11 1/4

Summer Freeboard

0 - 9 3/4

Indian Summer Freeboard

-

N. A. Winter Freeboard

-

Correction necessary because clearside amidships, measured in accordance with the Statute is not taken at the intersection of the wood on steel deck with side.

+ 1 1/4

Winter Freeboard from deck line

1 - 0 1/2

Summer " " "

0 - 11

Indian Summer " " "


-

N. A. Winter " " "

-

State dimensions of freeing ports area on back of this form.

The Surveyor should state whether the fall in sheer as reported is measured relatively to the straight line of keel or to the water lines. If measured relatively to water line the vessel's draft at time of survey, and also the usual load draft forward and aft should be reported.

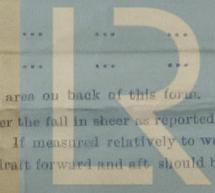

© 2020 Lloyd's Register Foundation

002101-002108-0207

the top height in the Poop ? *Yes.* / Raised Quarter Deck ? *No.* /

Reverse Frames extend ? *No.*

Raised Quarter Deck an efficient Iron Bulkhead at the fore end ? *Yes.*

Particulars of the means for closing the openings in Bulkhead
the Poop or Raised Quarter Deck connected with the Bridge House ? *No openings.*

Give particulars of the means for closing the openings in Bulkhead
Front. What is the thickness of the Bridge Front plating ? *.30* and Coaming plate ? *.34.*

Give scantlings and spacing of the Stiffeners *6 x 3 - .34 O.A.* *about 2' 6" apart.*

Are bracket plates fitted at each end of the Stiffeners ? *Yes.* / Are hor'l. brackets fitted connecting Bridge Bulk'd. with Bulwarks ? *Yes.*

Has the Bridge House an efficient Iron Bulkhead at the after end ? *Yes.*

How are the openings closed ? *Steel*

Is the Forecastle at least as high as the main or top-gallant rail ? *Yes.* / Has the Forecastle an efficient *Iron or Wood* Bulk'd. at all heights ? *Yes.*

Are the Engine and Boiler openings covered by a Bridge, Poop, Raised Quarter Deck, & enclosed by a Strong *Iron or Steel* Deckhouse ? *Yes.*

If the openings are not so protected are the exposed parts of the Casings efficiently constructed ? *Yes.*

Give thickness of plating ; scantlings and spacing of Stiffeners *.24.* *3 - 2 1/2 x .26* *28 - apart.*

What is the height of the exposed Casings ? *2' 6"* Are suitable means provided for closing all openings in them in bad weather ? *The approved.*

Are the Weather Deck Hatchways efficiently constructed and at least equal to the requirements of Section 28 of the Rules for 1904-5 ? Give particulars below :—

* The depth of Fore and Afters should be stated from the underside of the hatches in all cases.

(If the sill of the lowest side scuttle will be less than 6 inches above the Indian Summer Load Line if assigned under the tables, state vertical distance from top of deck at side amidships to lower edge of lowest side scuttle.)

The following information is to be given in all Cases of vessels dealt with under Paras. 11, 12 (under 15 feet Moulded depth) and under Shelter Deck Rules.

What is the thickness of the Bridge Sheerstrake ? _____ Strake between Main and Bridge Sheerstrakes ? _____

Delete the words that do not apply | The Crew ~~are~~, are not, berthed in the bridge house.
The arrangements to enable them to get backwards and forwards from their quarters ~~are~~, ~~are~~, are satisfactory.

Length of Bulwarks in well 80:2

Area of Freeing Ports required by Para. 11 (e) each side of vessel

Area of Freeing Ports required by Part
Et Tenth Et Tenth No


T. B. TELLUS. NO.

80:2

Sq. ft.

for Class
Only


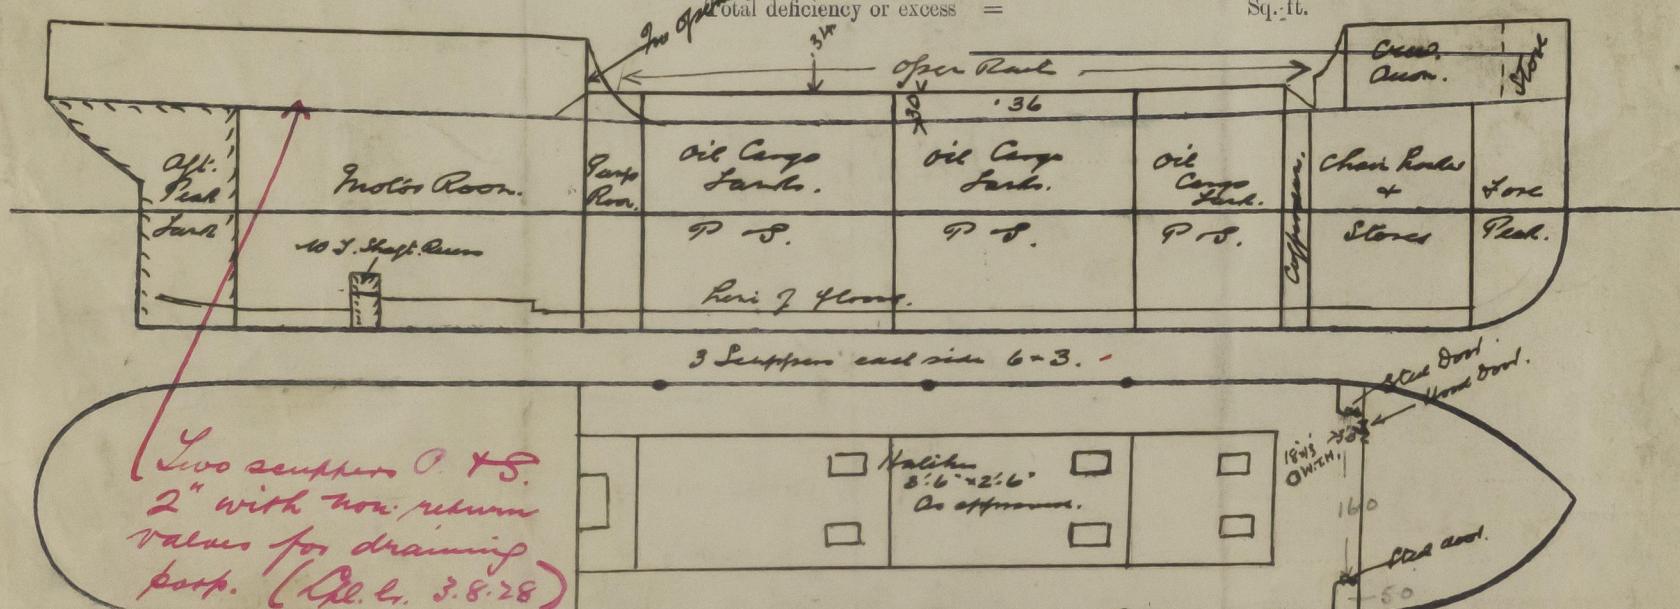

Show hereon line of Floors or Tank Tops with position of any Breaks in same; also height of Peal, Tank tops &c. &c.

State any special features in the construction of the Vessel

Buvel li Corry Petroleum i-Buck.

Builder's name and yard number

J. J. Abbott & Mitchell (1925) fig.

Names of sister vessels

Owners Medway Oil & Storage Co

" Address Grantham, Isle of Grain Kent

Tee £ 2 . 15 . 0

Received by me See F. Report.



© 2020
Lloyd's Register
Foundation