

Lloyd's Register of Shipping.


SURVEYS FOR FREEBOARD.

(CONDITIONS OF ASSIGNMENT.)

 Index No. _____
 (For London Office only.)

Ship's Name SADAKAT Port of Survey ISTANBUL
 Official Number _____ Surveyor's Signature [Signature]
 Nationality and Port of Registry TURKISH ISTANBUL Date of Survey 3/15 1/6 & 9/6 1954

Disposition and dimensions of superstructures, trunks, deckhouses and machinery casings to be inserted in the diagrams and tabular statement :—

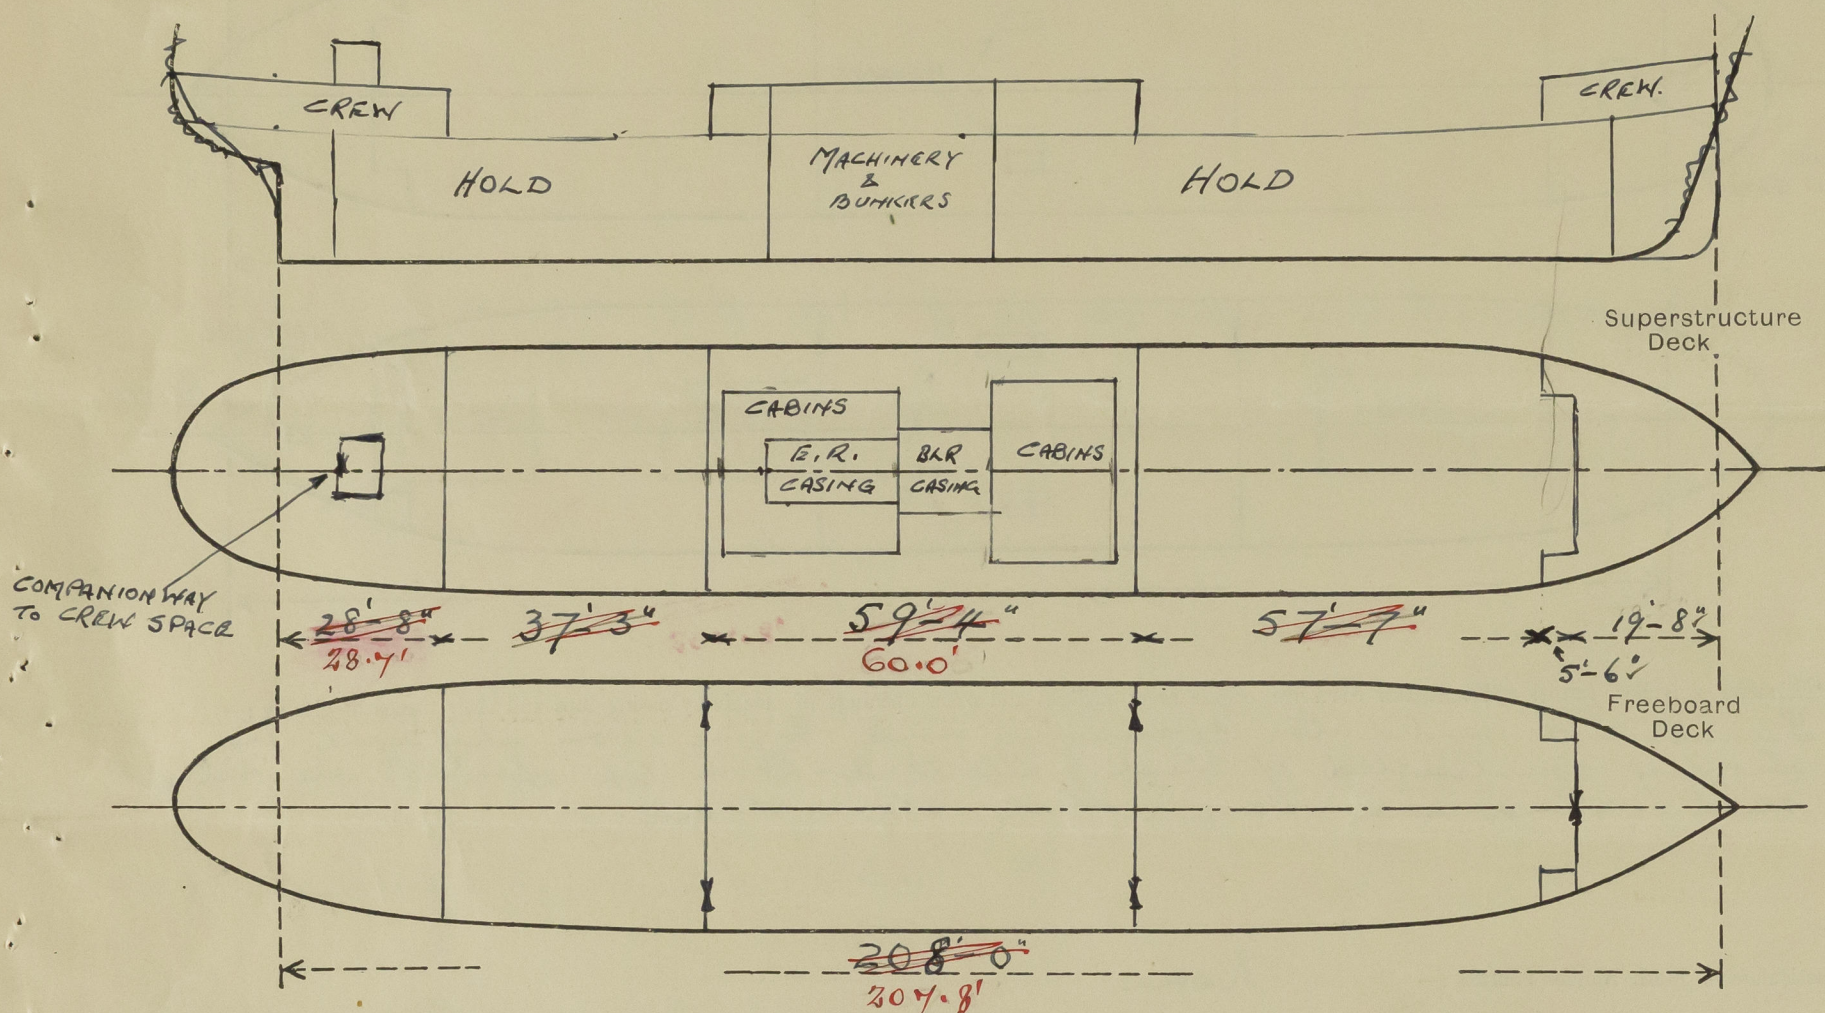

Particulars of Superstructures, Trunks, Casings, Deckhouses.


	Coaming	Plating	Stiffeners	Spacing	End Attachments of Stiffeners	Size of Openings	Height of Sills	Height of Casings
Poop Bulkhead ...	30"	30"	5x3"x36" L5	30"	BRKTS TOP & BOTT	NONE	-	7'-0"
Raised Quarter Deck Bulkhead ...	-	-	-	-	-	-	-	-
Bridge, After Bulkhead ...	25"	25"	3 1/2 x 3 x 30" L5	30"	NONE	3'-0" x 4'-0"	22 1/2"	7'-0"
Bridge, Forward Bulkhead ...	18" x 34"	30"	6" x 3" x 44" L	30"	BRKTS TOP & BOTT	3'-0" x 4'-0"	22 1/2"	7'-0"
Forecastle Bulkhead ...	25"	25"	3 1/2 x 3 x 30" L5	30"	NONE	4'-6" x 2'-0"	20"	7'-5"
Trunk, Aft ...	-	-	-	-	-	-	-	-
Trunk, Forward ...	-	-	-	-	-	-	-	-
Exposed Machinery Casings on Freeboard or Raised Quarter Decks ...	-	-	-	-	-	-	-	-
Exposed Machinery Casings on Superstructure Decks ...	18" x 34"	28"	3 x 2 1/2 x 30" L5	30"	BRKTS TOP	4'-6" x 2'-0"	18"	7'-3"
Machinery Casings within Superstructures not fitted with Class I Closing Appliances ...	-	-	-	-	-	-	-	-
Deckhouses on Flush Deck Ships ...	-	-	-	-	-	-	-	-

Particulars of Closing Appliances (state if capable of being manipulated from both sides).

Poop Bulkhead ...	NONE.
Raised Quarter Deck Bulkhead ...	-
Bridge, After Bulkhead ...	RIVETTED CHANNELS WITH 2 3/4" WEATHER BOARDS
Bridge, Forward Bulkhead ...	" " " " " "
Forecastle Bulkhead ...	STRONG WOODEN DOORS OPERATED BOTH SIDES
Exposed Machinery Casings on Freeboard or Raised Quarter Decks ...	-
Exposed Machinery Casings on Superstructure Decks ...	STEEL DOORS OPERATED FROM BOTH SIDES
Machinery Casings within Superstructures not fitted with Class I Closing Appliances ...	-
Deckhouses on Flush Deck Ships ...	-

PARTICULARS OF PROTECTION TO OPENINGS, ETC.

The following diagrams should be used to indicate the positions of cargo and coaling hatchways, gangway, cargo and coaling ports, ventilators, companionways, etc., which would affect the seaworthiness of the ship :—

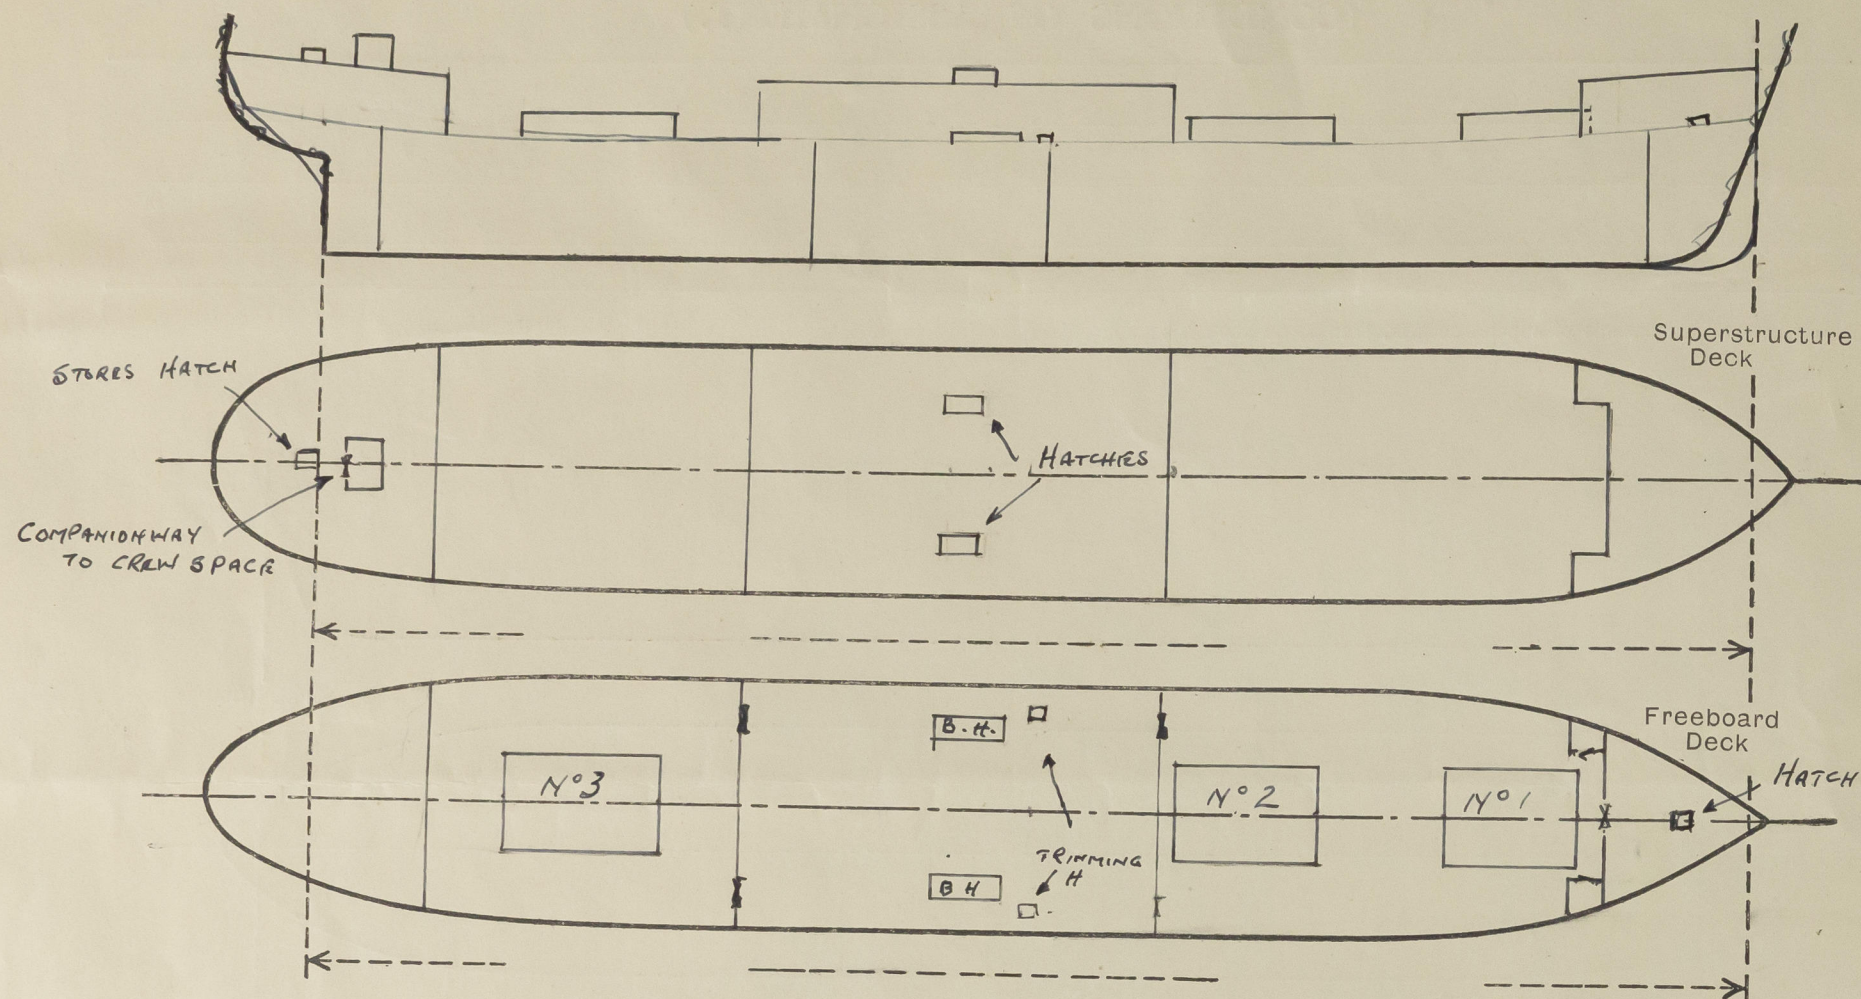

Particulars of fiddle, funnel and ventilator coamings, engine room skylight and other openings in machinery casing tops and their means of closing:—

Tunnel and ventilator coamings and engine room skylight are strongly constructed of steel. The Boiler Room top openings are fitted steel gratings and hinged steel storm doors. ✓

Particulars of Flush Bunker Scuttles :—

None ✓

Particulars of Companionways:— POOP DECK HOUSE.

Soon in after end to Crew space.

4'-6" x 2'- $\frac{1}{2}$ " sill 15" closed by strong wooden door operated from both sides ✓

Particulars of Ventilators in exposed positions on freeboard and superstructure decks :—

STRUCTURE DECKS:									
FLEE DECK	4 - 6 dia	.32"	check	coming	36"	high	lets	6 crew space	✓
FORR WELL	2 - 14"	"	.36"	"	"	36"	"	"	HOLD.
BRIDGE DECK	4 - 10"	"	.36"	"	"	30"	"	"	BUSHKES.
AFTER WRL.	2 - 14"	"	.36"	"	"	36"	"	"	HOLD.
POOP DECK	5 - 6"	"	.32"	"	"	30"	"	"	CREW SPACE.

WOOD PLUGS & CANVAS COVERS FOR CLOSING COAMINGS.

Particulars of Air Pipes in exposed positions on freeboard, raised quarter, or superstructure decks :—

FEAR	DECID.	1 -	18 HIGH	TO	A.P. TANK	✓			
FORE	WILL.	4 -	36"	"	D.B. TANKS	✓	ALL	FITTED	WITH GOOSE NECKS ✓
AFTER	"	2 -	36"	"	" " "	✓			
POOP	"	1 -	18"	"	A.P.	✓			

Ash provided with wood plugs attached with chains ✓

Particulars of Gangway Cargo and Coaling Ports :—

NO 17E

Particulars of Scuppers and Sanitary Discharge Pipes :- ALL SCUPPERS ARE LED FROM SPACES ABOVE THE FREEBOARD DECK AND FITTED WITH STRONGLY CONSTRUCTED STORM VALVES.

Particulars of Side Scuttles :— IN FORECASTLE ALL 10" DIA AND FITTED WITH EFFICIENT DEADLIGHTS.
IN POOP " 11" " " " " " " " "

Vertical distance of Sill of lowest Side Scuttle above top of keel..... 22' - 8"

Particulars of Guard Rails:— POOP AND FORECASTLE DECKS.

3'-6" HIGH 4 RAILS STANCHIONS SPACED 3'-9" APART.

- Particulars of Gangways, Lifelines, etc. :-


LIFELINES FITTED IN BOTH HELLS FROM EYE PLATES AT
END BULKHEADS.

Particulars of Freeing Arrangements.						
	Length of Bulwark	Height of Bulwark	Size of Freeing Ports	Number each side	Area each side	Rule area each side
After Well	34'-3"	4'-0"	33" x 24"	2	114' ✓	10.254' ✓
Forward Well	54'-4"	4'-2"	26" x 24"	3	134' ✓	12.254' ✓

State position of each freeing port { After Well :- 7'-6" 10'-0" 14'-0" BR
(F. and A. position and height above deck edge) { Forward Well :- 12'-0" 14'-6" 14'-6" 10'-0" Fch.
10" ABOVE DECK EDGE

State whether the freeing ports are fitted with shutters, bars, or rails, and give particulars of such :- SHUTTERS

Additional area where sheer is less than standard.



© 2020
Lloyd's Register
Foundation

PARTICULARS OF PROTECTION TO OPENINGS, ETC.

HATCHWAYS ON FREEBOARD AND SUPERSTRUCTURE DECKS.										
FBD DK										
Description of Hatchway		BUNKER P&S	TRIMMING P&S	FORR. PLAK STORES		BRIDGE DECK BUNKER P&S	POOP DECK STORES
Dimensions of Hatchway		11'-0" x 2'-6"	2'-6" x 2'-0"	2'-6" x 2'-0"		5'-4" x 2'-4"	3'-4" x 2'-5"
COAMINGS	Height above Deck		9"	9"	9"		18"	18"
	Thickness40"	.40"	.40"		.40"	.38"
	Sides		—	—	—		—	—
	Ends		—	—	—		—	—
HATCH BEAMS	Stiffeners		—	—	—		—	—
	Brackets, Stays		—	—	—		—	—
	Number							
	Spacing							
FORE AND AFTERS	Scantling and Sketch							
	Bearing Surface							
	Number							
	Spacing							
HATCH COVERS	Unsupported Lengths							
	Scantling* and Sketch							
	Bearing Surface							
	Material		WOOD	WOOD	WOOD		WOOD	WOOD
Spacing of Cleats	Thickness		2 3/4"	2 3/4"	2 3/4"		2 3/4"	2 3/4"
	How fitted		ATHW.	ATHW.	ATHW.		ATHW.	ATHW.
	Bearing Surface		2 1/2"	2 1/2"	2 1/2"		3"	3"
	Number of Tarpaulins		2	2	2		2	2
*Are wood fore and afters steel shod at all bearing surfaces? —										
Are battens and wedges efficient and in good condition? YES										
Are tarpaulins in good condition and in accordance with rule requirements? YES										
Are lashings provided in accordance with rule requirements? YES										

Particulars of any special features :—

