
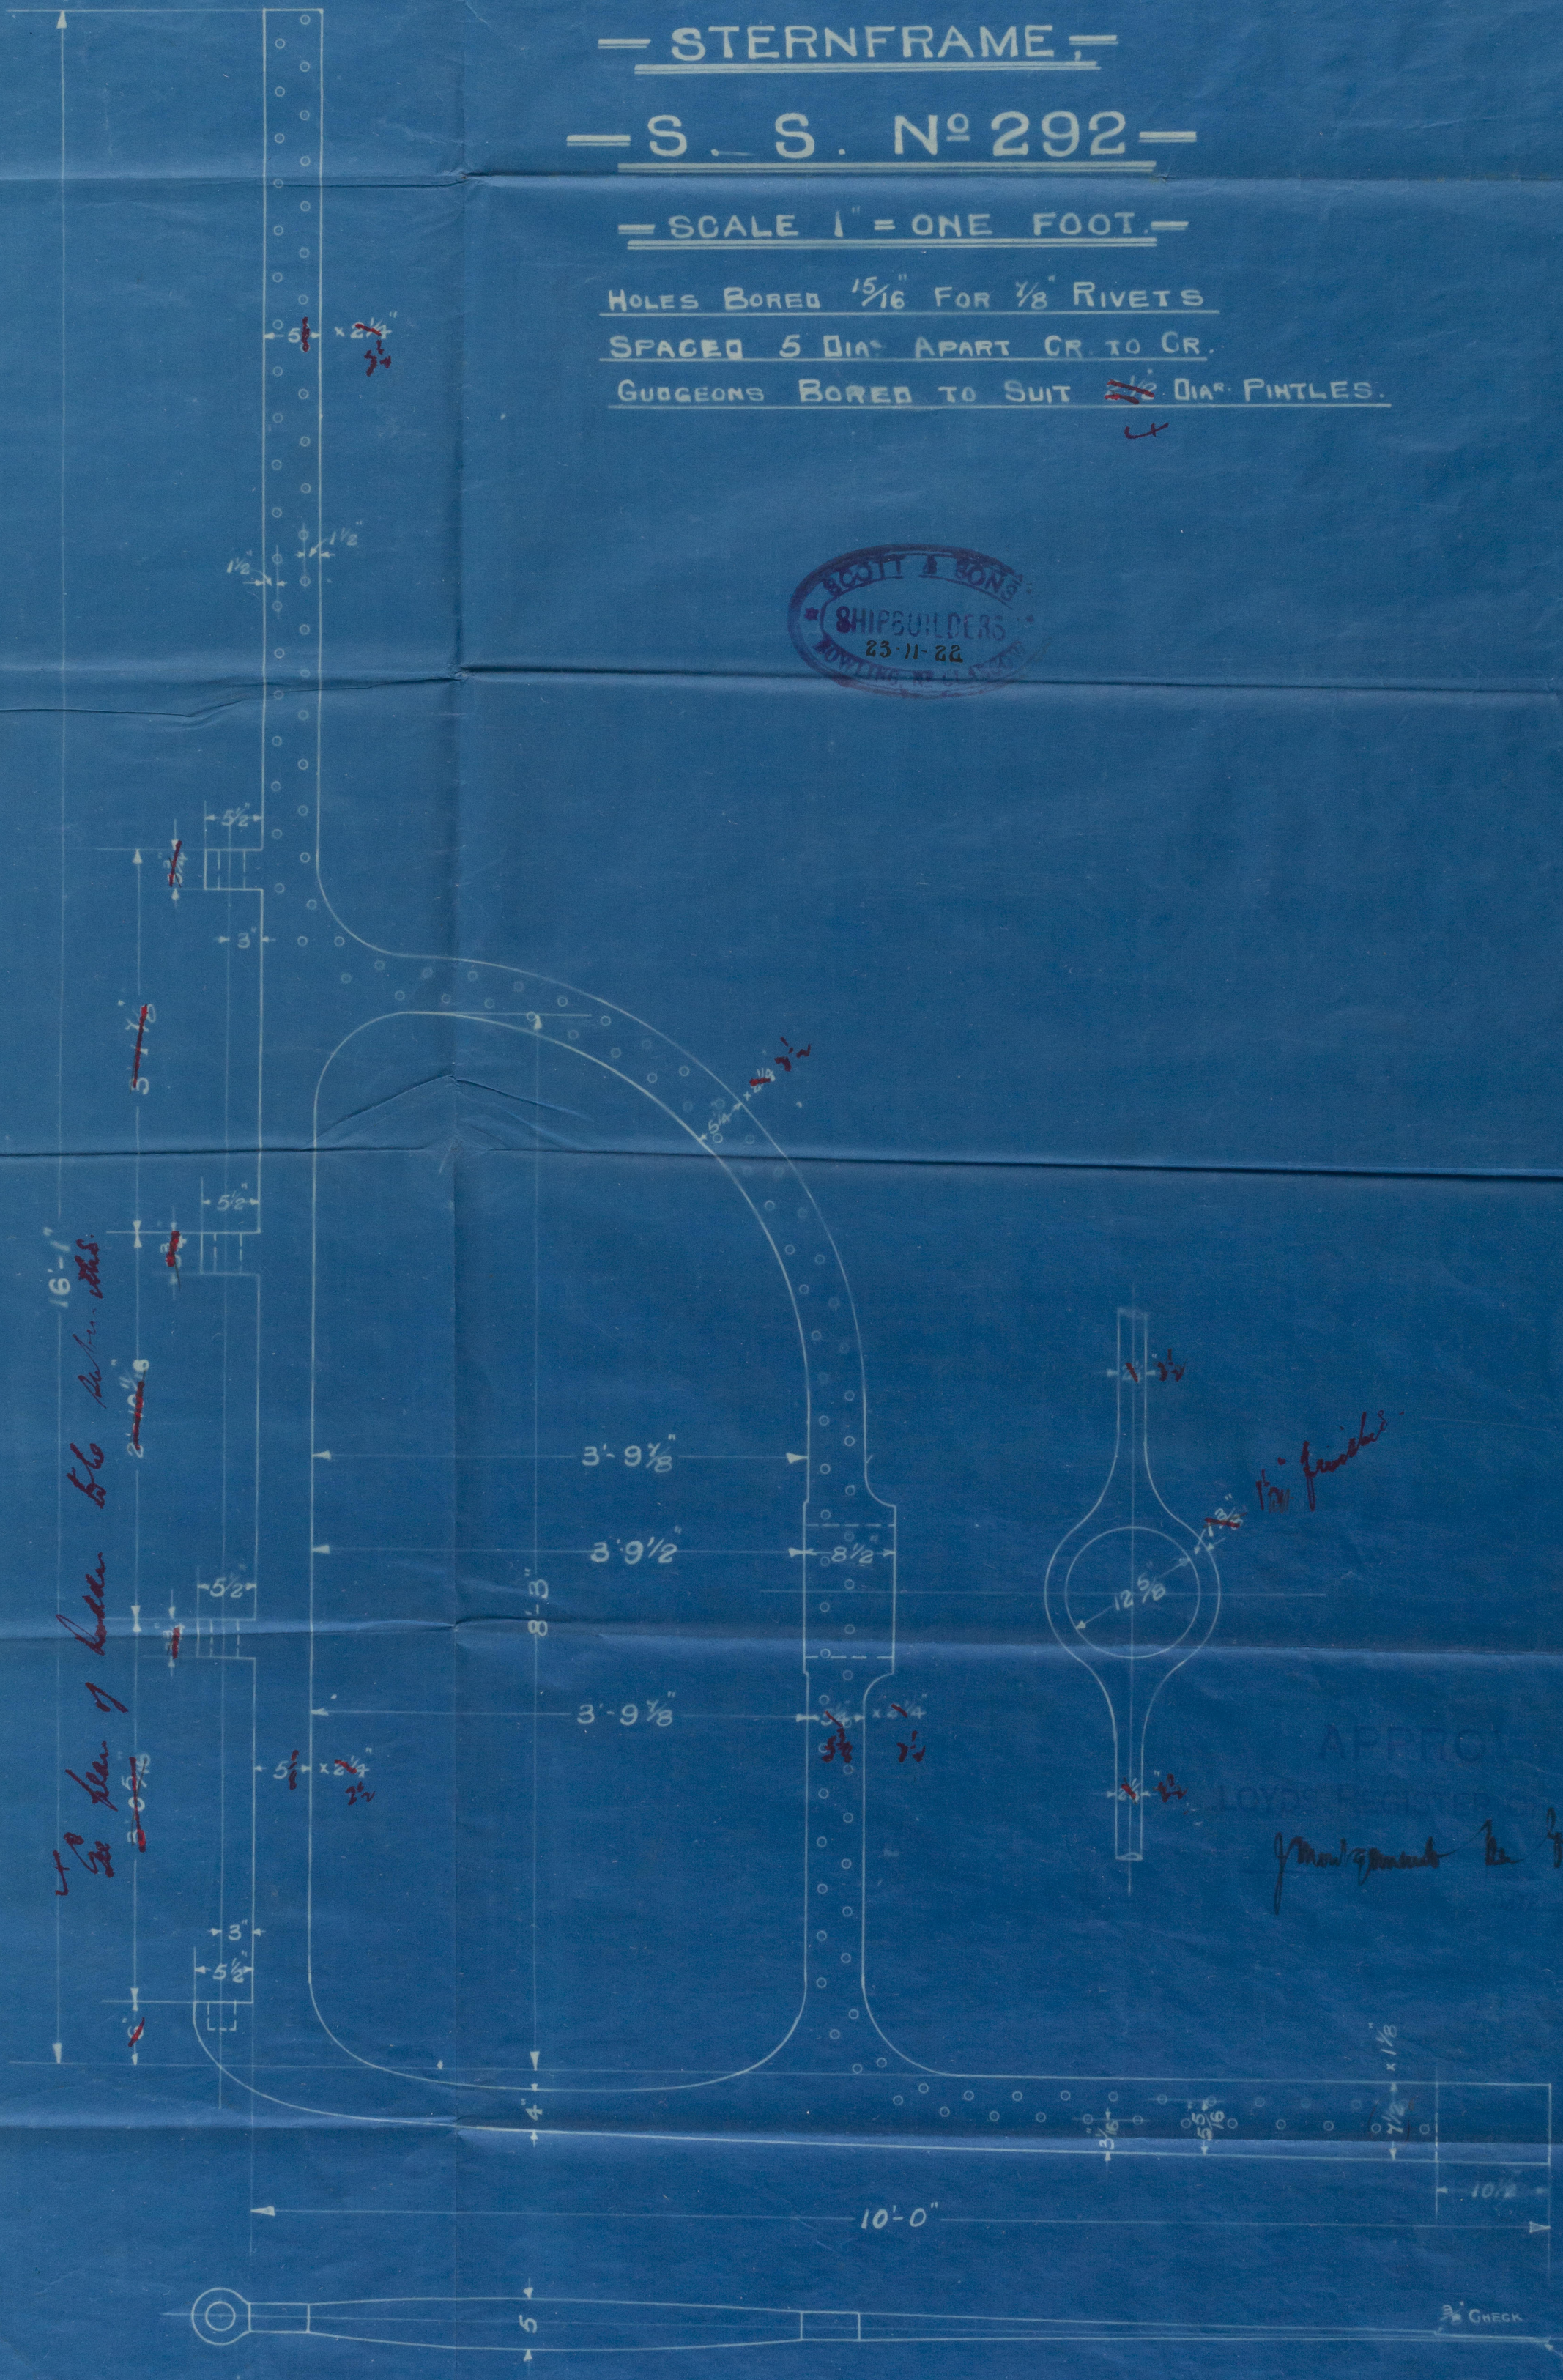


— STERNFRAME —
— S. S. N° 292 —

— SCALE 1" = ONE FOOT. —

HOLES BORED $\frac{5}{16}$ " FOR $\frac{1}{8}$ " RIVETS
 SPACED 5 DIA. APART CR. TO CR.
 GUDGEONS BORED TO SUIT ~~2~~ DIA. PINTLES.

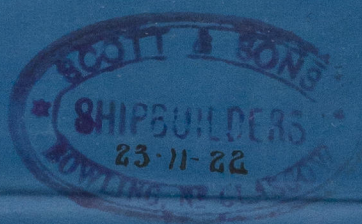

16'-1"
See plan of beam to be put in this
20'-0"
20'-0"

for finish
 APPROVED
 LLOYD'S REGISTER OF SHIPPING
Management for 1922
20-11-22



Lloyd's Register
 Foundation
 002109-002118-0001

Stemframe

Scott & Sons

292 7/8

" Saint Oran "

GLASGOW REPORT No.

42817



© 2020

Lloyd's Register

Foundation