



— STEEL SCREW STEAMER —

— S. S. No 292 —

— SCALE 1/4" = ONE FOOT —

DIMENSIONS: 122'-3" x 21'-6" x 10'-3" M^{LD}.

To CLASS LLOYDS 100 A.I.

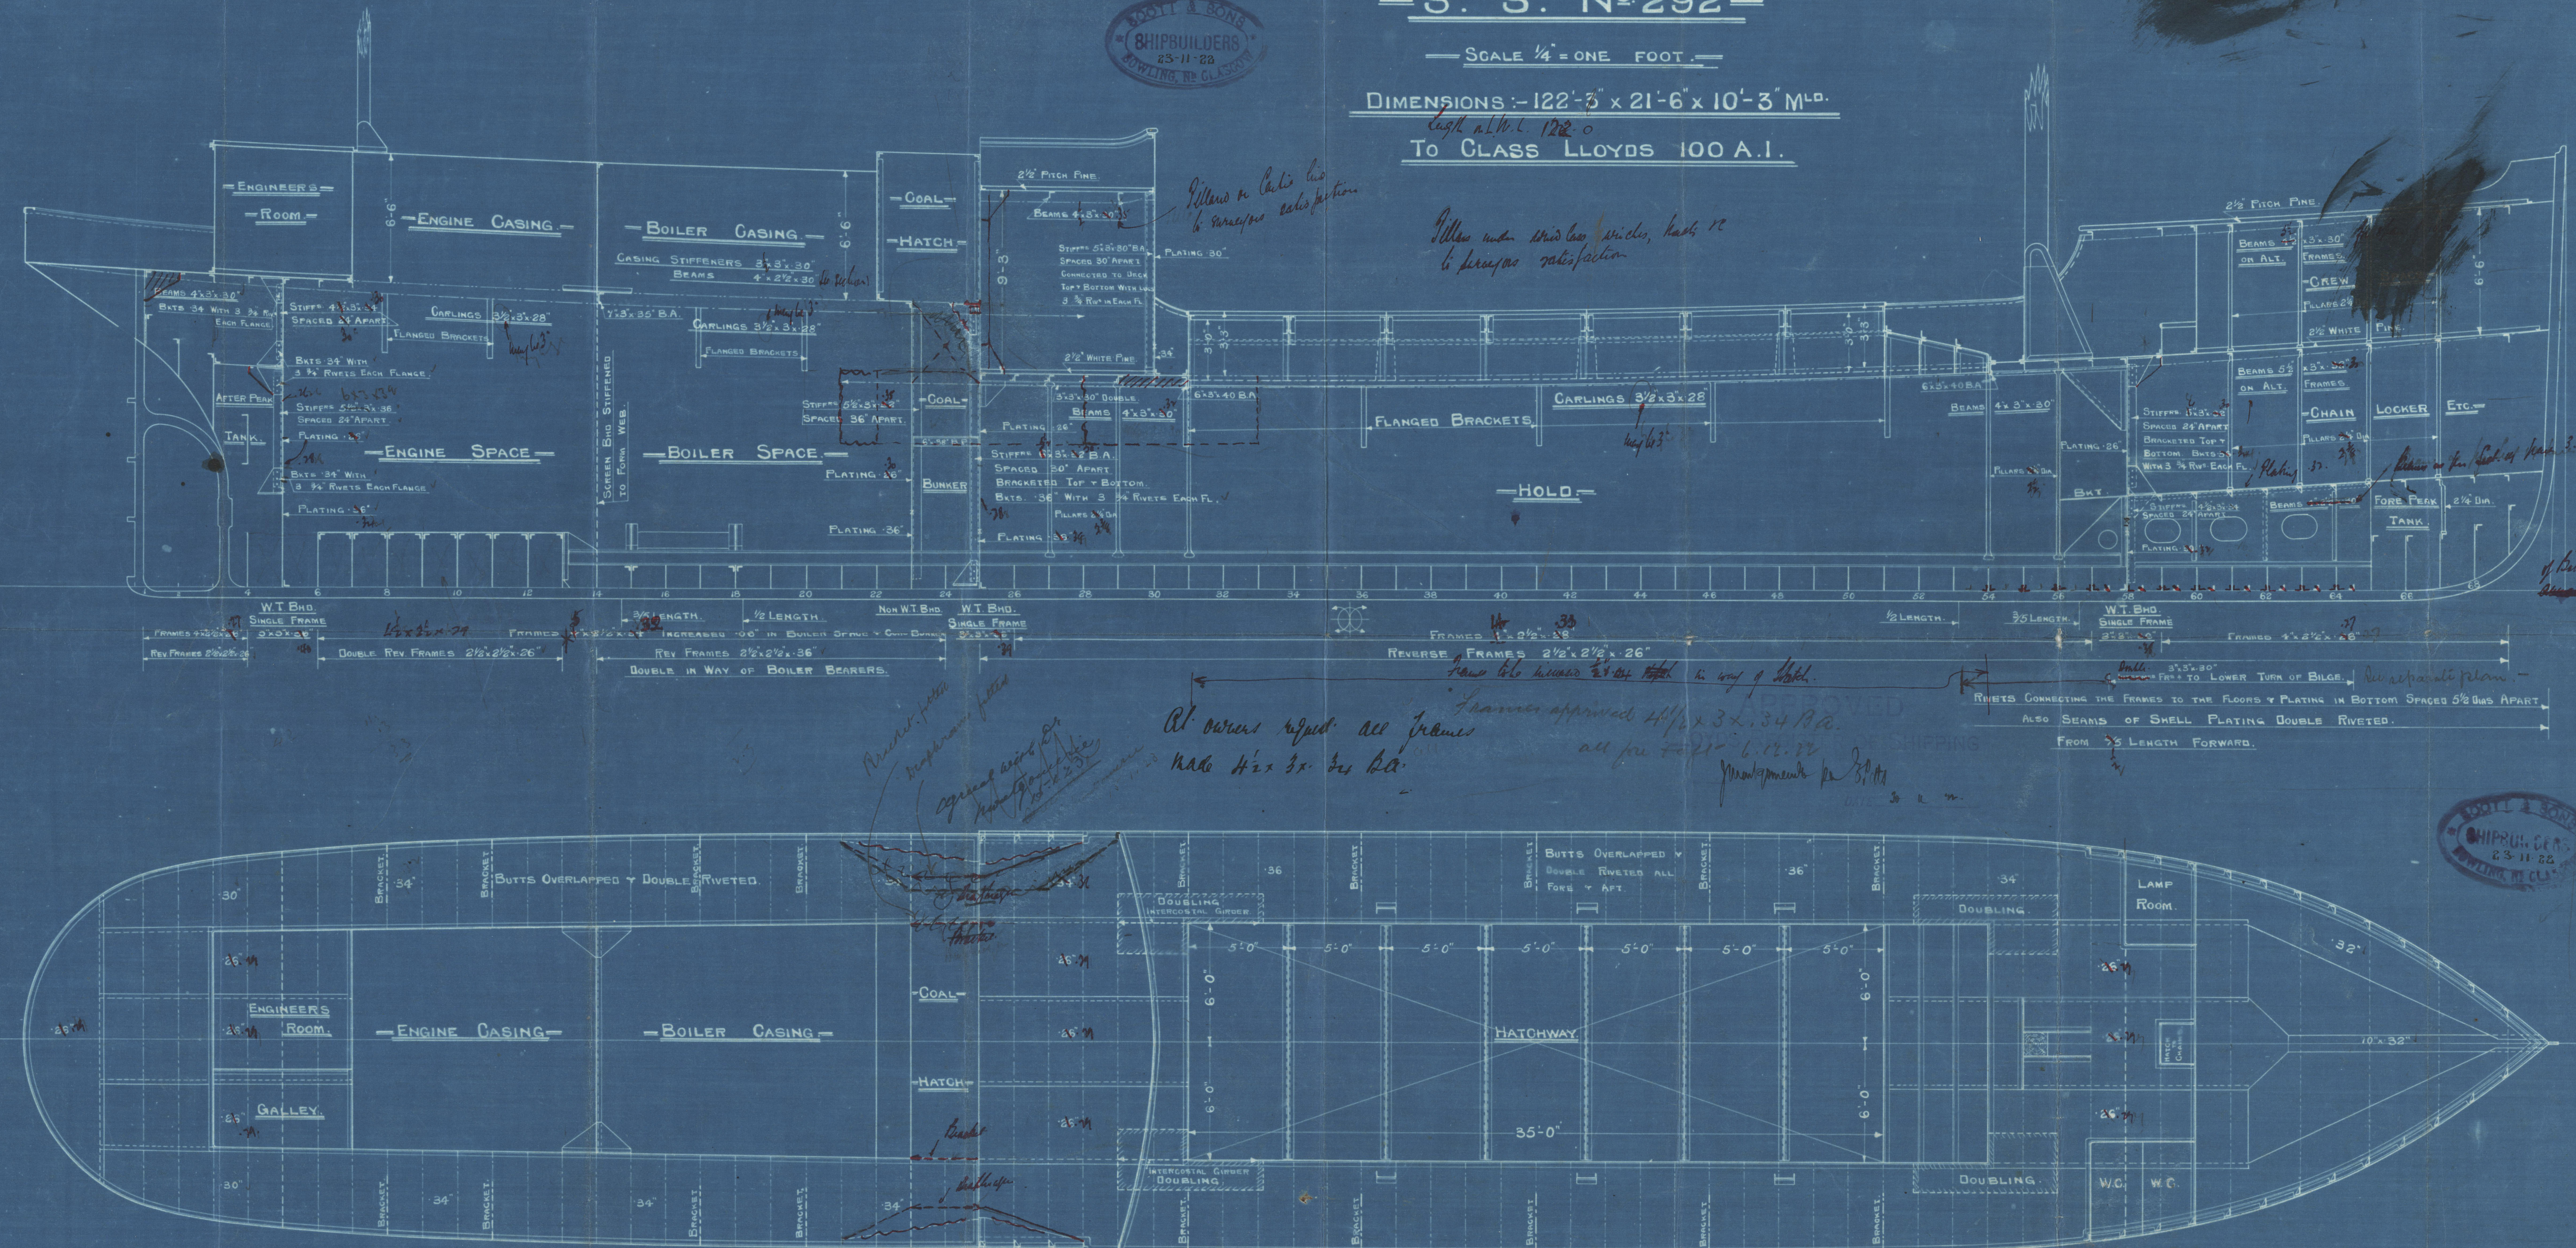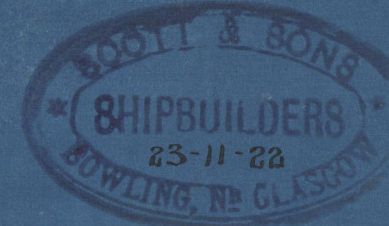


At owners request all frames made 4 1/2 x 3 x 3/4 BA.

Frames approved 4 1/2 x 3 x 3/4 BA. all for 70 ft. 6.12.22. improvements for 30 ft.



4 x 2 x 1/2
19
21
13
26
278
22 7

Profile -

Scott & Sons

S.S. 292

GLASGOW REPORT No. 42813

"Saint Oran"



© 2020

Lloyd's Register
Foundation

002109-002118-0003