

MIDSHIP SECTION SS N^o 224-5

TRACING No 3023.

SCALE 1" = 10' FOOT.

LENGTH (LLOYDS) 165' 9" BREADTH 26' 6" DEPTH MOULDED 13' 2"

TO CLASS 100A1 AT LLOYDS.

BREADTH 26' 5" + DEPTH 13' 16" = 39' 66". 1ST N^o

39' 66" x LENGTH 165' 75" = 6573. 2ND N^o

DEPTHS TO LENGTH MAIN DECK 12' 59" R Q DECK 9' 54"

DEPTH 10' 66" MAIN DECK (d)

DEPTH 14' 87" R. Q. DECK (d)

R. WILLIAMSON & SONS

SHIPBUILDERS

WORINGTON

18.9.13 ✓ 224

24.12.13 ✓ 224












17.1.14 ✓ 224

16.2.14 ✓ 224

13.3.14 ✓ 225

23.3.14 ✓ 225

3.7.14

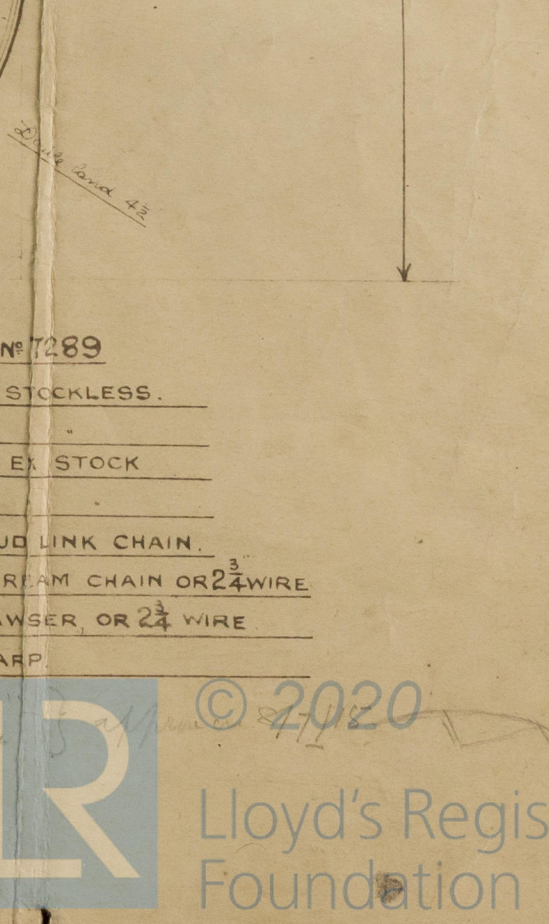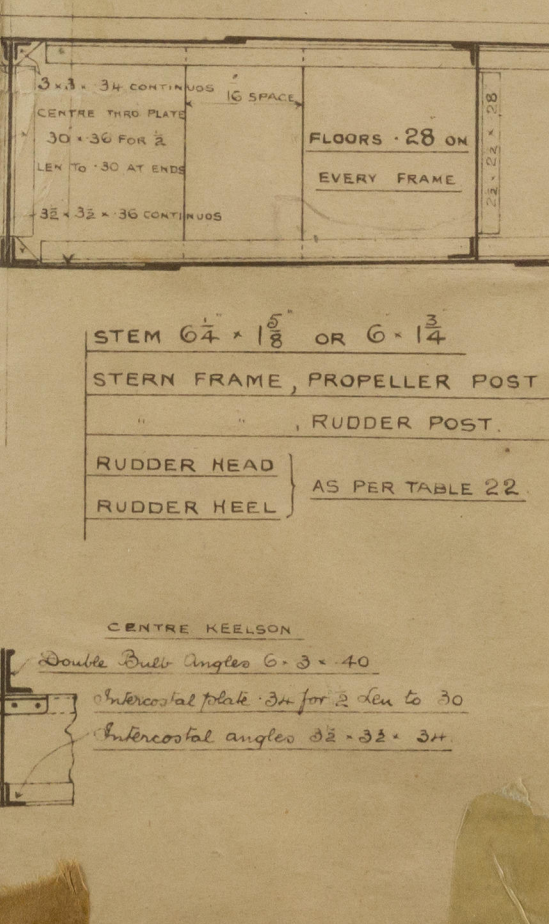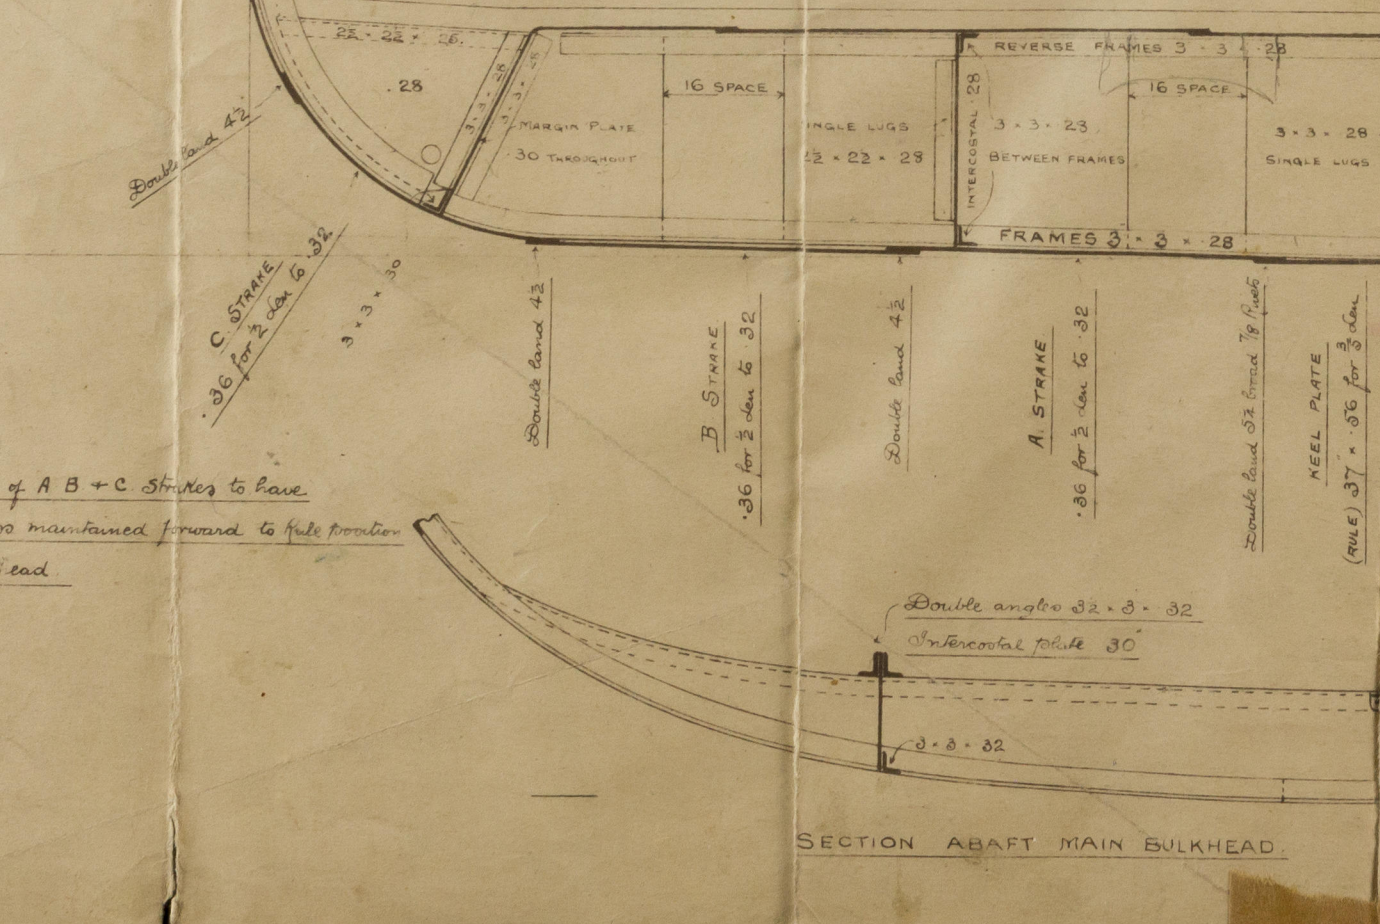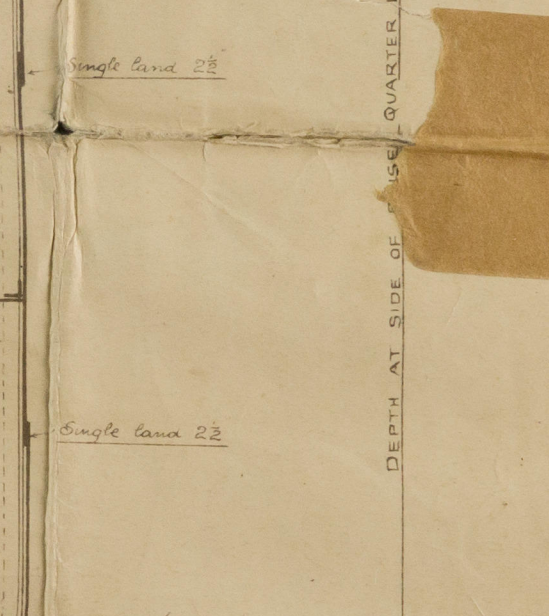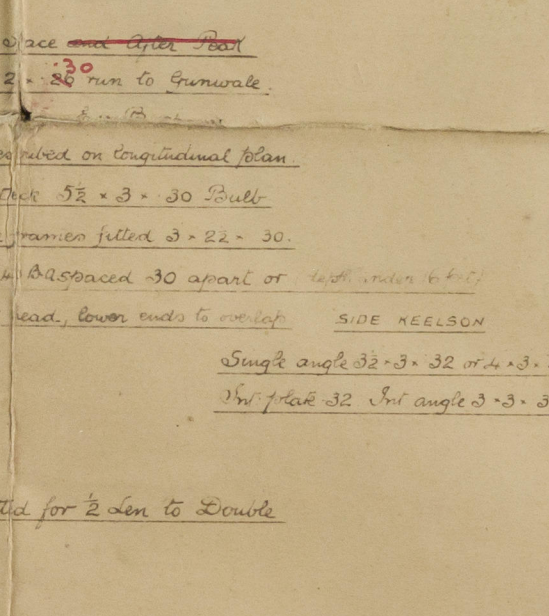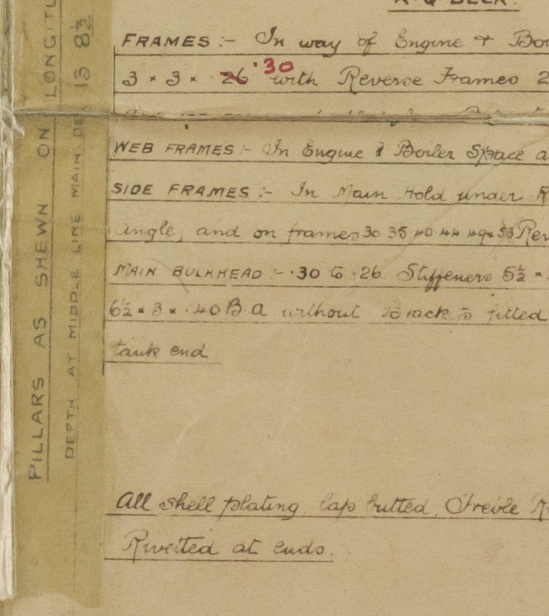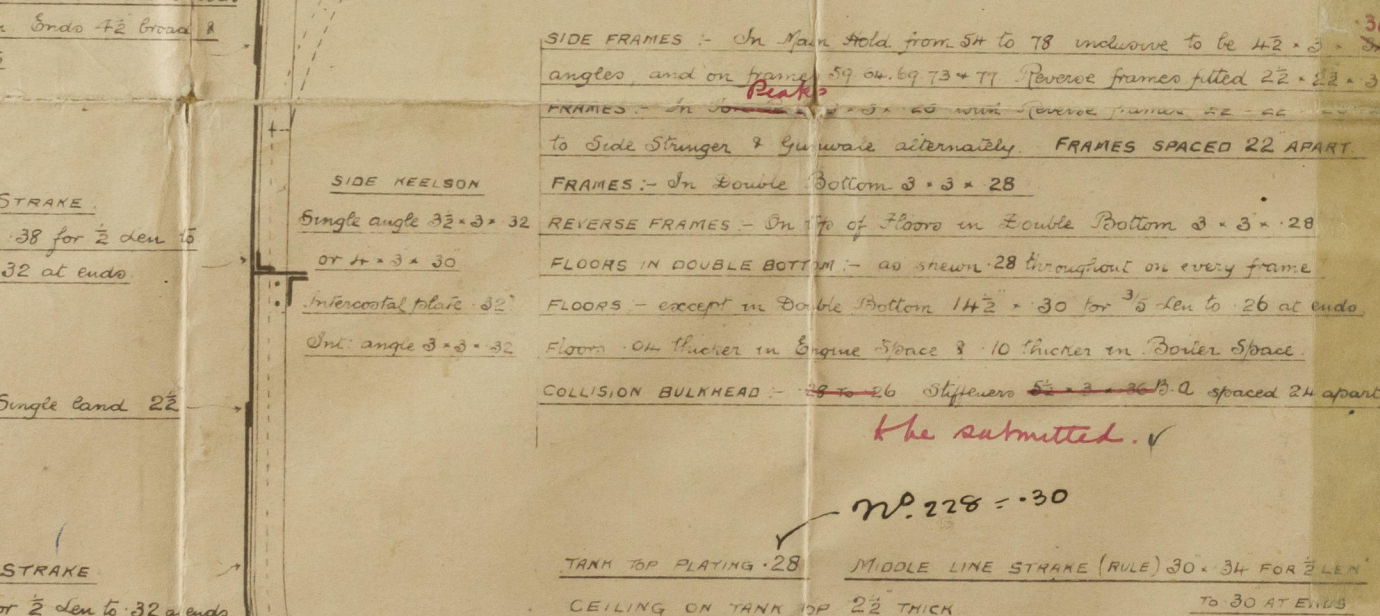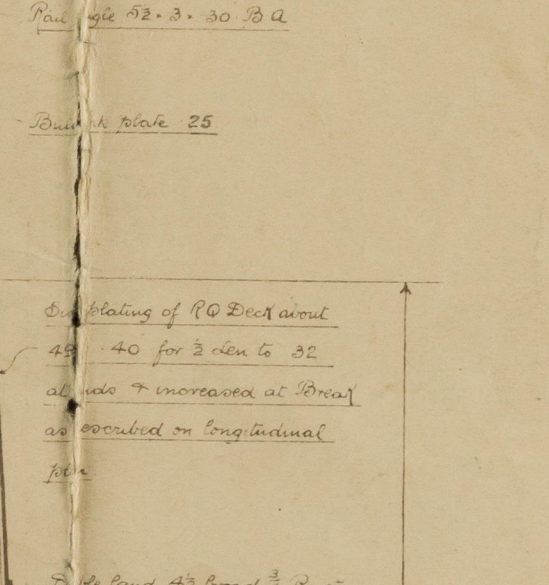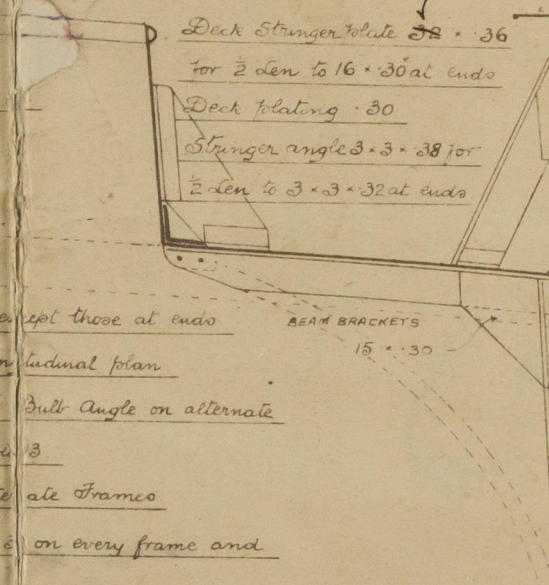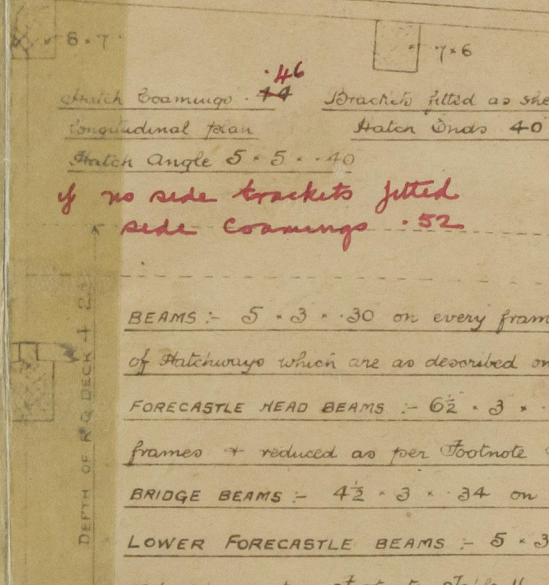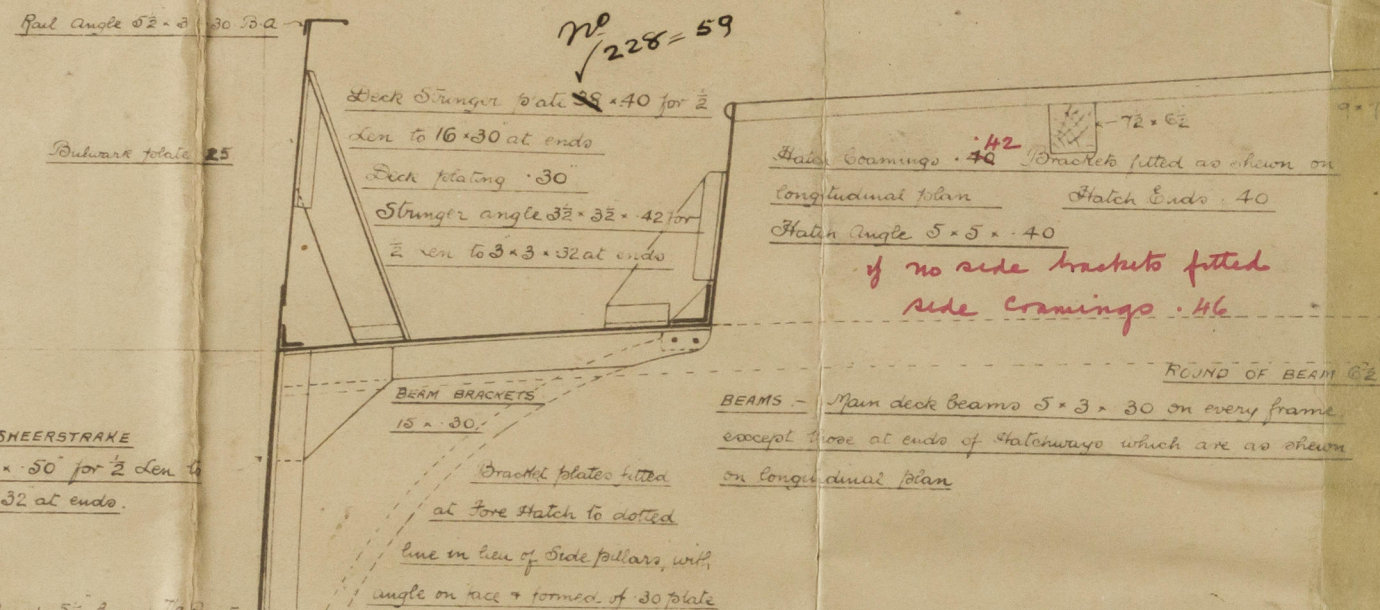

NOTE - Plating of A B + C Strakes to have Midship line also maintained forward to bulkhead of Collision Bulkhead.

STERN FRAME, PROPELLER POST	6' x 34"
RUDDER POST	5' x 34"
RUDDER HEAD	AS PER TABLE 22.
RUDDER HEEL	

EQUIPMENT N ^o 7289
2 BOWERS 12 1/2 CWT. STOCKLESS.
1 BOWER 10 1/2 " "
1 STREAM 4 " EX STOCK
1 KEDGE 1 1/4 " "
195 FATHOMS 1 1/8 STUD LINK CHAIN.
90 " 6 WARP

C.F.
18.9.13.

S/S 'LYNBURN'
NEWCASTLE ON TYN
Report No. 69944

S/S "Stanley Force"
= N° 228
Barrow in Furness
Report No. 1828

Shipping
Middlesex Section. S.S. N° 224.5
R. Williams & S. 228
BRW
70224 Bow RM-1650
S.S. "GALACUM"

To Newcastle for N° 225

REGISTER OF SHIPS
RECEIVED
20 SEP. 1913
LONDON

REGISTER OF SHIPS
RECEIVED
9-MAR. 1914
LONDON

REGISTER OF SHIPS
RECEIVED
16 FEB. 1914
LONDON

REGISTER OF SHIPS
RECEIVED
1914
LONDON

REGISTER OF SHIPS
RECEIVED
29 JAN. 1914
LONDON

REGISTER OF SHIPS
RECEIVED
10 JAN. 1914
LONDON

REGISTER OF SHIPS
RECEIVED
16 APR. 1915
LONDON

002109-002118-0041

© 2020
Lloyd's Register
Foundation