

Lloyd's Register of Shipping.

(Report on Vessel No. _____ Port _____)

No.

SHIP FORGINGS OR CASTINGS.

I have to report that the undermentioned ~~Iron or~~ Steel Forgings ~~or~~ Castings, manufactured by N. V. Wilton's Mach. fabriek & Scheepsw. of Rotterdam for the Vessel No. 400, being built by N. V. Scheepsw. & Mach. fabr. P. Smid Rotterdam have been inspected by me as set forth below and found to be, so far as can be seen, sound and free from defects

STERN FRAME
Mark on Forgings or Castings.

RUDDER FRAME
MARK ON FORGING

Lloyd's

No. 205

M.J. 25-6-26


LLOYD'S

N° 206

M.J. 25-6-26

	STERN FRAME.	RUDDER FRAME.	STEM.
Material* ...	Siemens Martin Steel	Siemens Martin Steel	
Made† ...	Forged.	Forged	
Dimensions ...	as per plan	as per plan	
Progress on Inspection ...	Forged & black.	Forged & machined	
Time when Inspected ...	22/5 10-21-25/6-26	3-17/4 13/8	
CASTINGS.			
Tests on Standard Test Pieces.			
Tensile Test—			
Tons per square inch ...	26 1/2 Tons	29 9/10 to 30 7/10 Tons	
Extension per cent. ...	35 to 37 %	34 %	
Bending Test—			
Angle before fracture ...	100° good	100° good	
Impact Test—			
Height from ground ...	✓	✓	
Numbering Test—			
If made according to Rules and found satisfactory ...	✓	✓	

SKETCHES OF FRAMES SHOWING POSITION AND DESCRIPTION OF WELDS OF FORGINGS.

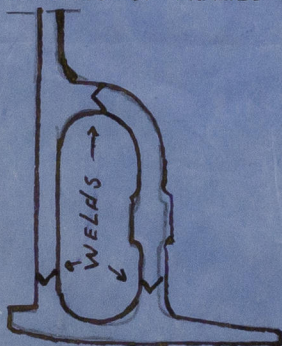

Fee (if any chargeable) £

To be paid at

Rotterdam



© 2020

Lloyd's Register
Foundation

* If of Iron, state whether scrap or puddled Iron. If of Steel, state whether made on the Open Hearth process.

† State if annealed

Yes

602109-002118-0091