

"SIREHAV"

Rockums Mör Verkstads g/f

Nº 155-6

Profile & Deck plans

Approved plan

EX
155. 'Pollusc'



© 2020

Lloyd's Register

Foundation



002109-002118-0182

Malmö.

Hockums Mek. Verket. A/B.

ny No 155 & 156.

Profile and deck plans

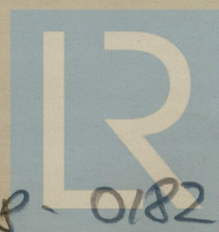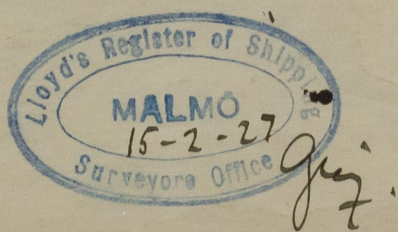

© 2020

Lloyd's Register
Foundation

002109-002118-0182