


2.9.02  
30.9.02

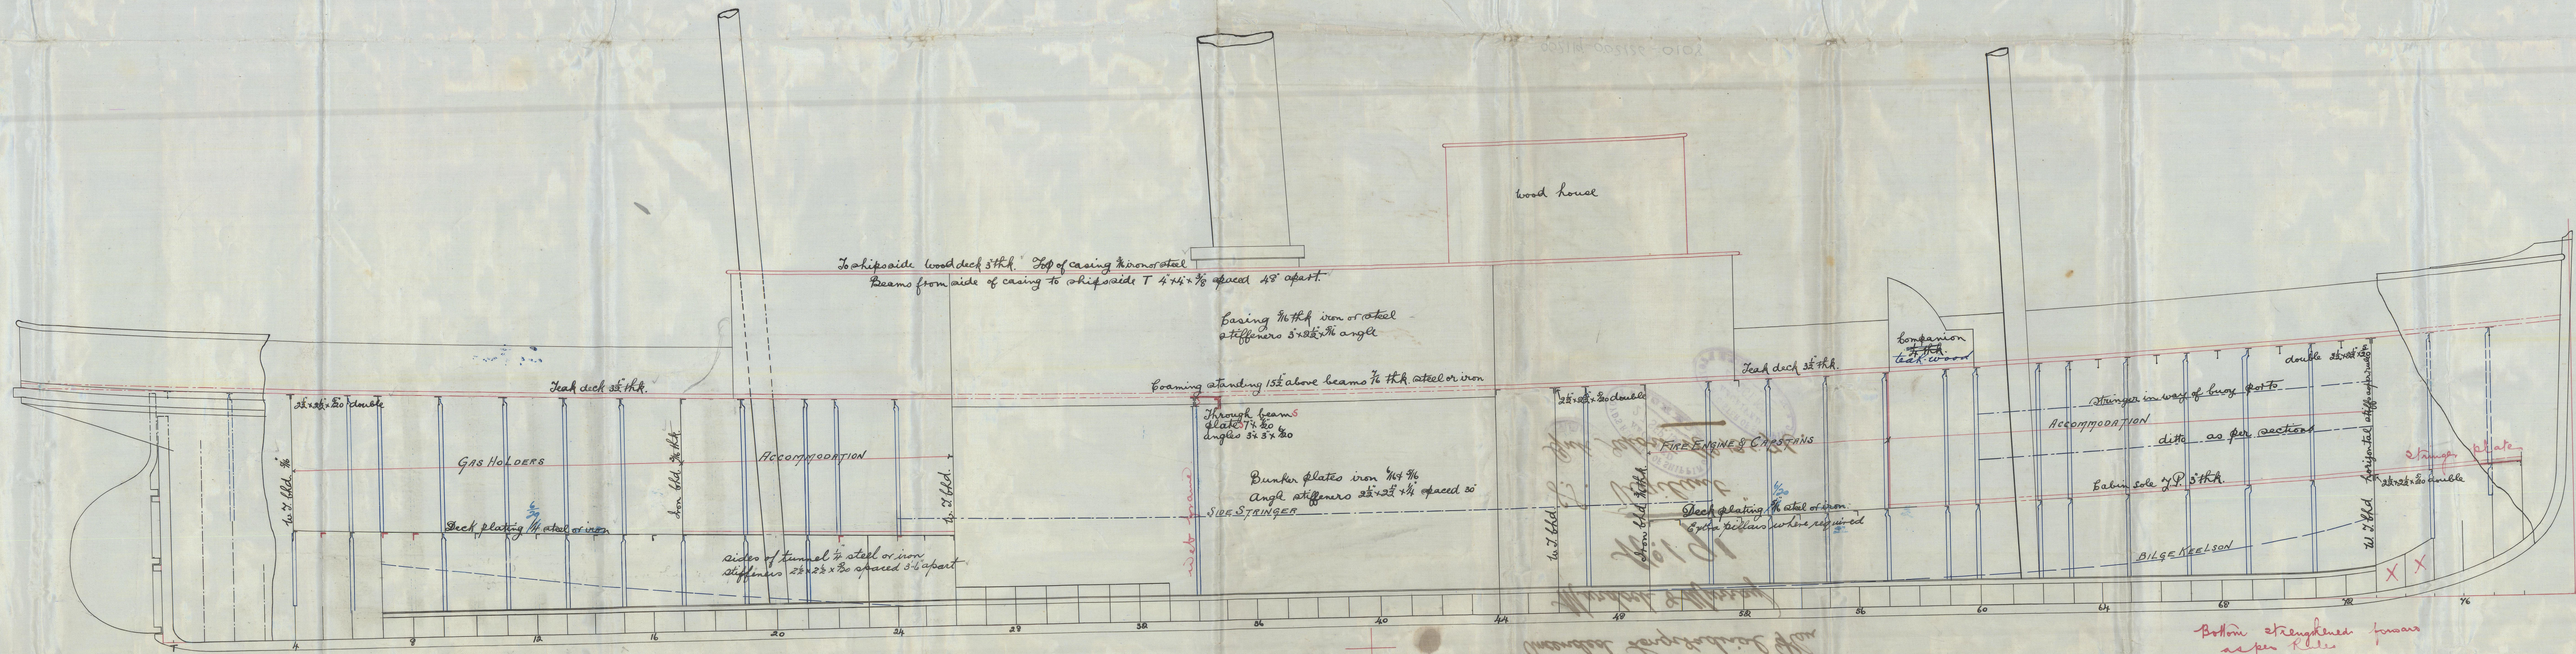

PROFILE & DECK PLANS





TWIN SCREW STEAMER

Nº 191.

to class 100A.1 at Lloyd's steel



SCALE 1/4" INCH = 1 FOOT.  
DRAWING Nº 4803

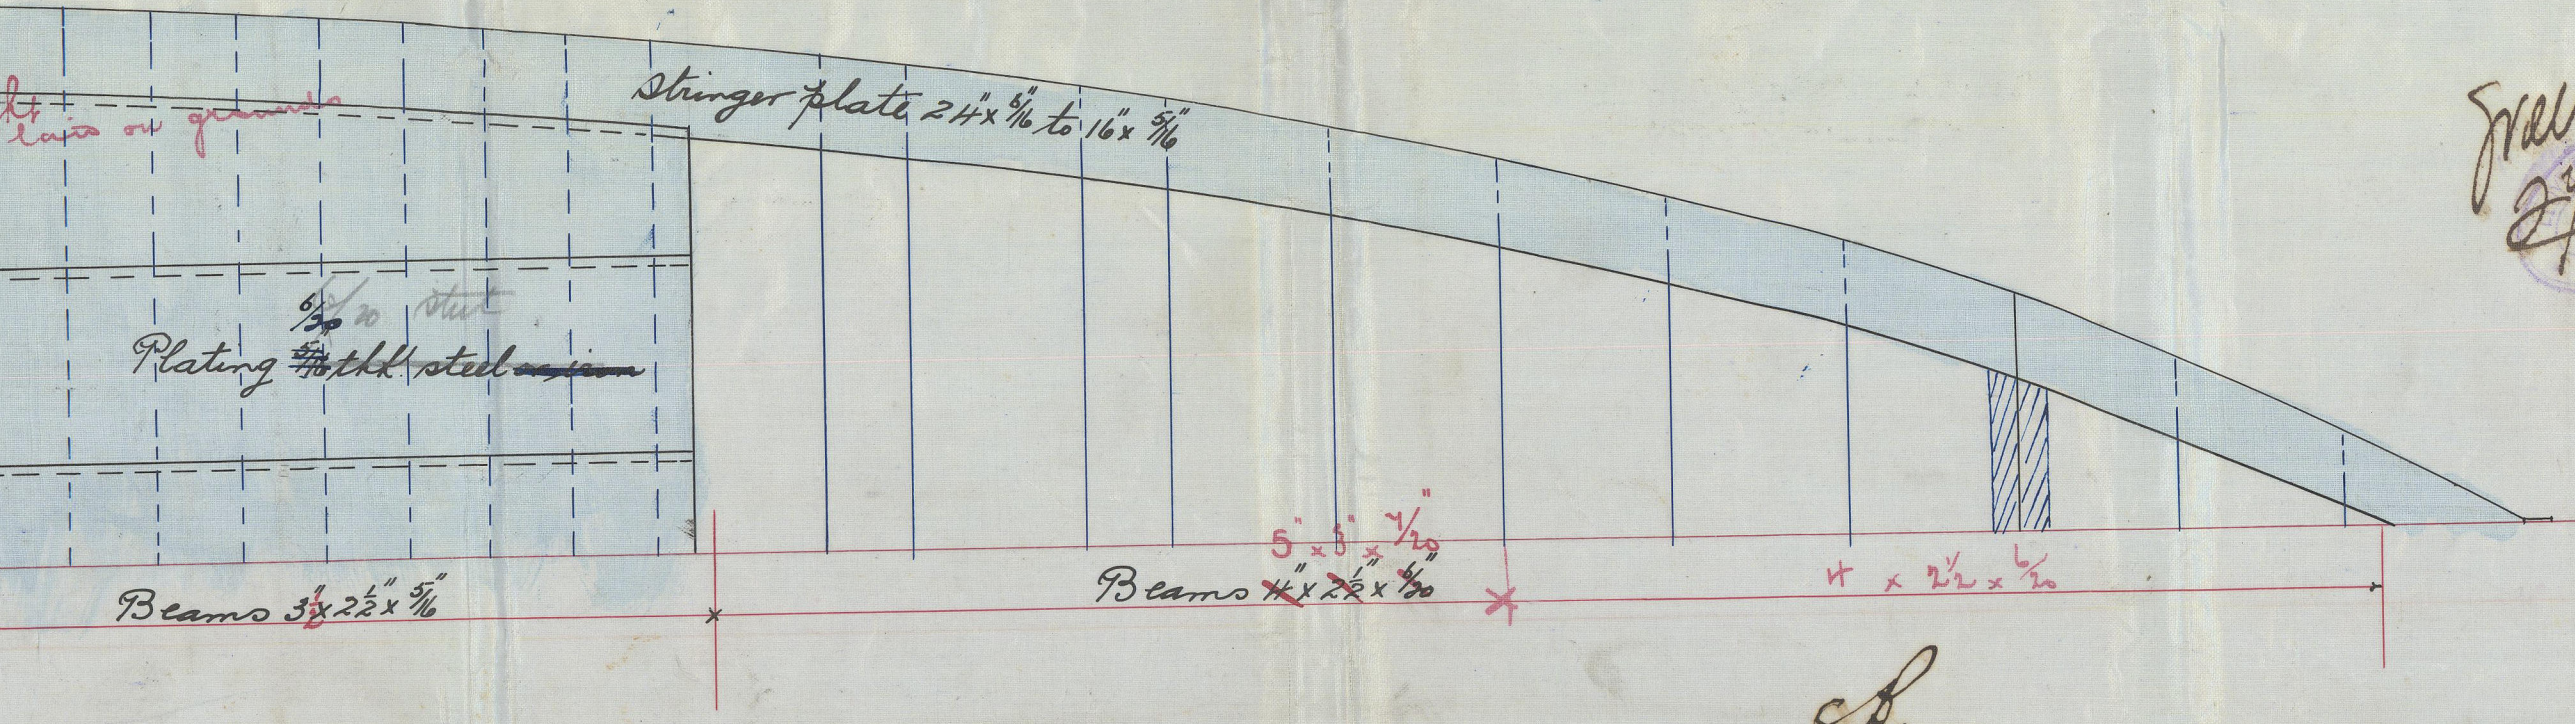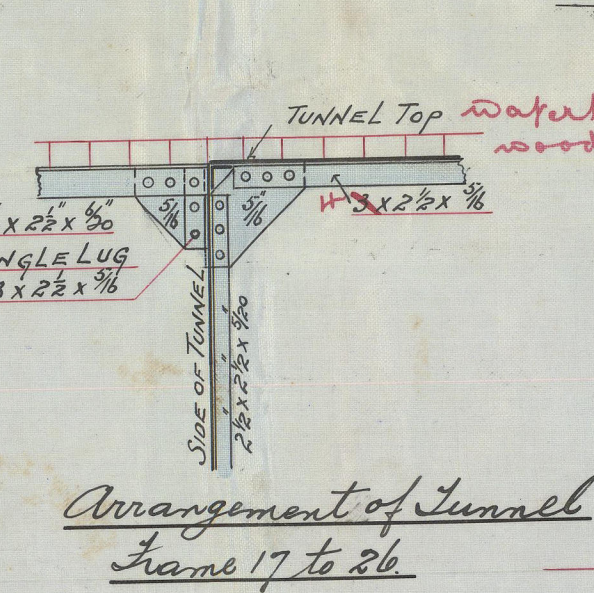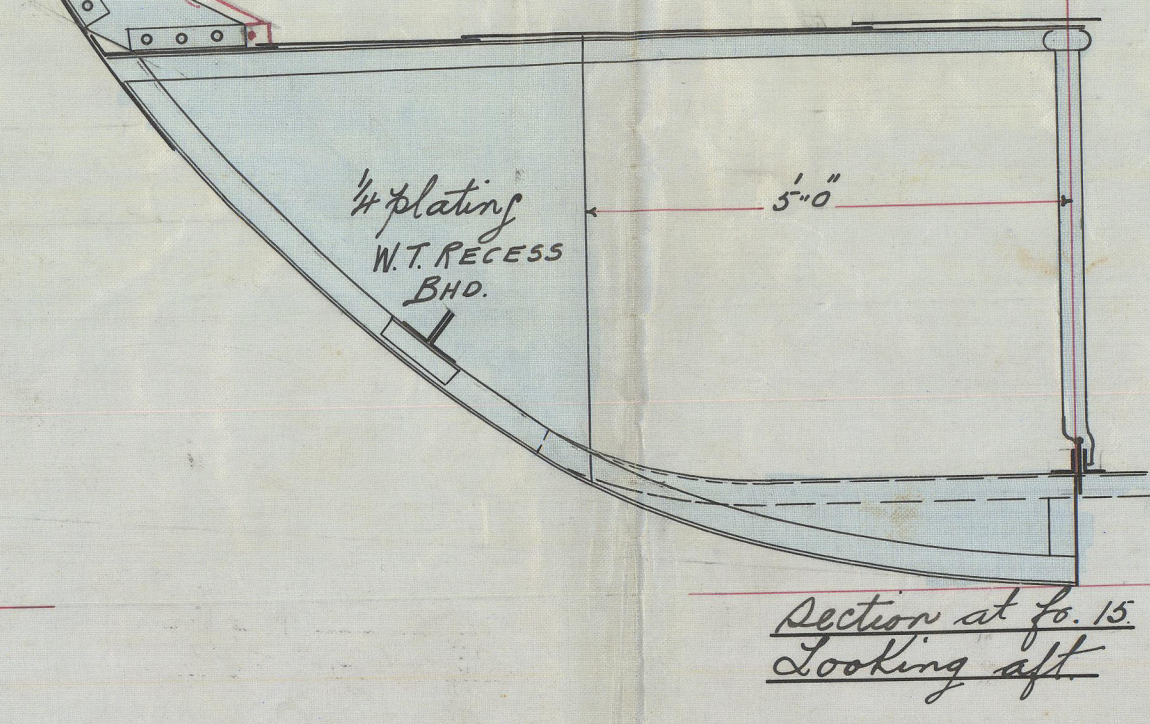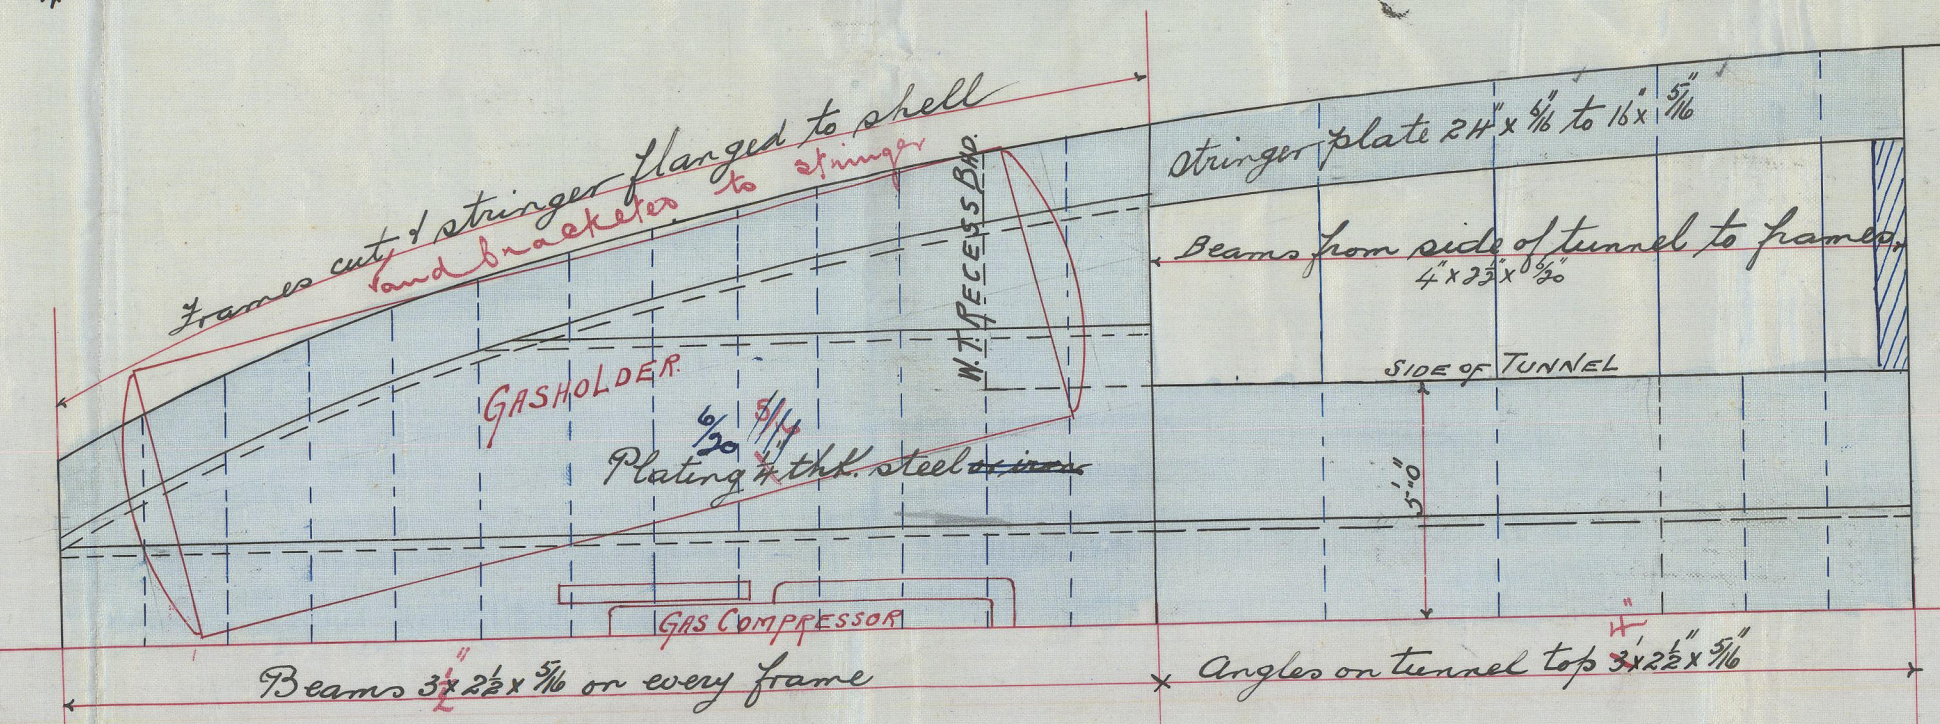

Travels  
24/8/02  
J.H.M.

c.b.  
2.9.02.





Amended Longitudinal Plan

Murdoch & Murray

No. 191,

S.S. Vigilant

Genl Report No. 13576.

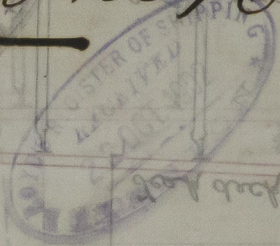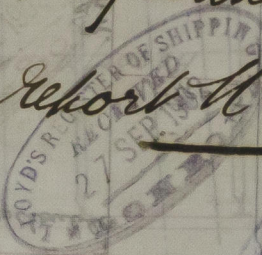

© 2020

Lloyd's Register  
Foundation

002119-002126-0108