

1002-E
MIDSHIP SECTION

1002-E
MIDSHIP SECTION

1002-E
MIDSHIP SECTION

1002-E
MIDSHIP SECTION

PLANS 3438
Messrs. Lloyd's Surveyors
Hull

MIDSHIP SECTION

STEEL SCREW TRAWLERS

11-1-36
N 5/16 TEKOURA

135.0 B.P. x 24.9 M. x 14.7 M.

TO CLASS 100.A.I. STEAM TRAWLER

SCALE 1/2 IN = 1 FOOT.

EQUIPMENT.


1ST BOWER	8 1/4 CWTs - STOCKLESS
2ND "	7 1/2 " "
KEDGE	3 1/2 " Ex STOCK
120 FATHOMS	1 1/2 " STUD LINK CABLE
60 "	6 " HAWSER
60 "	5 " WARP

NUMERALS

L x D	-----	1968.30
L x (B+D)	-----	5309.55
L/D	-----	9.25
Δ	-----	13.08

RIVETING

BUTTS OF SHELL PLATING TO BE LAPPED AND DOUBLE RIVETTED EXCEPT GARBOARD AND SHEERSTRAKE WHICH ARE TO BE STRAPPED AND DOUBLE RIVETTED
ALL LANDINGS TO BE DOUBLE RIVETTED EXCEPT TOP EDGE OF SHEERSTRAKE WHICH IS TO BE SINGLE RIVETTED
ALL SHELL RIVETS 3/4 DIA.
KEEL, STEM AND STERNPOST RIVETS 1 DIA.

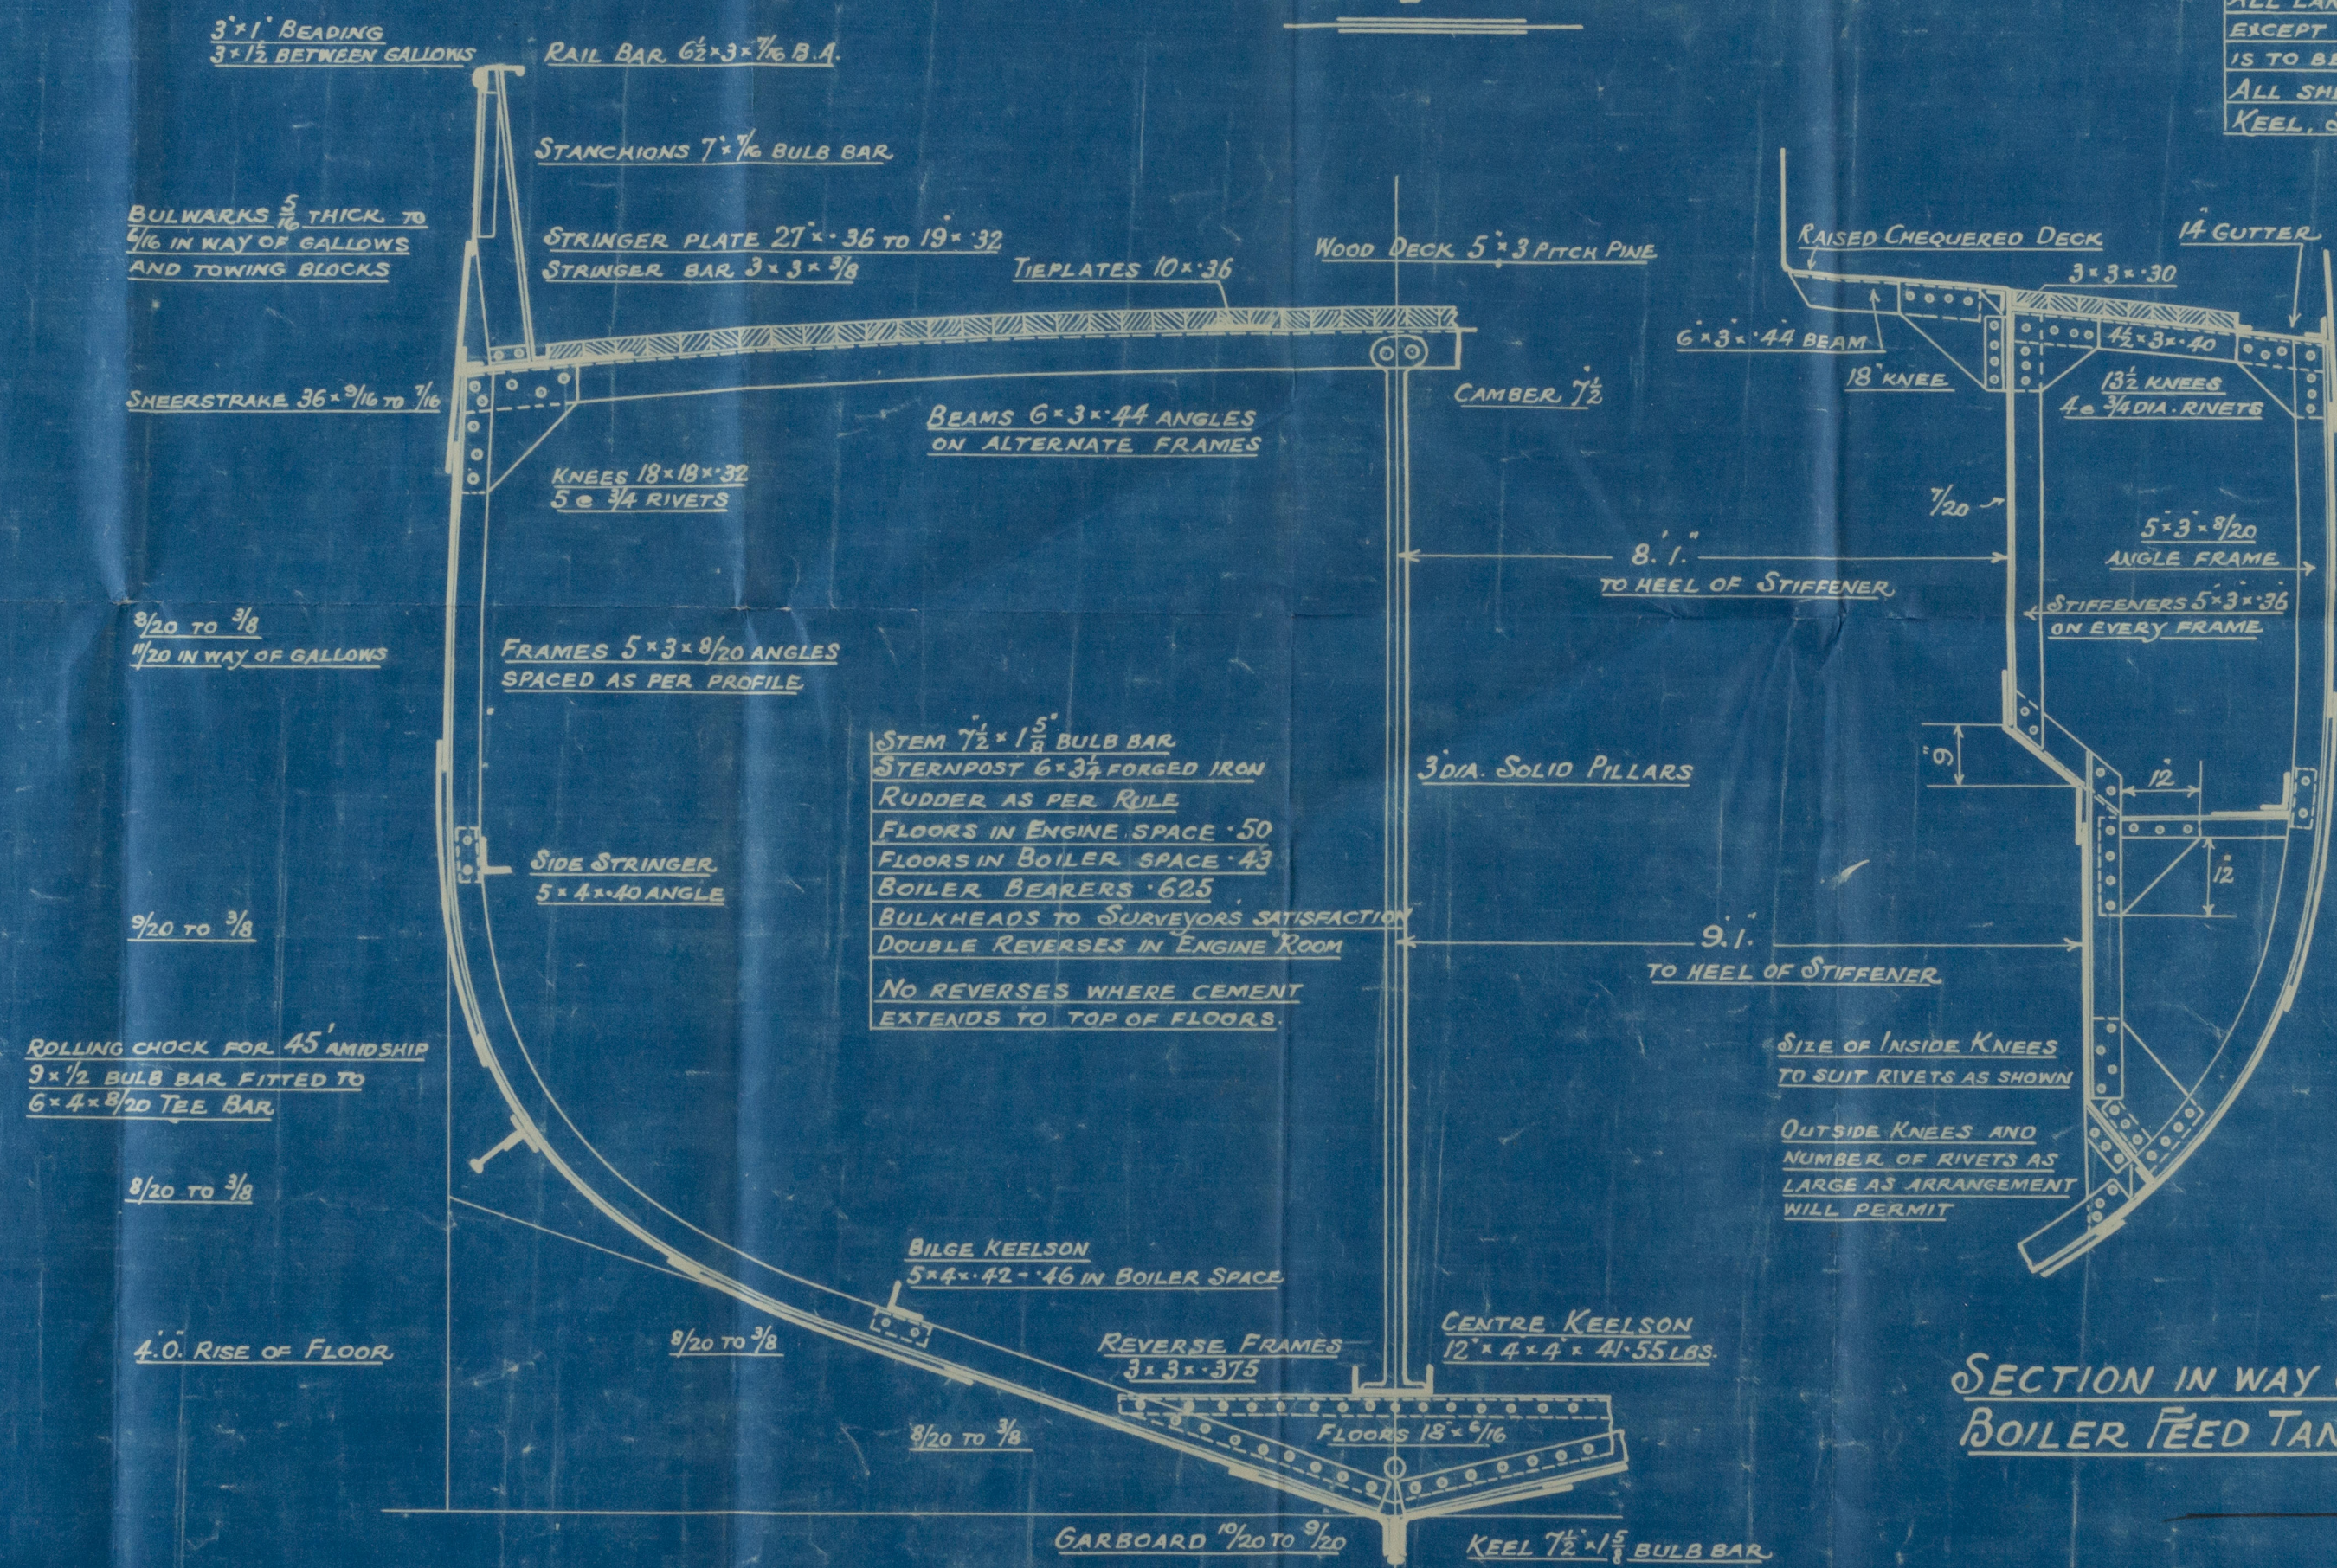

SECTION IN WAY OF BOILER FEED TANK

No 10660.

Midship Section (as built)

Cochran & Sons R.S.

S.S. "Jekowra"

HULL REPORT No. 40517



© 2020

Lloyd's Register
Foundation

002127-002137-0001