


Handwritten notes at top center:
200-181500-181500
See ship as in Messing Section

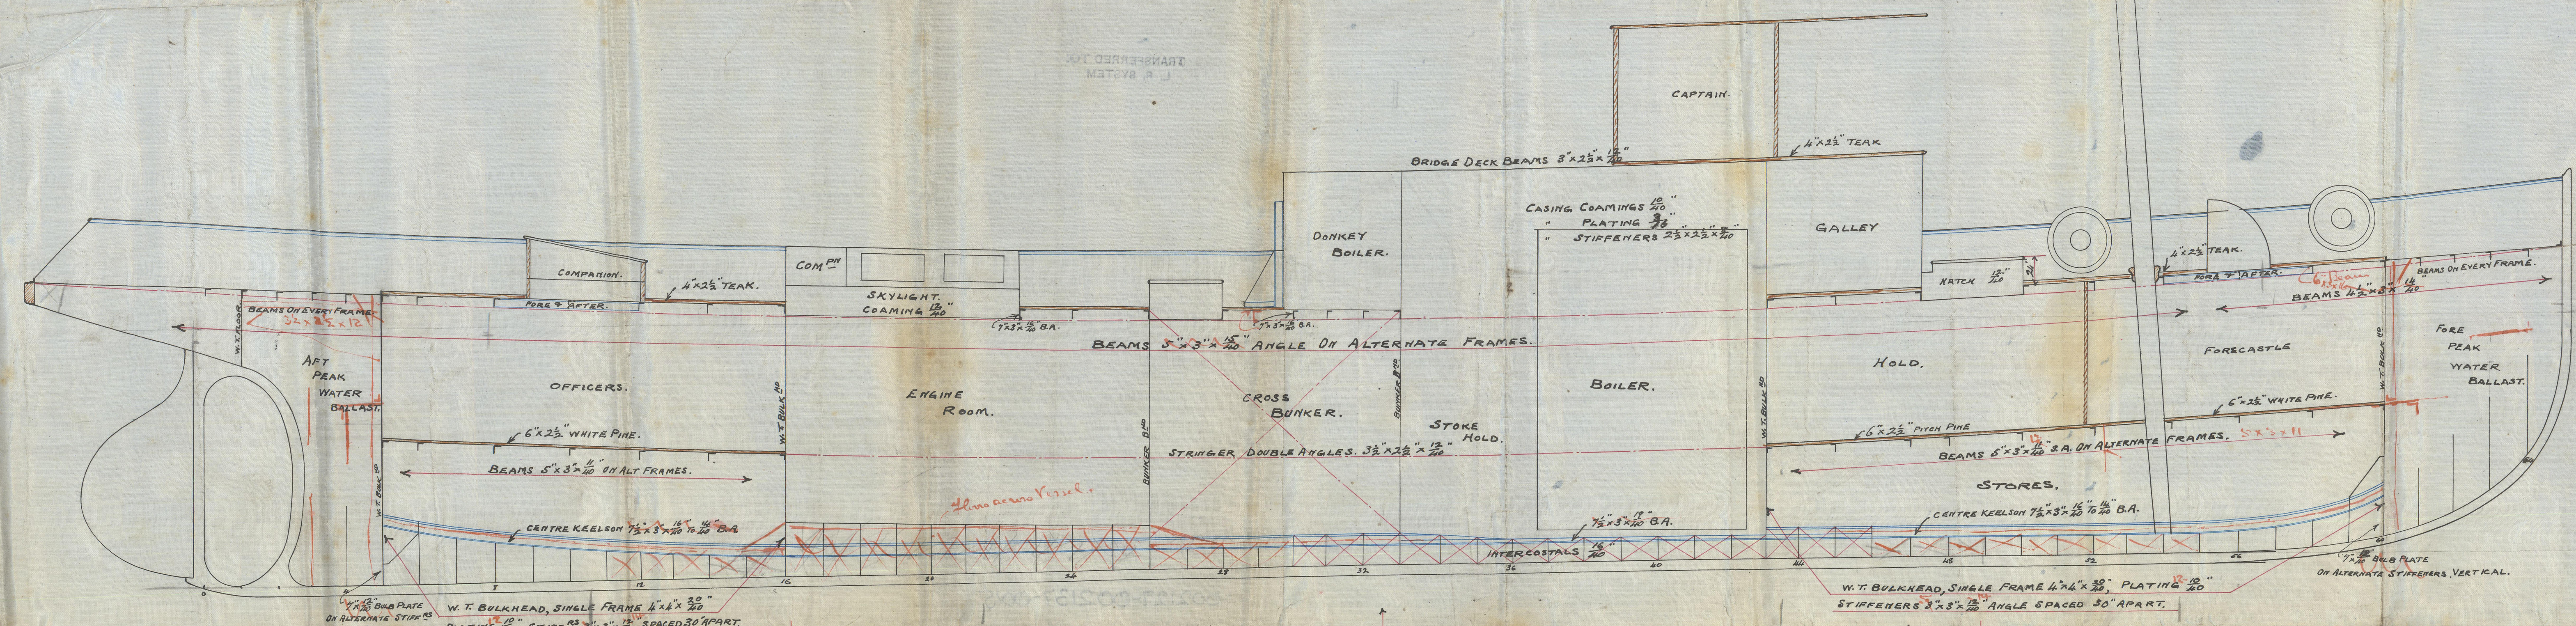

Approved
See Letter 12.10.16

PROFILE & DECK PLAN. N° 210
SCREW. TUG.
 120'0" x 24'0" x 12'6" M².
 SCALE 1/4" = 1 FOOT.
 TO CLASS. B.S. *

Handwritten notes:
 11755 + 875 = 225
 1285
 124




Damage & Ferguson's 210

Profile & Decks

S.S. Terawhiti

TRANSFERRED TO:
L. R. SYSTEM

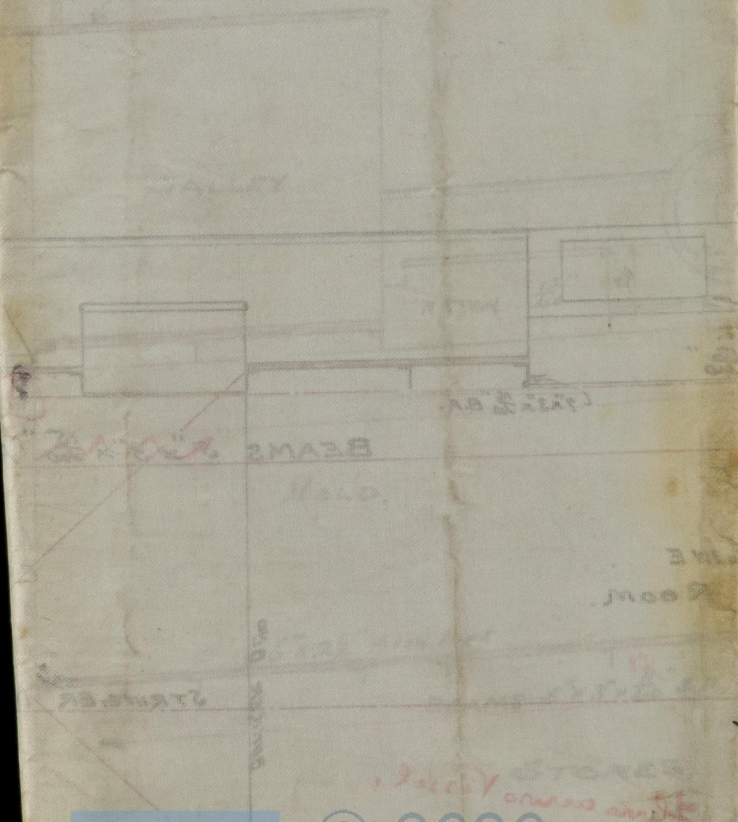

© 2020

Lloyd's Register

Foundation

002127-002137-0015