
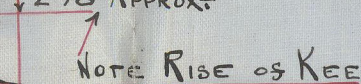
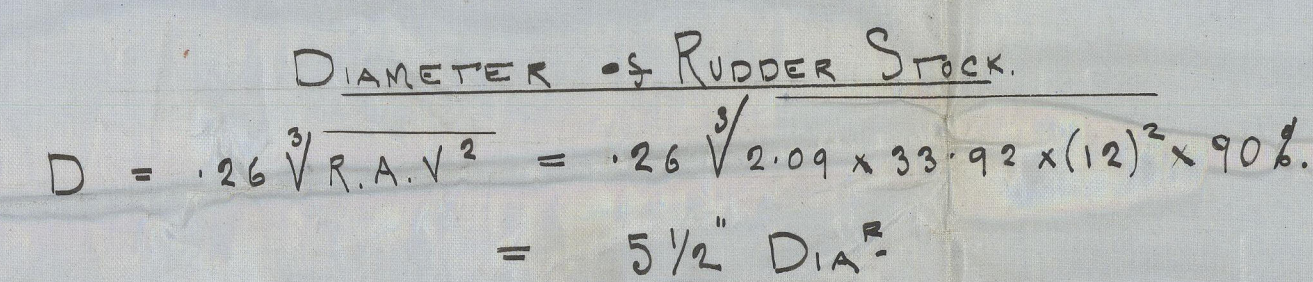
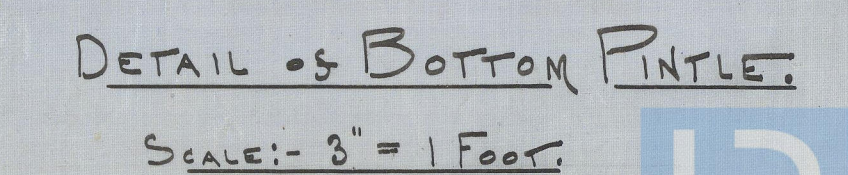
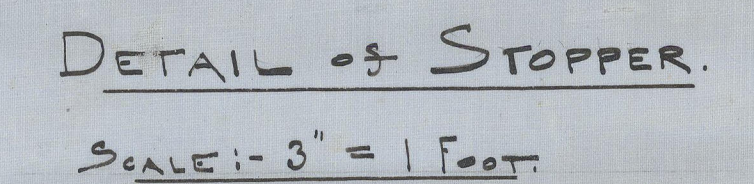


Approved *fff*
Sec Letter 28.10.6

— SCALE: $\frac{3}{4}" = 1 \text{ FOOT.}$ —


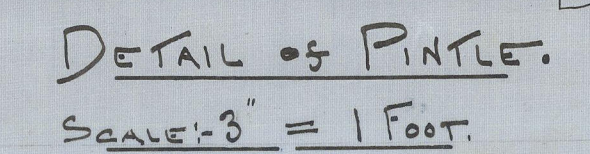

Ramage & Ferguson BN: 210
Sternport & Budder
Aug
S.S. Terawhiti

TRANSFERRED TO:
[] E R SYSTEM



© 2020

Lloyd's Register
Foundation

002127-002137-0016