
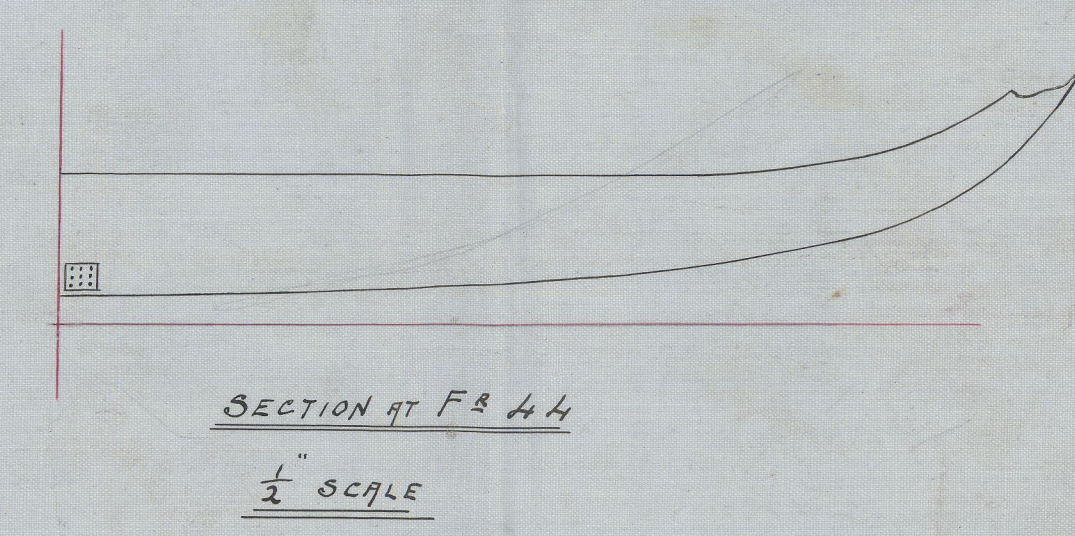
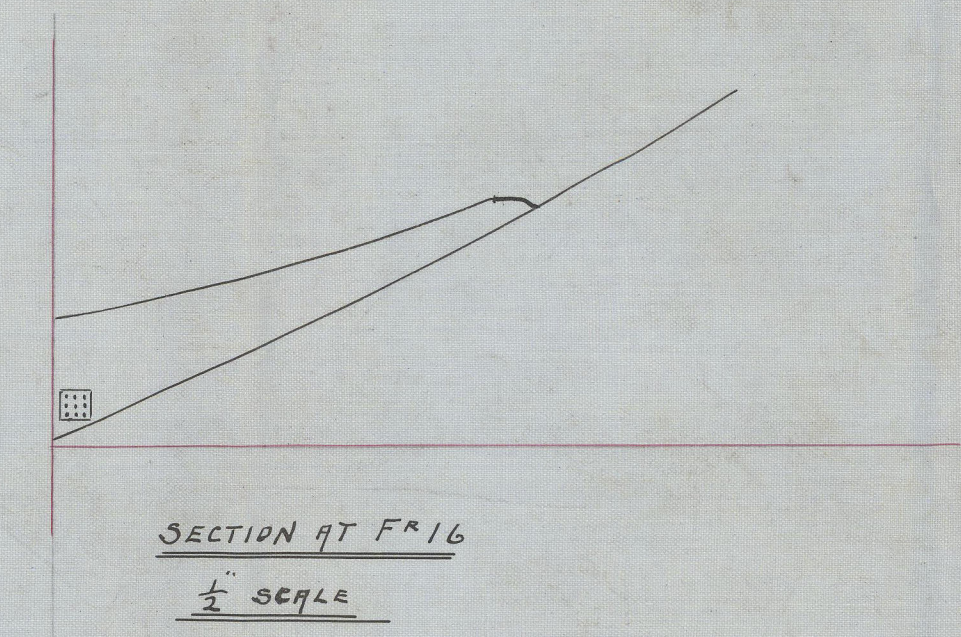


002127-002131-0018

APPROVED
27 NOV 1900
CLASS
BY

Approved
in letter 6.12.6
34

IF HOLE
EXPOSED IN

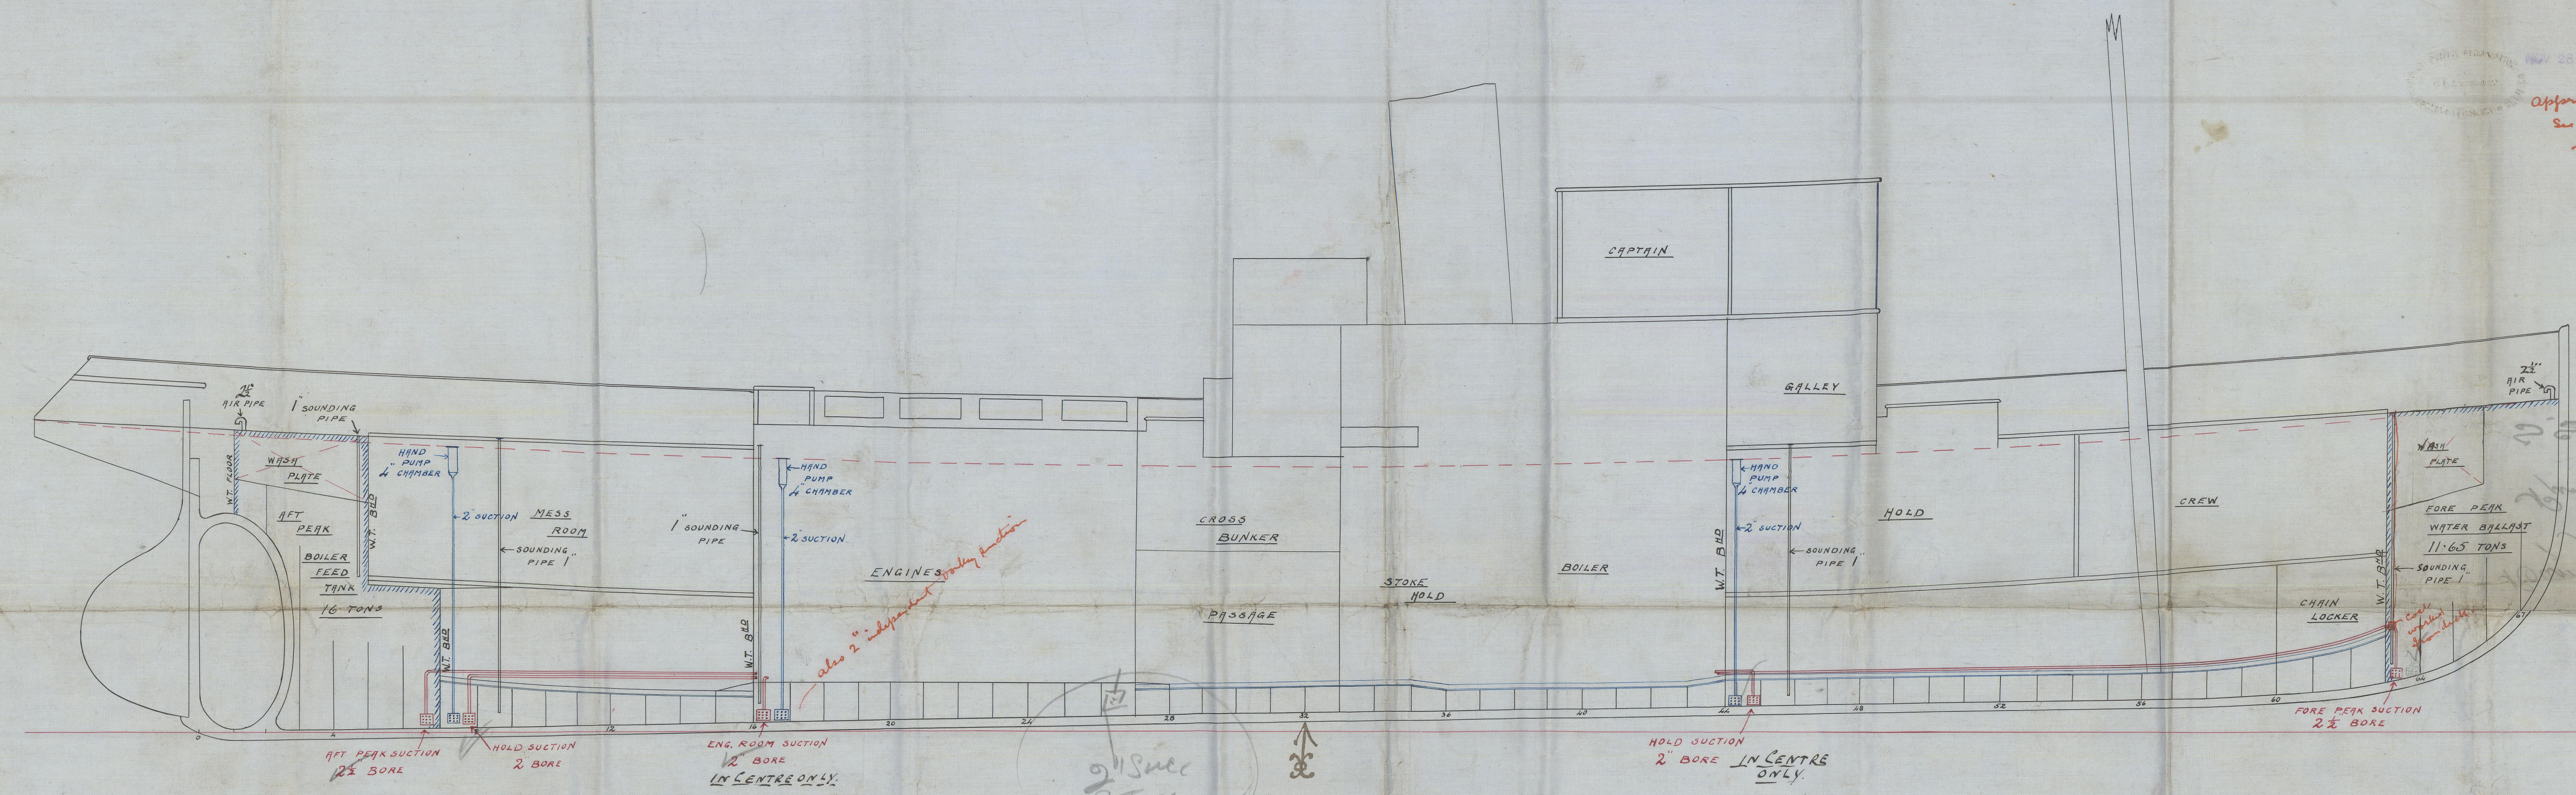

PUMPING PLAN.
S.S. N° 210.
SCALE $\frac{1}{2}$ " = 1 FOOT.
LENGTH. 120'-0" B.P.
UNDER 750 TONS.

27 NOV 1900
L.B.T.

002127-002131-0018

Ramage Ferguson's
No. 210

Pumping Plan

S.S. Terauchi

TRANSFERRED TO:
L. R. SYSTEM

W. A. R. C. 1-10-18
Obtaining



© 2020

Lloyd's Register
Foundation

002127-002137-0018