


—PROFILE FOR S.S. N^o 305.— TO CLASS LLOYD 100.A.101. [WITH SHELTERDECK]

— BUILT OF OF STEEL.

NOTE. TUBE PILLARS OF MANNESMANN WELDLESS ROLLED TUBES (STEEL) HAVING A TENSILE STRENGTH OF NOT LESS THAN 35 TON PR SQ INCH.


Note: angles on face of frames at panting string etc
- PANTING STR NO. 1 - may be dispensed with

 

AKTIEGELØSBKABET
BURMESTER & WAINES
MASKIN- & SKIDRYGGERI.

BYGNING NR. 305
FØDNING NR. B. 4
FØDNING AR. } 84.
KALDERY AR. }
BEFØRNING AR. }
DATO. 11/1. 15.
SKALA. '8" x 1/4" = 1" *W*
Profile

Biermeister & Wain's, Cphn.
Newbuilding No 305.
% NORDLYS Cphn 5200.
Longitudinal Sect. & Decks.

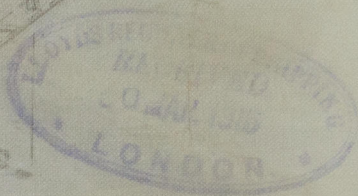

© 2020

Lloyd's Register
Foundation

002127-002137-0036